




WAN	
CIRCUIT ID	KXIP600363
IP ADDRESS	10.227.134.1

All Equipment tags to be prefixed with "ACT-"

"PLATFORM 1A HP ISDN"
01-344-874803
"PLATFORM 1B/2 HP ISDN"
01-344-874236
"PLATFORM 3 HP ISDN"
01-344-874109

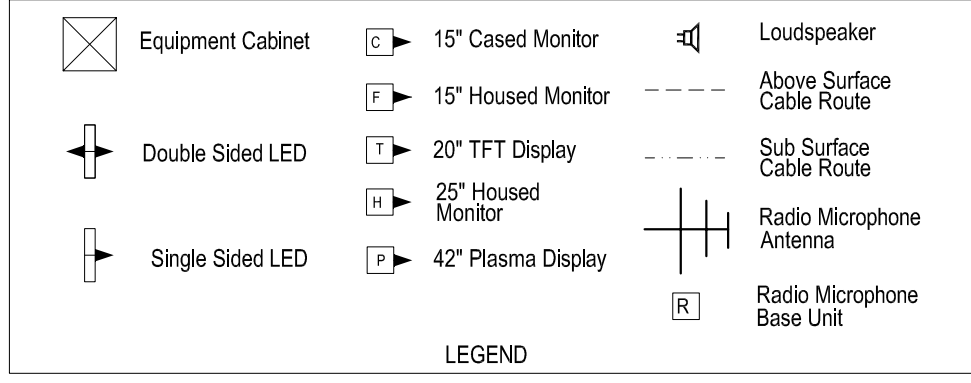

Equipment	Dist Board	
CIS RACK	IN EQUIP ROOM	CCT 4
TOF-CIDU-001	GP1 - 1	CCT 1
DSPI-001	GP1 - 2	CCT 12

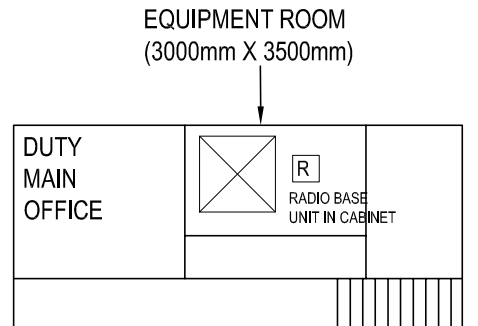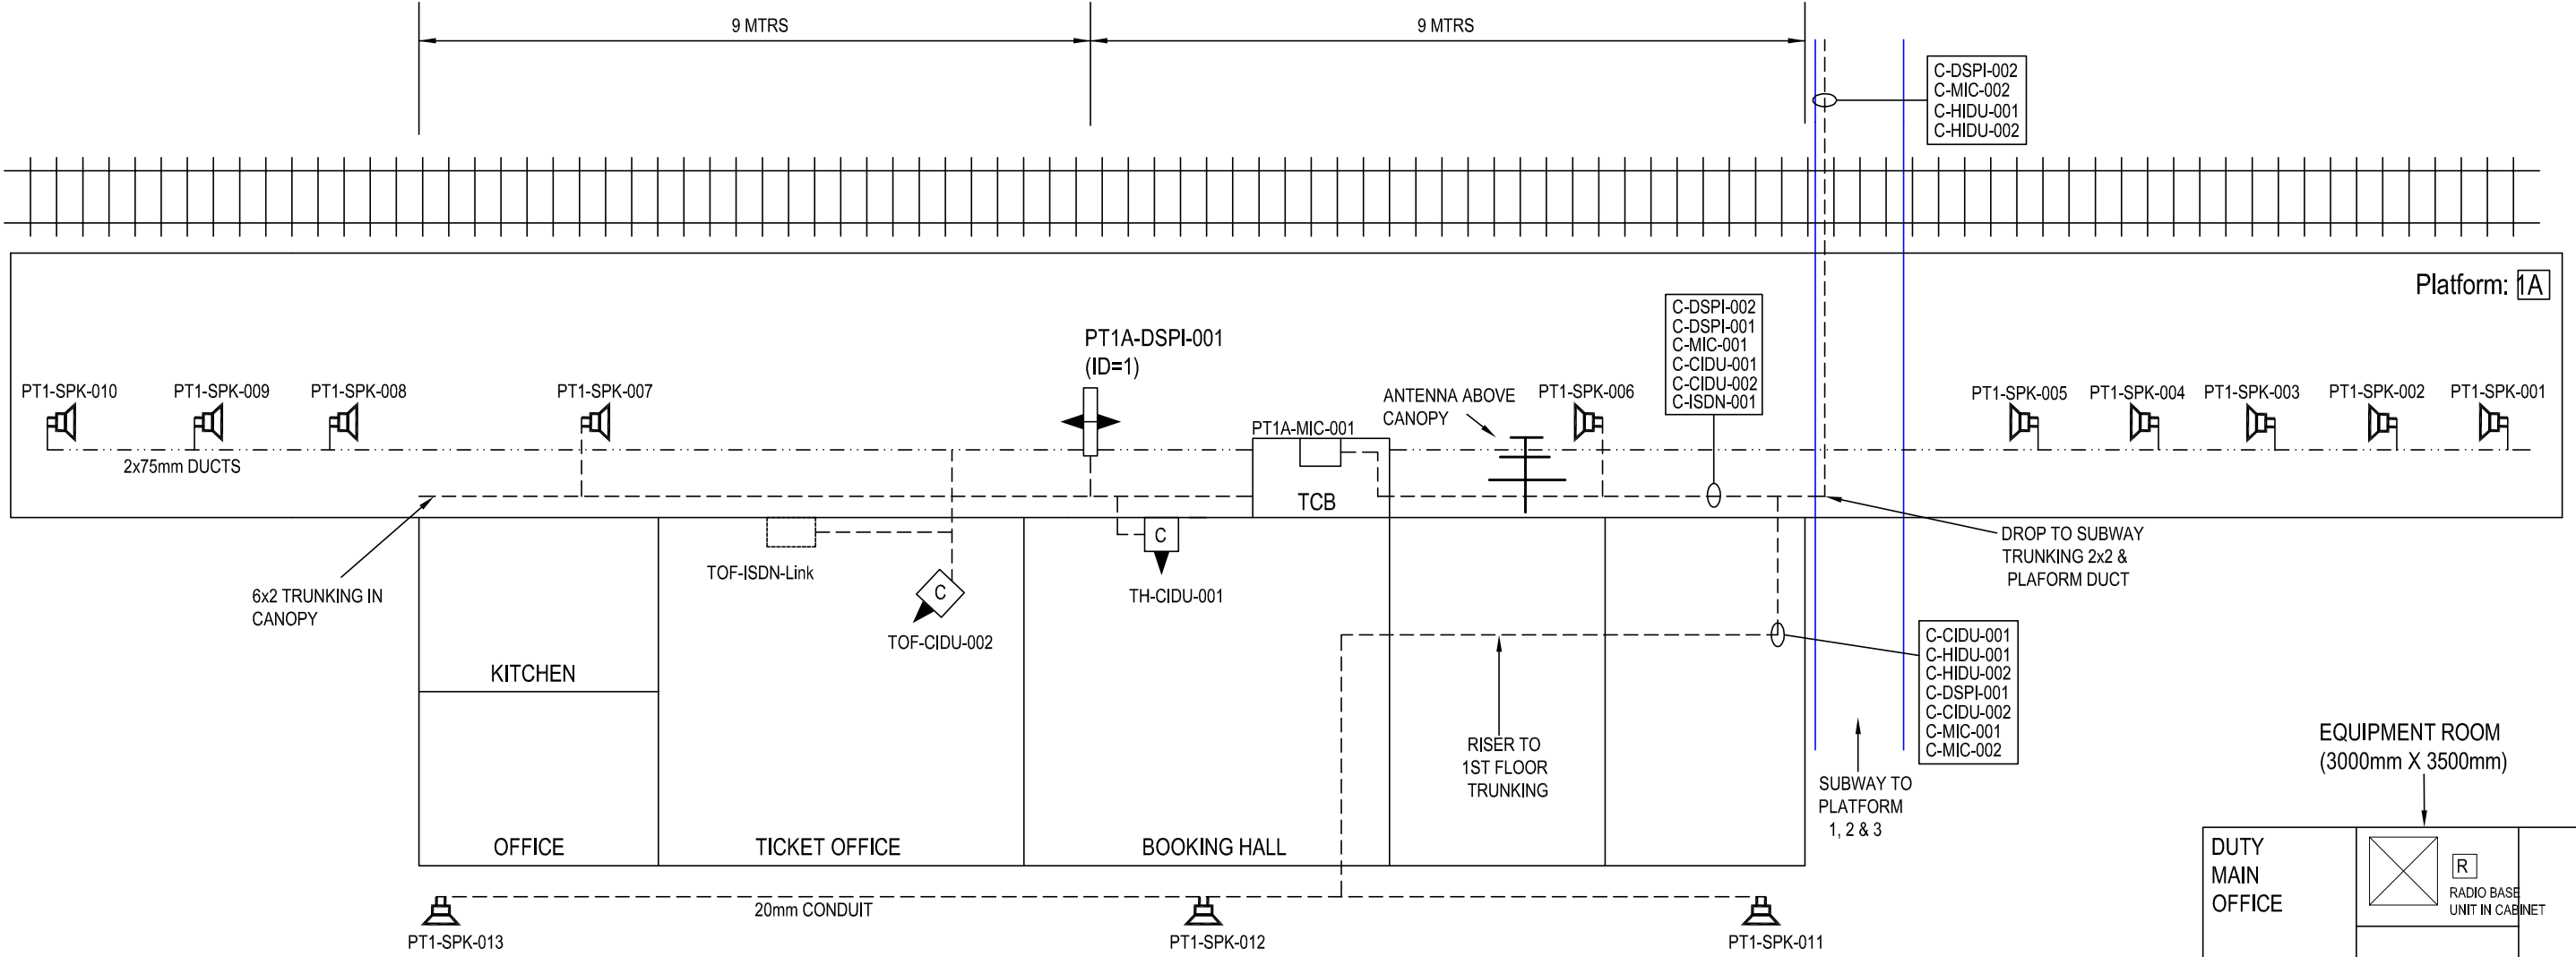

1ST FLOOR PLAN


IF IN DOUBT ASK!

MATERIAL	CONSTRUCTION	NAME	SIGNATURE	DATE	<p>AMEY DATEL Project Offices 1st Floor, Platform 2/3 Eastleigh Station Southampton Road Eastleigh Hants SO50 9FL</p>	SITE/PROJECT		
		DRAWN BY: D GADDU		23-01-2002		SOUTH WEST TRAINS CIS PROJECT		
FINISH	CONSTRUCTION	CHECKED BY: T WONG			<p>COPYRIGHT © AMEY Rail All rights reserved. Neither this drawing or any of the information it contains may be copied or communicated to third parties without the written permission of the copyright holder</p>	TITLE		
		APPD BY: A SMITH				ASCOT AS BUILT		
		CAD Ref:			SCALE: NTS	DRG No. SM803-75666	ISSUE: B	SHEET: 1 of 3
		CONTRACTOR'S Ref:						


WAN	
CIRCUIT ID	KXIP600363
IP ADDRESS	10.227.134.1

All Equipment tags to be prefixed with "ACT-"

"PLATFORM 1A HP ISDN"
01-344-874803
"PLATFORM 1B/2 HP ISDN"
01-344-874236
"PLATFORM 3 HP ISDN"
01-344-874109

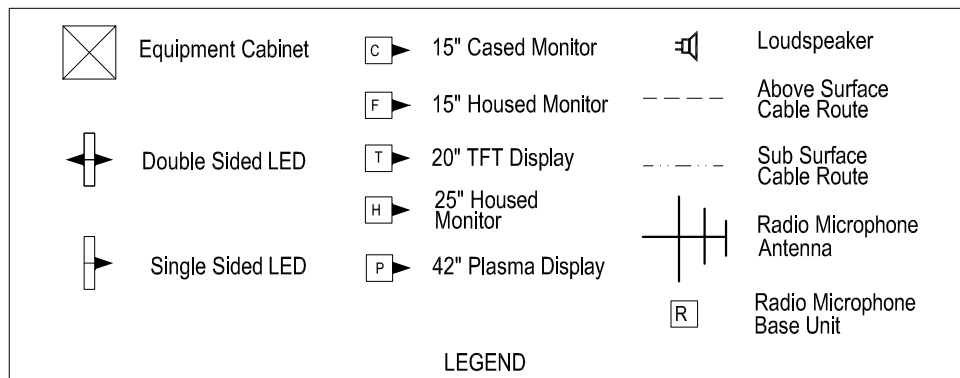

Equipment	Dist Board	
PT1B-HIDU-001	GP 2	CCT 10
PT1B-DSPI-002	GP 2	CCT 3
PT2-DSPI-003	GP 2	CCT 3

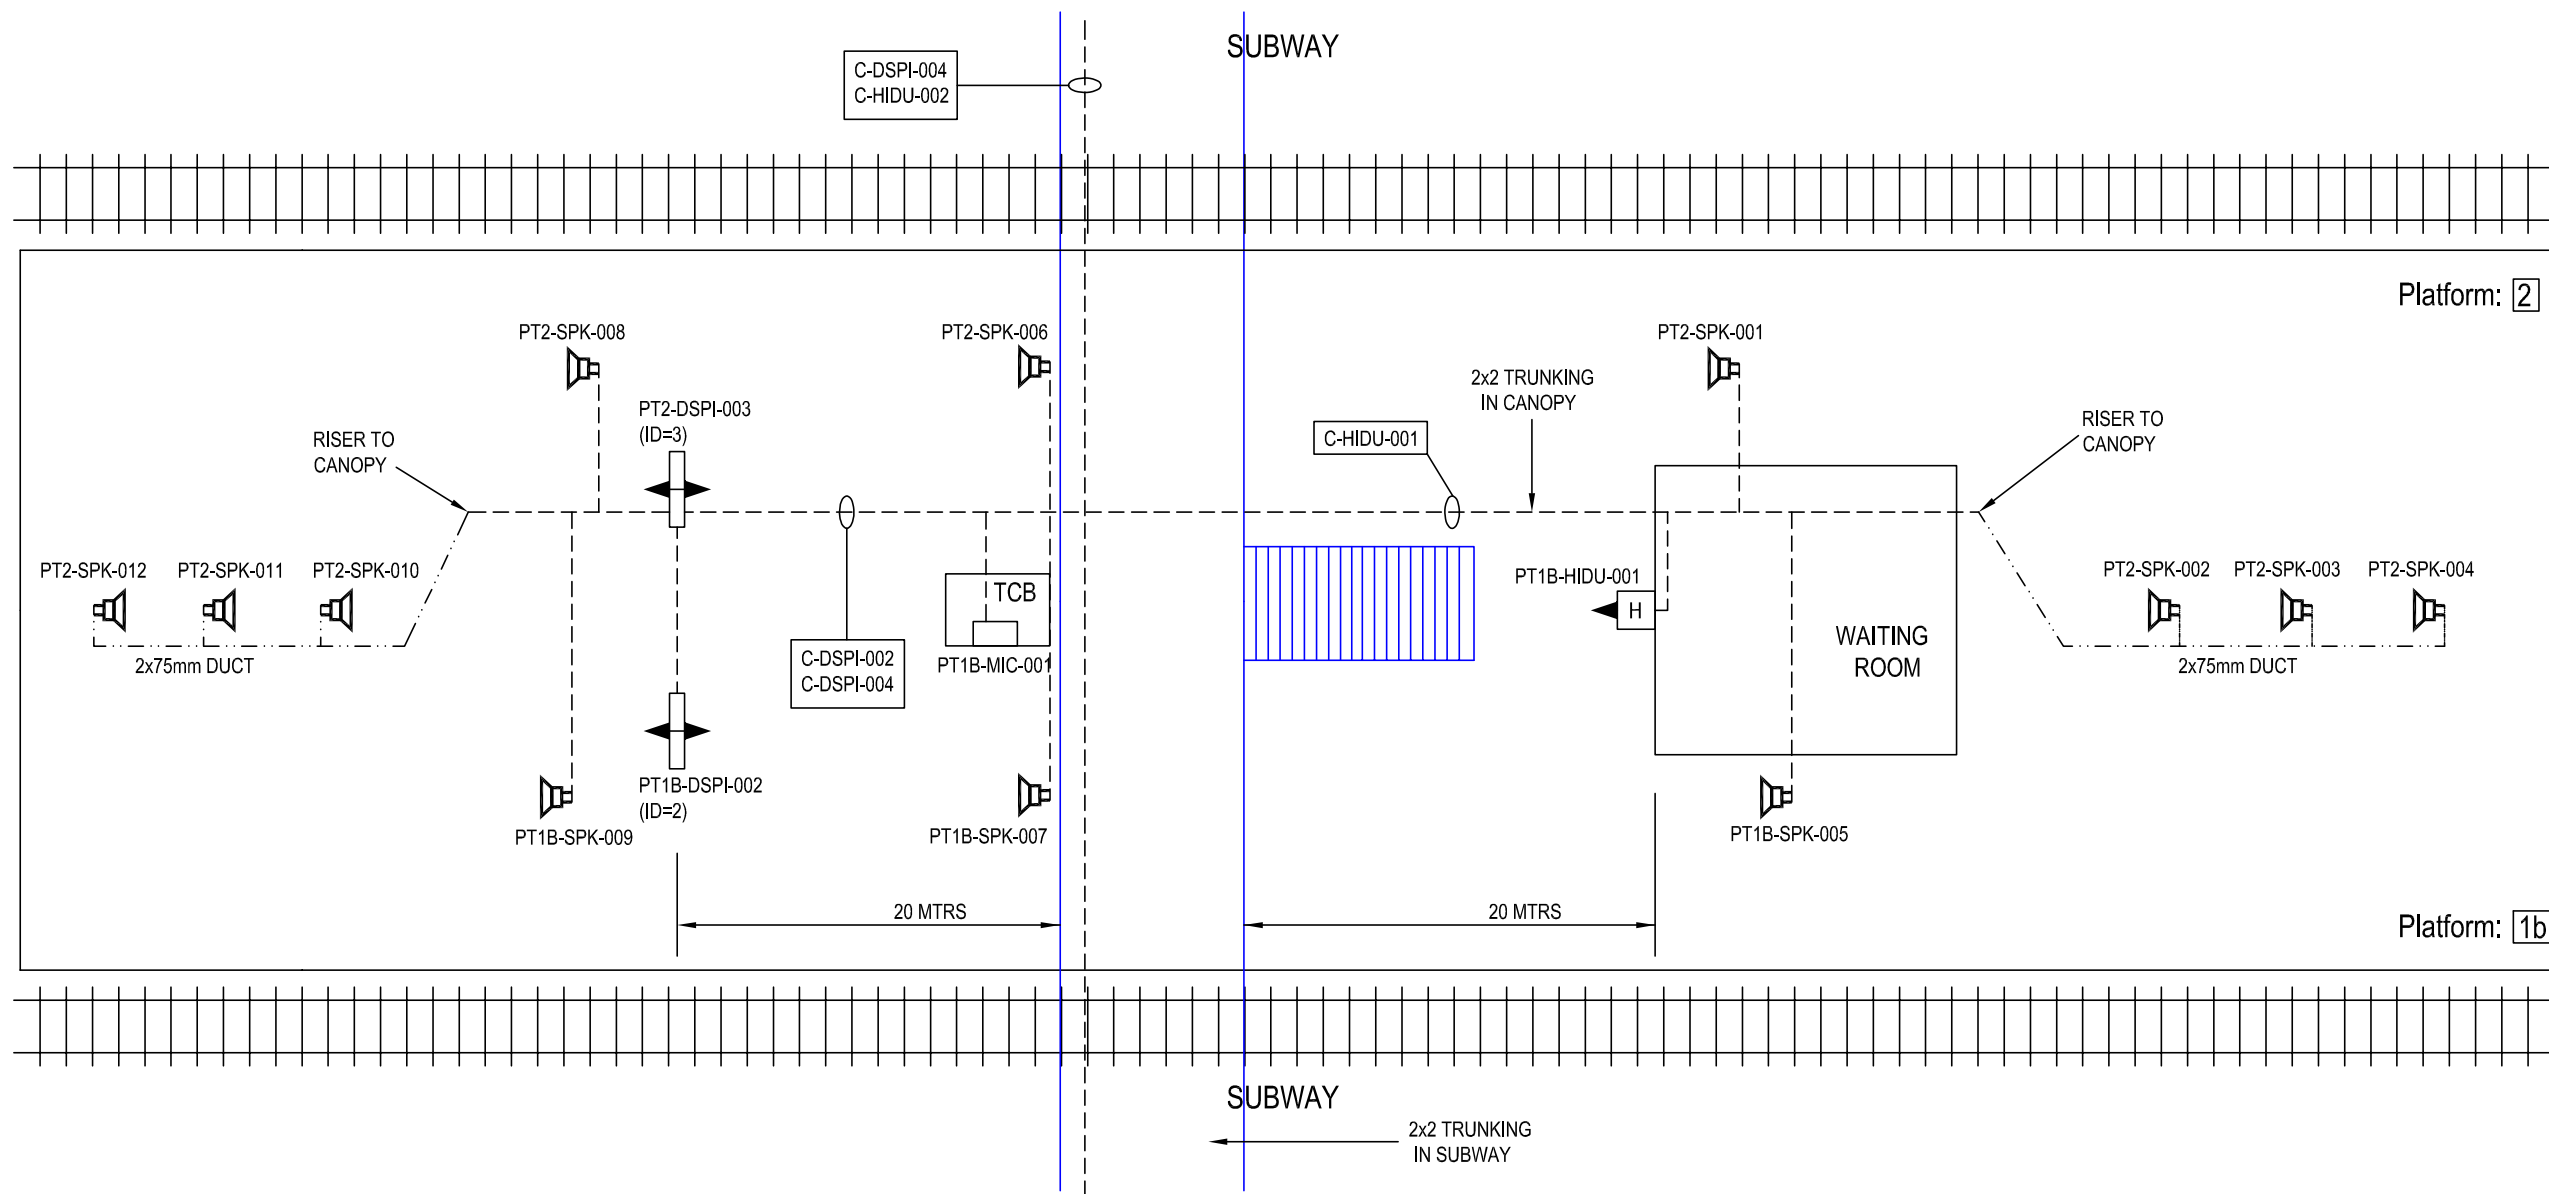

IF IN DOUBT ASK!


MATERIAL	CONSTRUCTION	NAME	SIGNATURE	DATE	 AMEY DATEL Project Offices 1st Floor, Platform 2/3 Eastleigh Station Southampton Road Eastleigh Hants SO50 9FL	SITE/PROJECT	
		DRAWN BY	D GADDU	23-01-2002		SOUTH WEST TRAINS CIS PROJECT	
FINISH	CONSTRUCTION	CHECKED BY	T WONG		TITLE ASCOT AS BUILT	SCALE	DRG No.
		APPD BY	A SMITH				
		APPD BY			COPYRIGHT © AMEY Rail All rights reserved. Neither this drawing or any of the information it contains may copied or communicated to third parties without the written permission of the copyright holder	ISSUE	SHEET
		CAD Ref:				B	2 of 3
		CONTRACTOR'S Ref:					

SM803-75666


WAN	
CIRCUIT ID	KXIP600363
IP ADDRESS	10.227.134.1

"PLATFORM 1A HP ISDN"
01-344-874803
"PLATFORM 1B/2 HP ISDN"
01-344-874236
"PLATFORM 3 HP ISDN"
01-344-874109

All Equipment tags to be prefixed with "ACT-"

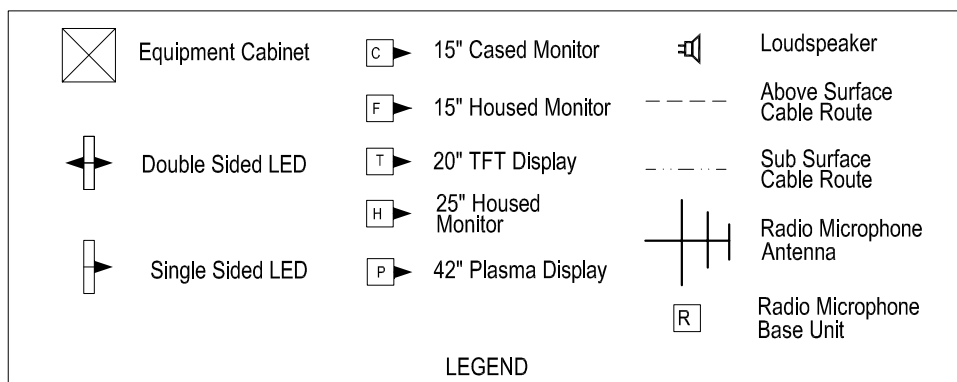

Equipment	Dist Board	
PT3-DSPI-004	IN WAITING ROOM	EXISTING CLOCK CIRCUITS USED
PT3-HIDU-002		

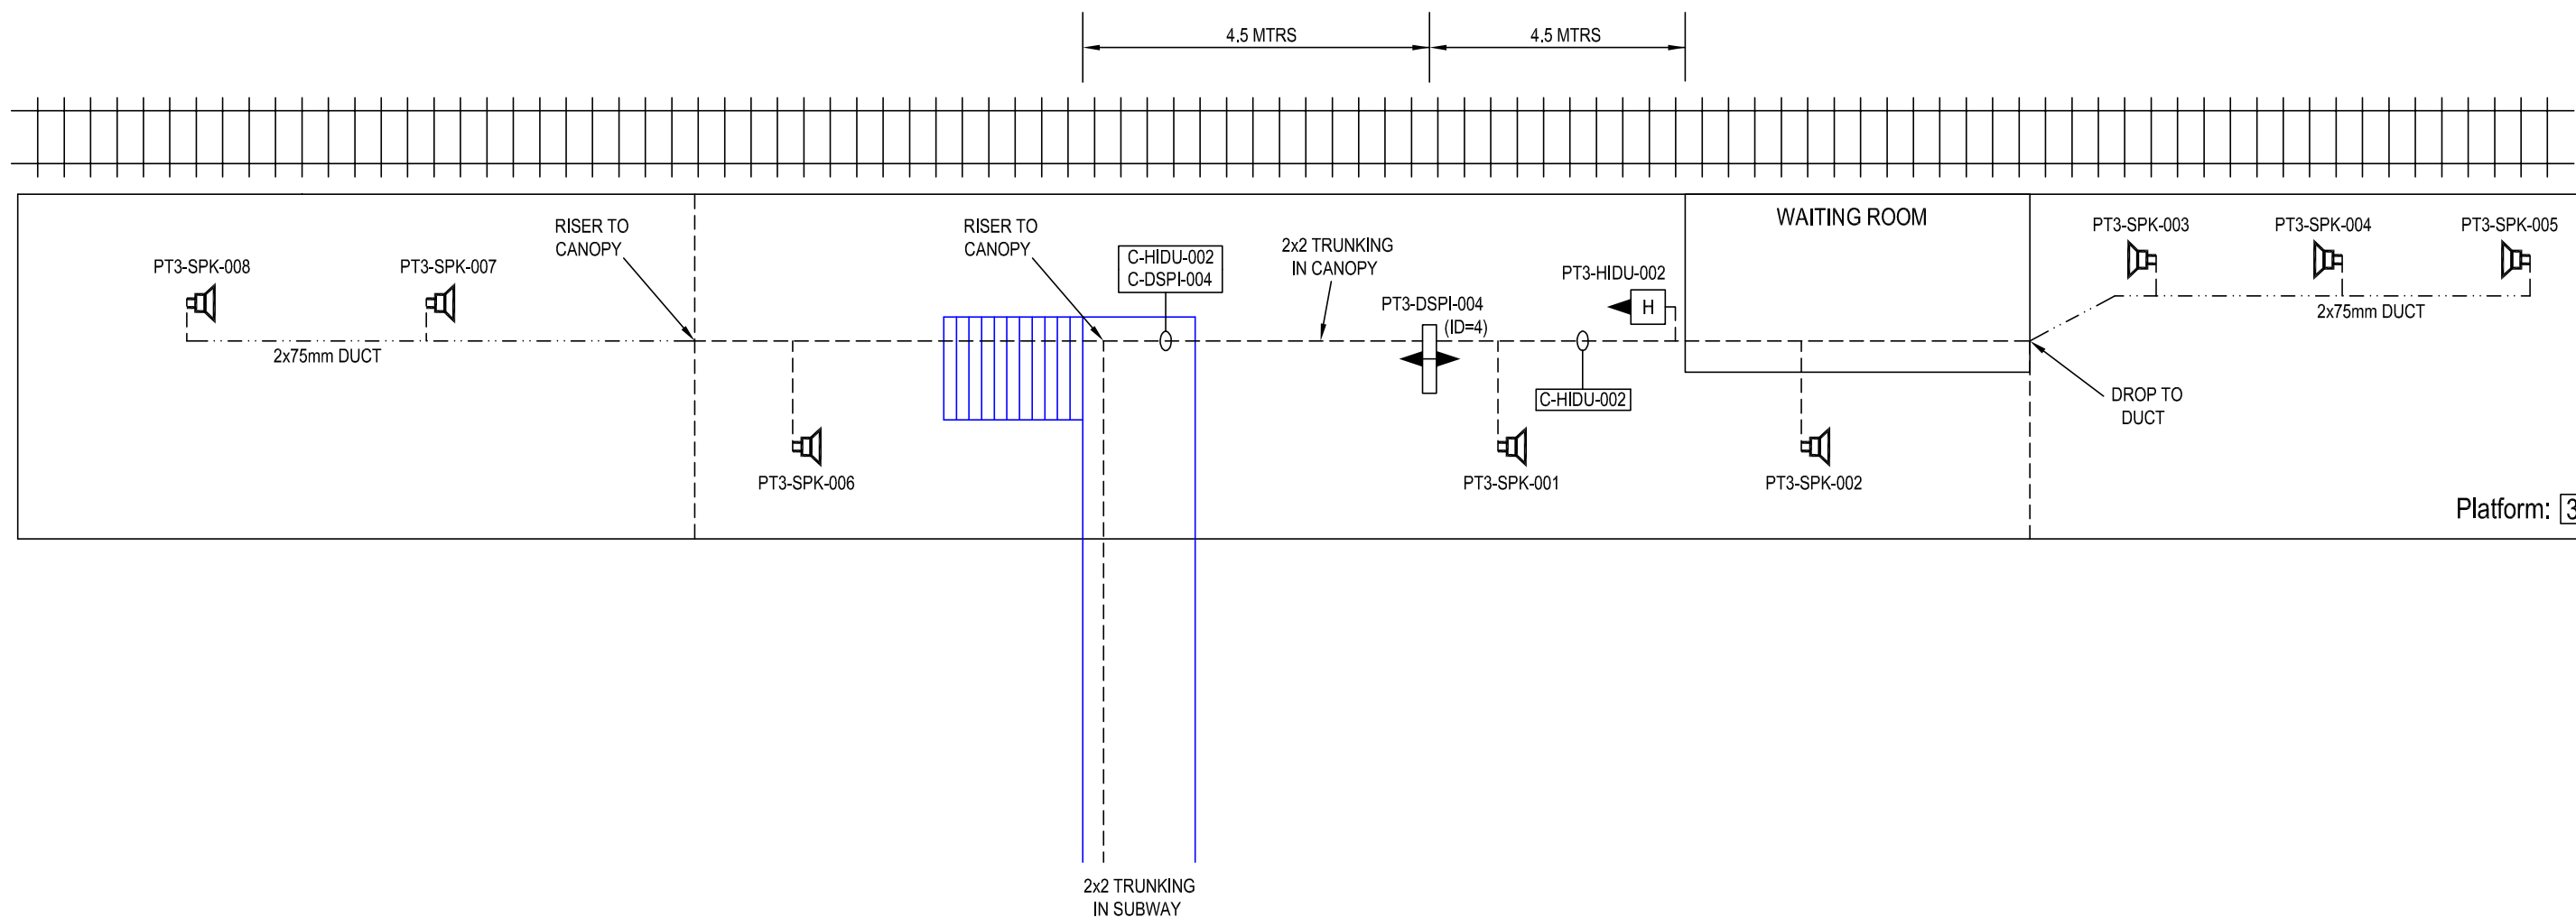

IF IN DOUBT ASK!

MATERIAL	CONSTRUCTION	<table border="1"> <tr> <th>NAME</th> <th>SIGNATURE</th> <th>DATE</th> </tr> <tr> <td>D GADDU</td> <td></td> <td>23-01-2002</td> </tr> <tr> <td>T WONG</td> <td></td> <td></td> </tr> <tr> <td>A SMITH</td> <td></td> <td></td> </tr> </table>	NAME	SIGNATURE	DATE	D GADDU		23-01-2002	T WONG			A SMITH			<p>AMEY DATEL Project Offices 1st Floor, Platform 2/3 Eastleigh Station Southampton Road Eastleigh Hants SO50 9FL</p>	SITE/PROJECT SOUTH WEST TRAINS CIS PROJECT	
		NAME	SIGNATURE	DATE													
D GADDU		23-01-2002															
T WONG																	
A SMITH																	
FINISH		<p>COPYRIGHT © AMEY Rail All rights reserved. Neither this drawing or any of the information it contains may be copied or communicated to third parties without the written permission of the copyright holder</p>	TITLE ASCOT AS BUILT														
		CAD Ref:		SCALE NTS	DRG No. SM803-75666												
		CONTRACTOR'S Ref:		ISSUE B	SHEET 3 of 3												