


DRG No. SM803-75667


WAN	
CIRCUIT ID	KXIP600365
IP ADDRESS	10.227.92.1

"PLATFORM 1 HP ISDN"
01-784-421862
"PLATFORM 2 HP ISDN"
01-784-423789

All Equipment tags to be prefixed with "ASF-"

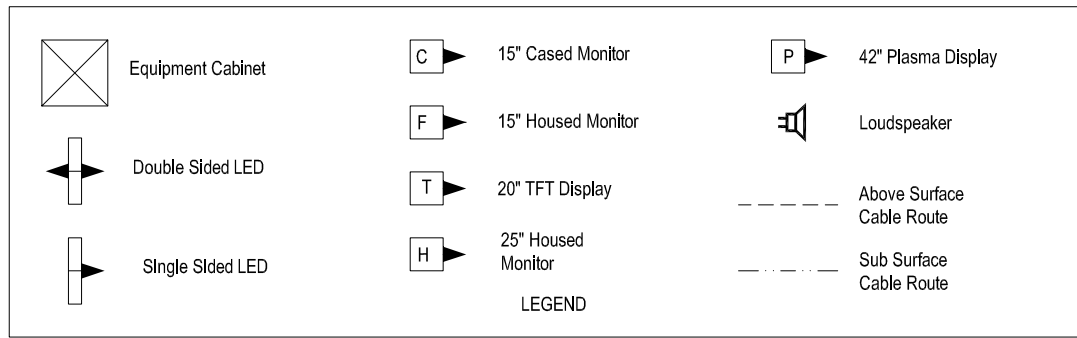

Equipment	Dist Board
EXISTING CIRCUITS USED. CIRCUITS NOT LABELED	

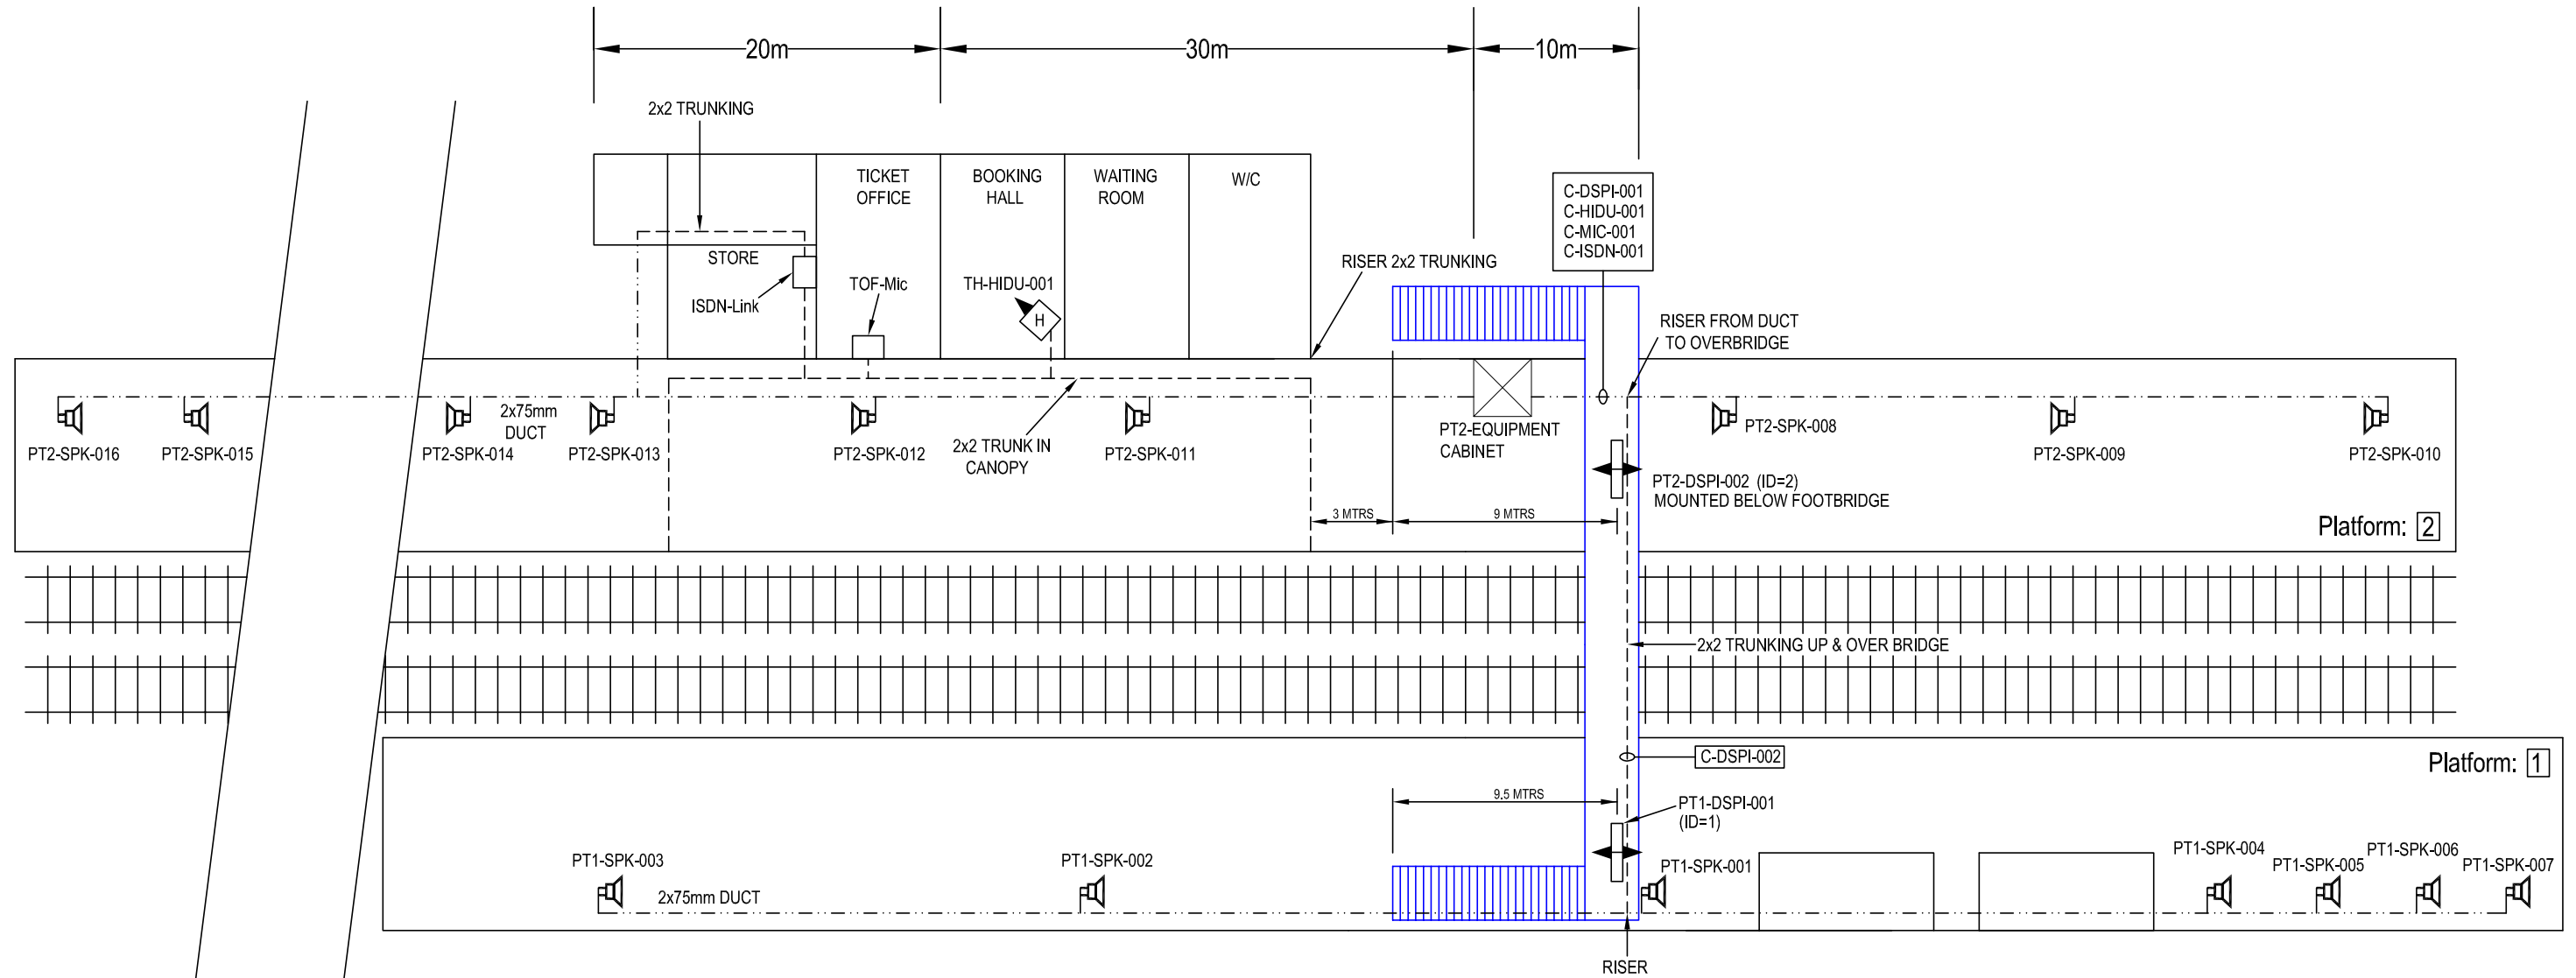

IF IN DOUBT ASK!

MATERIAL	CONSTRUCTION	NAME	SIGNATURE	DATE	<p>AMEY DATEL Project Offices 1st Floor, Platform 2/3 Eastleigh Station Southampton Road Eastleigh Hants SO50 9FL</p>	SITE/PROJECT		
		DRAWN BY	D GADDU	28-01-2002		SOUTH WEST TRAINS CIS PROJECT		
FINISH	CONSTRUCTION	CHECKED BY	T WONG		<p>COPYRIGHT © AMEY Rail All rights reserved. Neither this drawing or any of the information it contains may be copied or communicated to third parties without the written permission of the copyright holder</p>	TITLE		
		APPD BY	A SMITH			ASHFORD AS BUILT		
		CAD Ref:			SCALE	DRG No.	ISSUE	SHEET
		CONTRACTOR'S Ref:			NTS	SM803-75667	B	1 of 1