


DRG No.

SM803-75547


WAN	
CIRCUIT ID	KXIP 600367
IP ADDRESS	10.227.93.1

"PLATFORM 1 HP ISDN"	01252-342517
"PLATFORM 2 HP ISDN"	01252-342518


All Equipment tags to be prefixed with "AHV-"

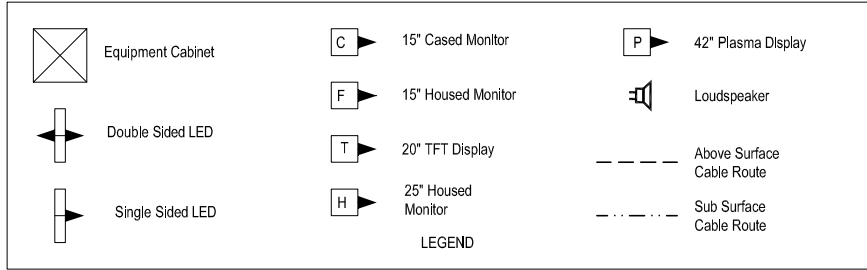

Equipment	Dist Board
PT2-DSPI-002	GP3 CCT6
CIS RACK	GP3 CCT3
PT1-DSPI-001	GP1 CCT10
TH-FIDU-001	GP1 CCT23
CHO-CIDU-001	EXISTING SPUR

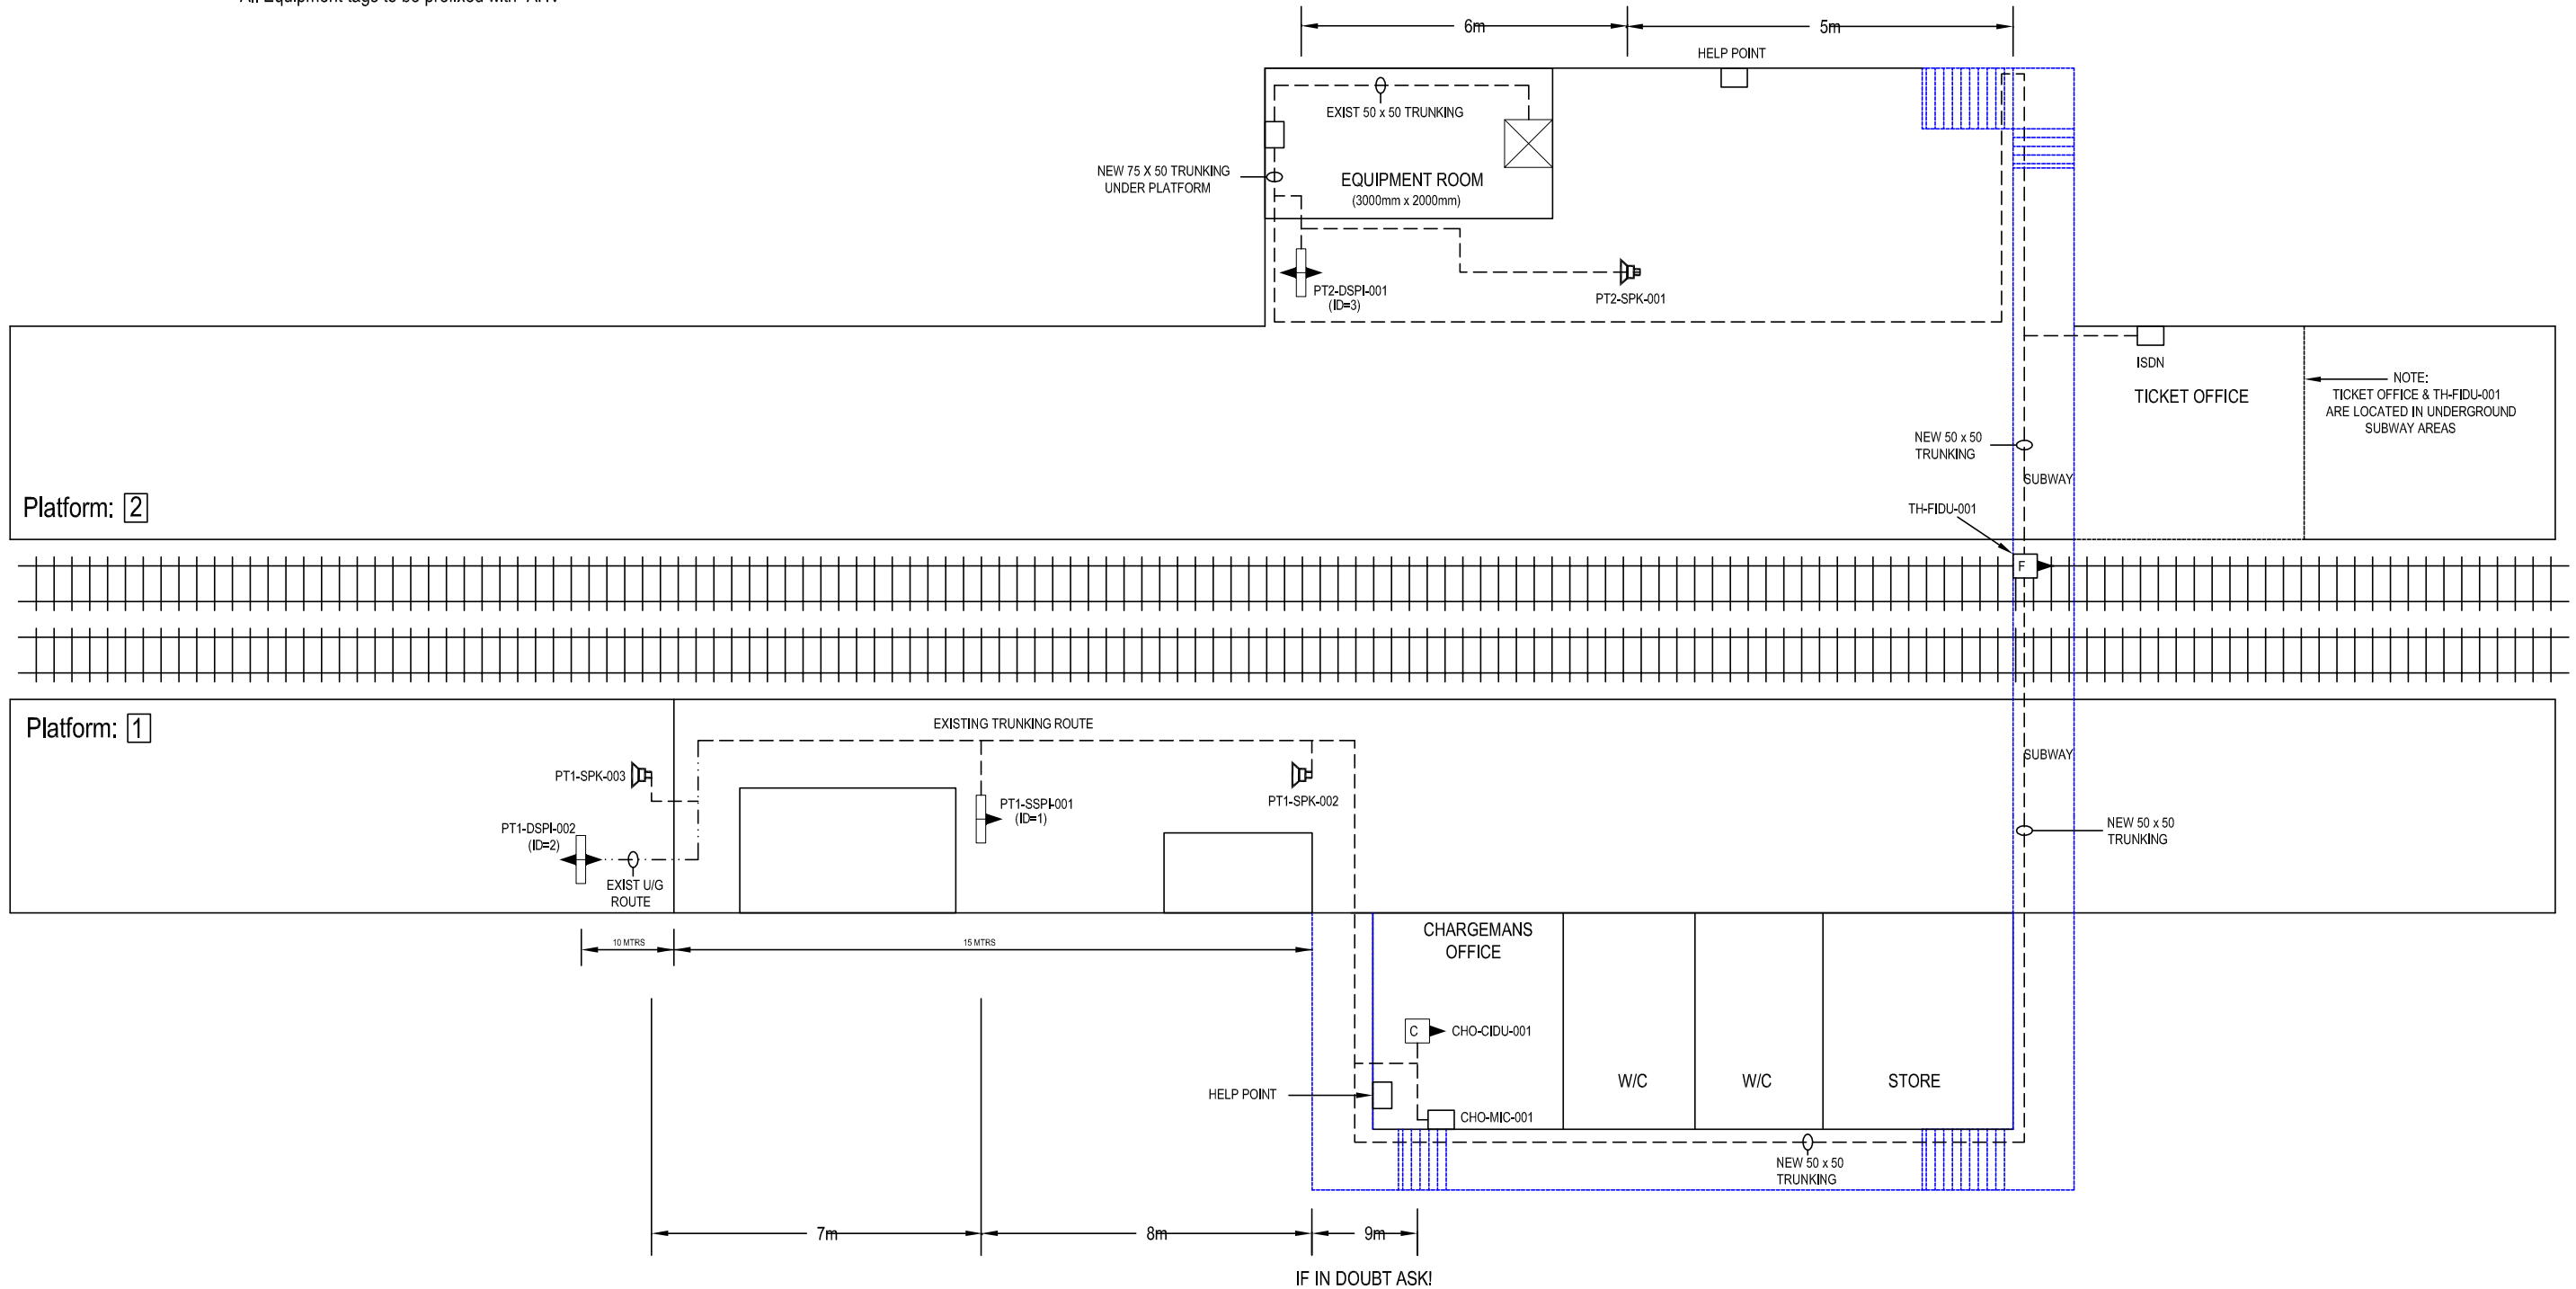

MATERIAL	CONSTRUCTION	NAME	SIGNATURE	DATE
		DRAWN BY	D GADDU	10-05-2002
FINISH		CHECKED BY	T WONG	
		APPD BY	A SMITH	
		APPD BY		
		CAD Ref:		
		CONTRACTOR'S Ref:		



AMEY DATEL Project  
 Offices  
 1st Floor, Platform  
 2/3  
 Eastleigh Station  
 Southampton Road  
 Eastleigh  
 Hants  
 SO50 9FL

COPYRIGHT © AMEY Rail  
 All rights reserved. Neither this drawing or any of the information it contains may be copied or communicated to third parties without the written permission of the copyright holder

SITE/PROJECT		SOUTH WEST TRAINS CIS PROJECT	
TITLE		ASH VALE AS BUILT	
SCALE	DRG No.	ISSUE	SHEET
NTS	SM803-75547	B	1 of 1