


DRG No. SM803-75906


WAN	
CIRCUIT ID	KXIP 600366
IP ADDRESS	10.227.91.1

"PLATFORM 1 HP ISDN"
02380-293851
"PLATFORM 2 HP ISDN"
02380-293852

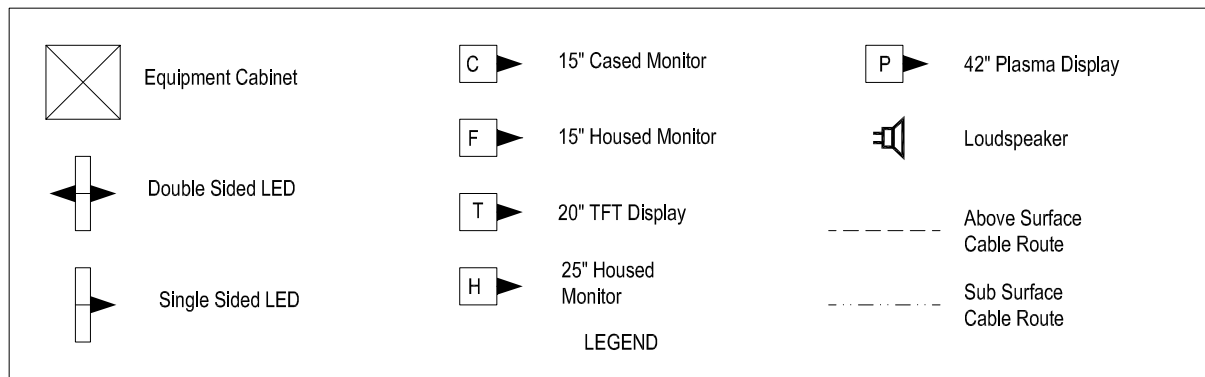

Equipment	Dist Board
CIS RACK	CCT 1
HEATER	CCT 2
13 AMP TWIN SOCKET	CCT 3
THERMOSTAT & FAN	CCT 4
LED PLATFORM 2	CCT 5
LED PLATFORM 1	CCT 6

All Equipment tags to be prefixed with "LYN-"

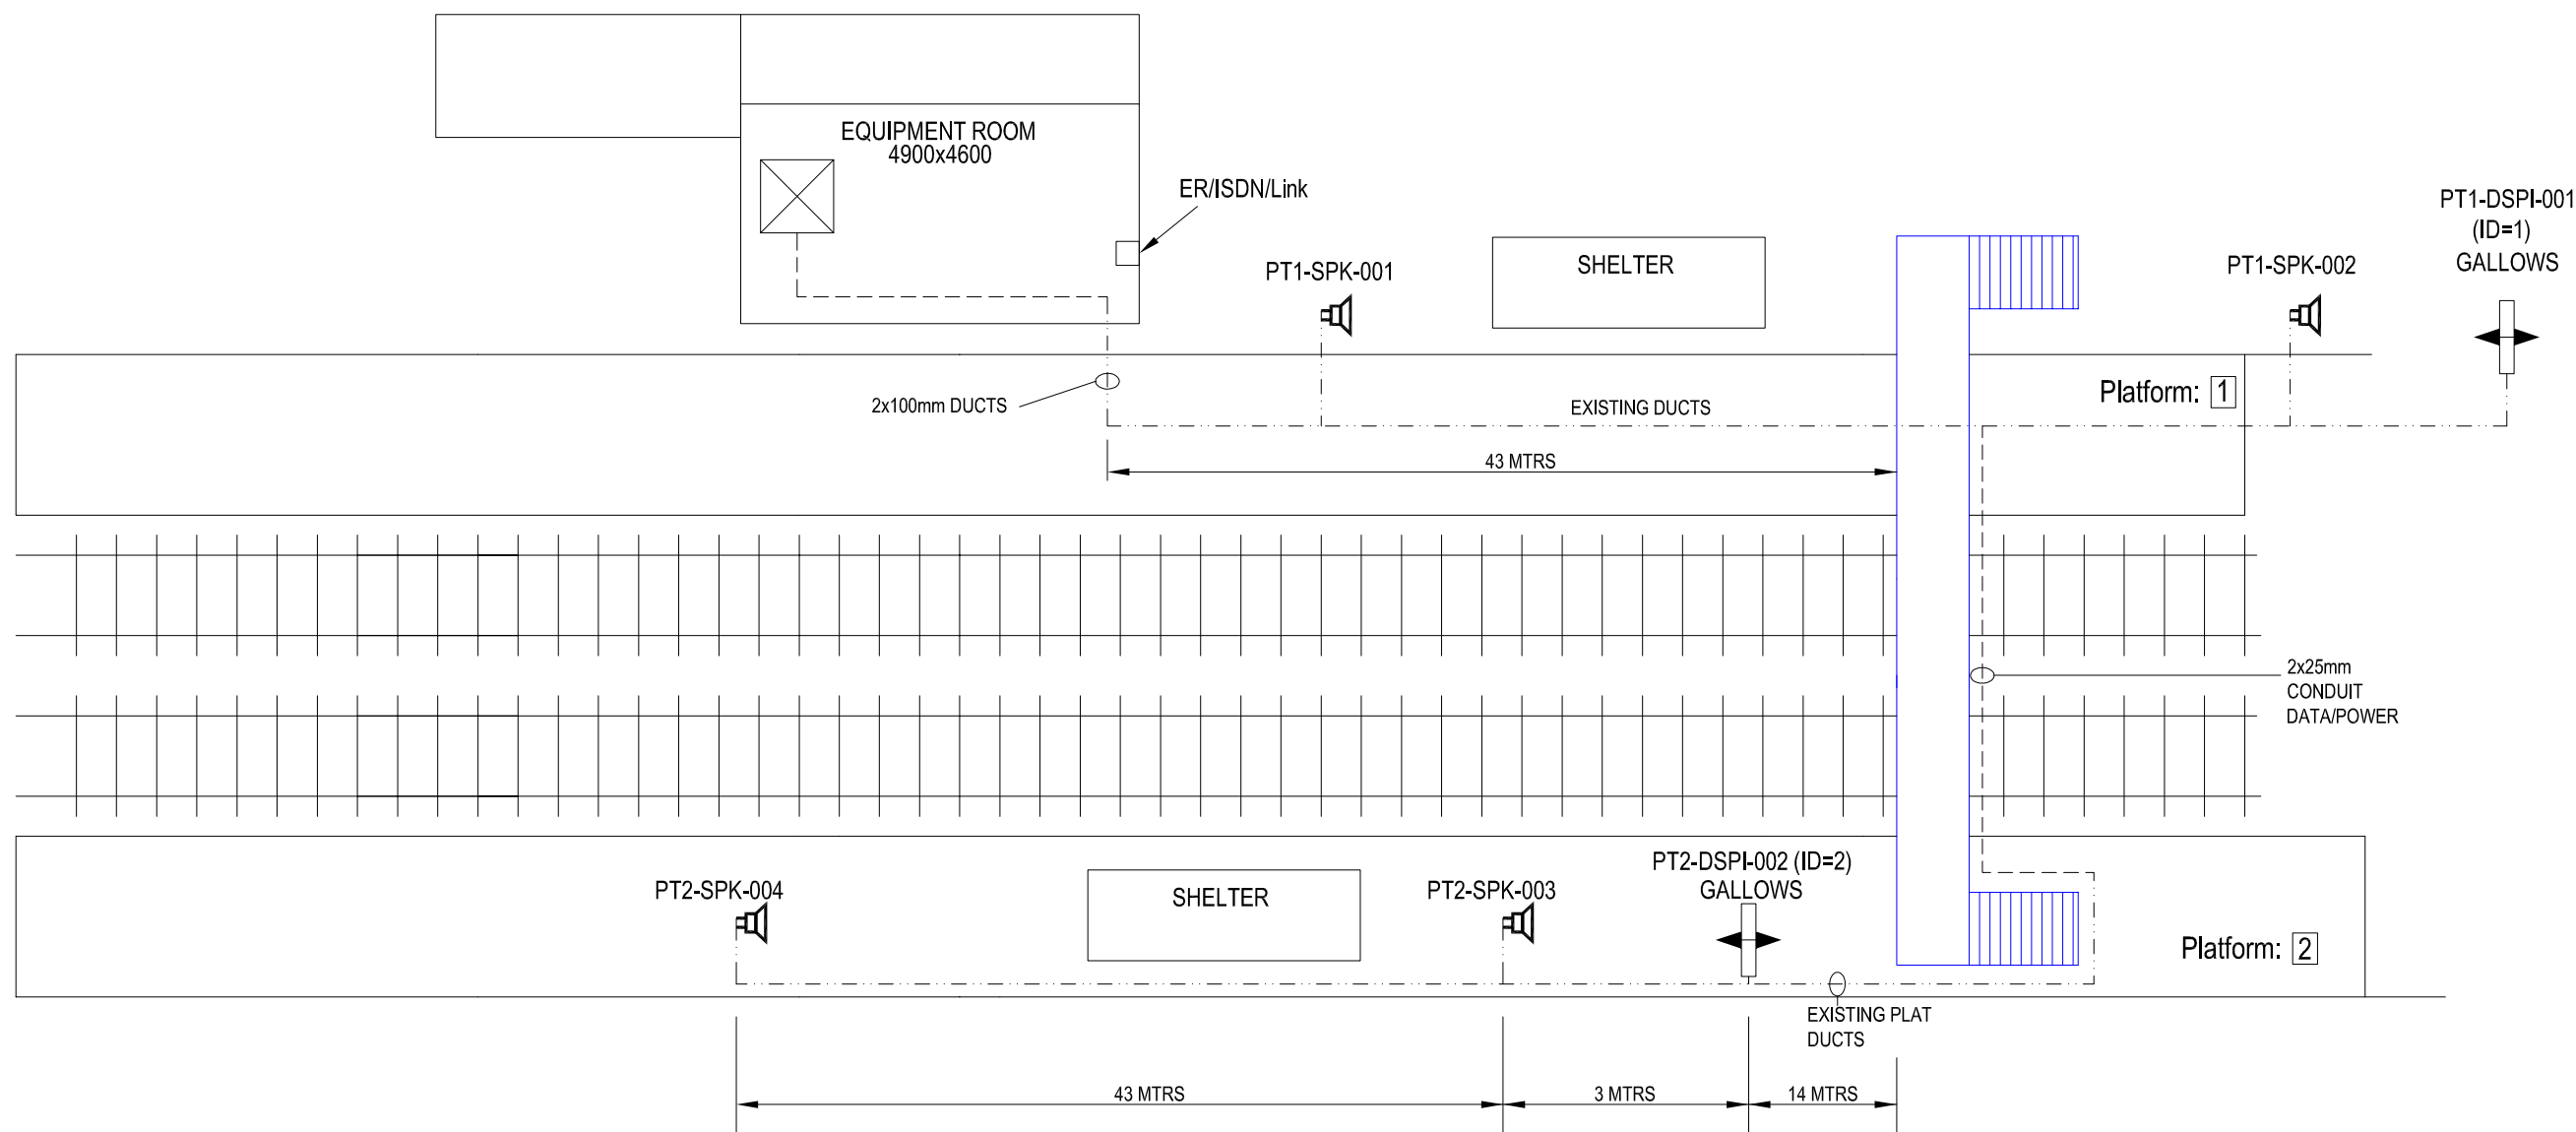

IF IN DOUBT ASK!

MATERIAL	CONSTRUCTION	NAME	SIGNATURE	DATE
		D GADDU		25-02-2002
		T WONG		
FINISH				

AMEY DATEL Project
 Offices
 1st Floor, Platform
 2/3
 Eastleigh Station
 Southampton Road
 Eastleigh
 Hants
 SO50 9FL

COPYRIGHT © AMEY Rail
 All rights reserved. Neither this drawing or any of the information it contains may be copied or communicated to third parties without the written permission of the copyright holder

SITE/PROJECT		SOUTH WEST TRAINS CIS PROJECT	
TITLE		ASHURST NEW FOREST AS BUILT	
SCALE	DRG No.	ISSUE	SHEET
NTS	SM803-75906	B	1 of 1