


DRG No.

SM803-75544

WAN	
CIRCUIT ID	KXIP 600361
IP ADDRESS	10.22.7.98.1


"PLATFORM 1 HP ISDN"
01420-543057

All Equipment tags to be prefixed with "AON-"

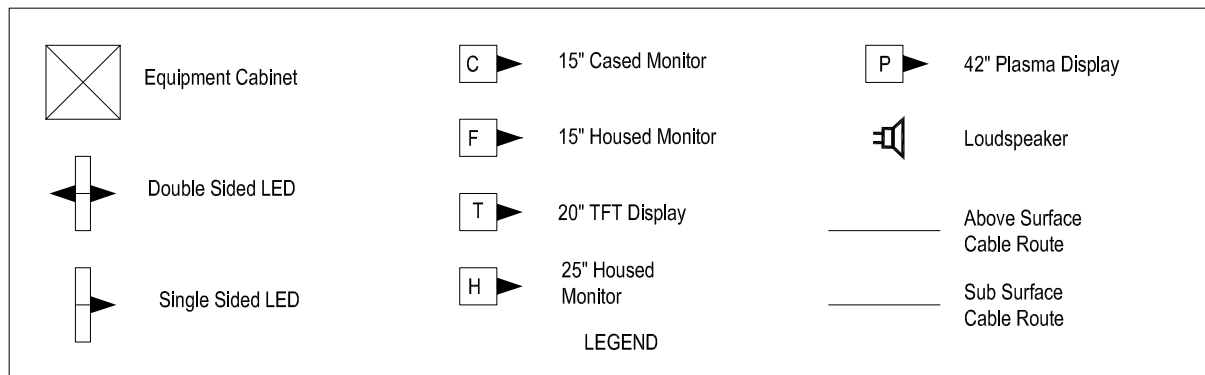


Equipment	Dist Board	
CIS CABINET	LTG/POWER/1	WAY 24
PLAT 1 LED	?	?
PLAT 2 LED	LTG/POWER/1	WAY 48
MONITOR B/H	?	?

NOTE: SERCO ELECTRICAL HAVE RE-WIRED THE STATION AND HAVE NOT MARKED UP ABOVE ? EQUIPMENT

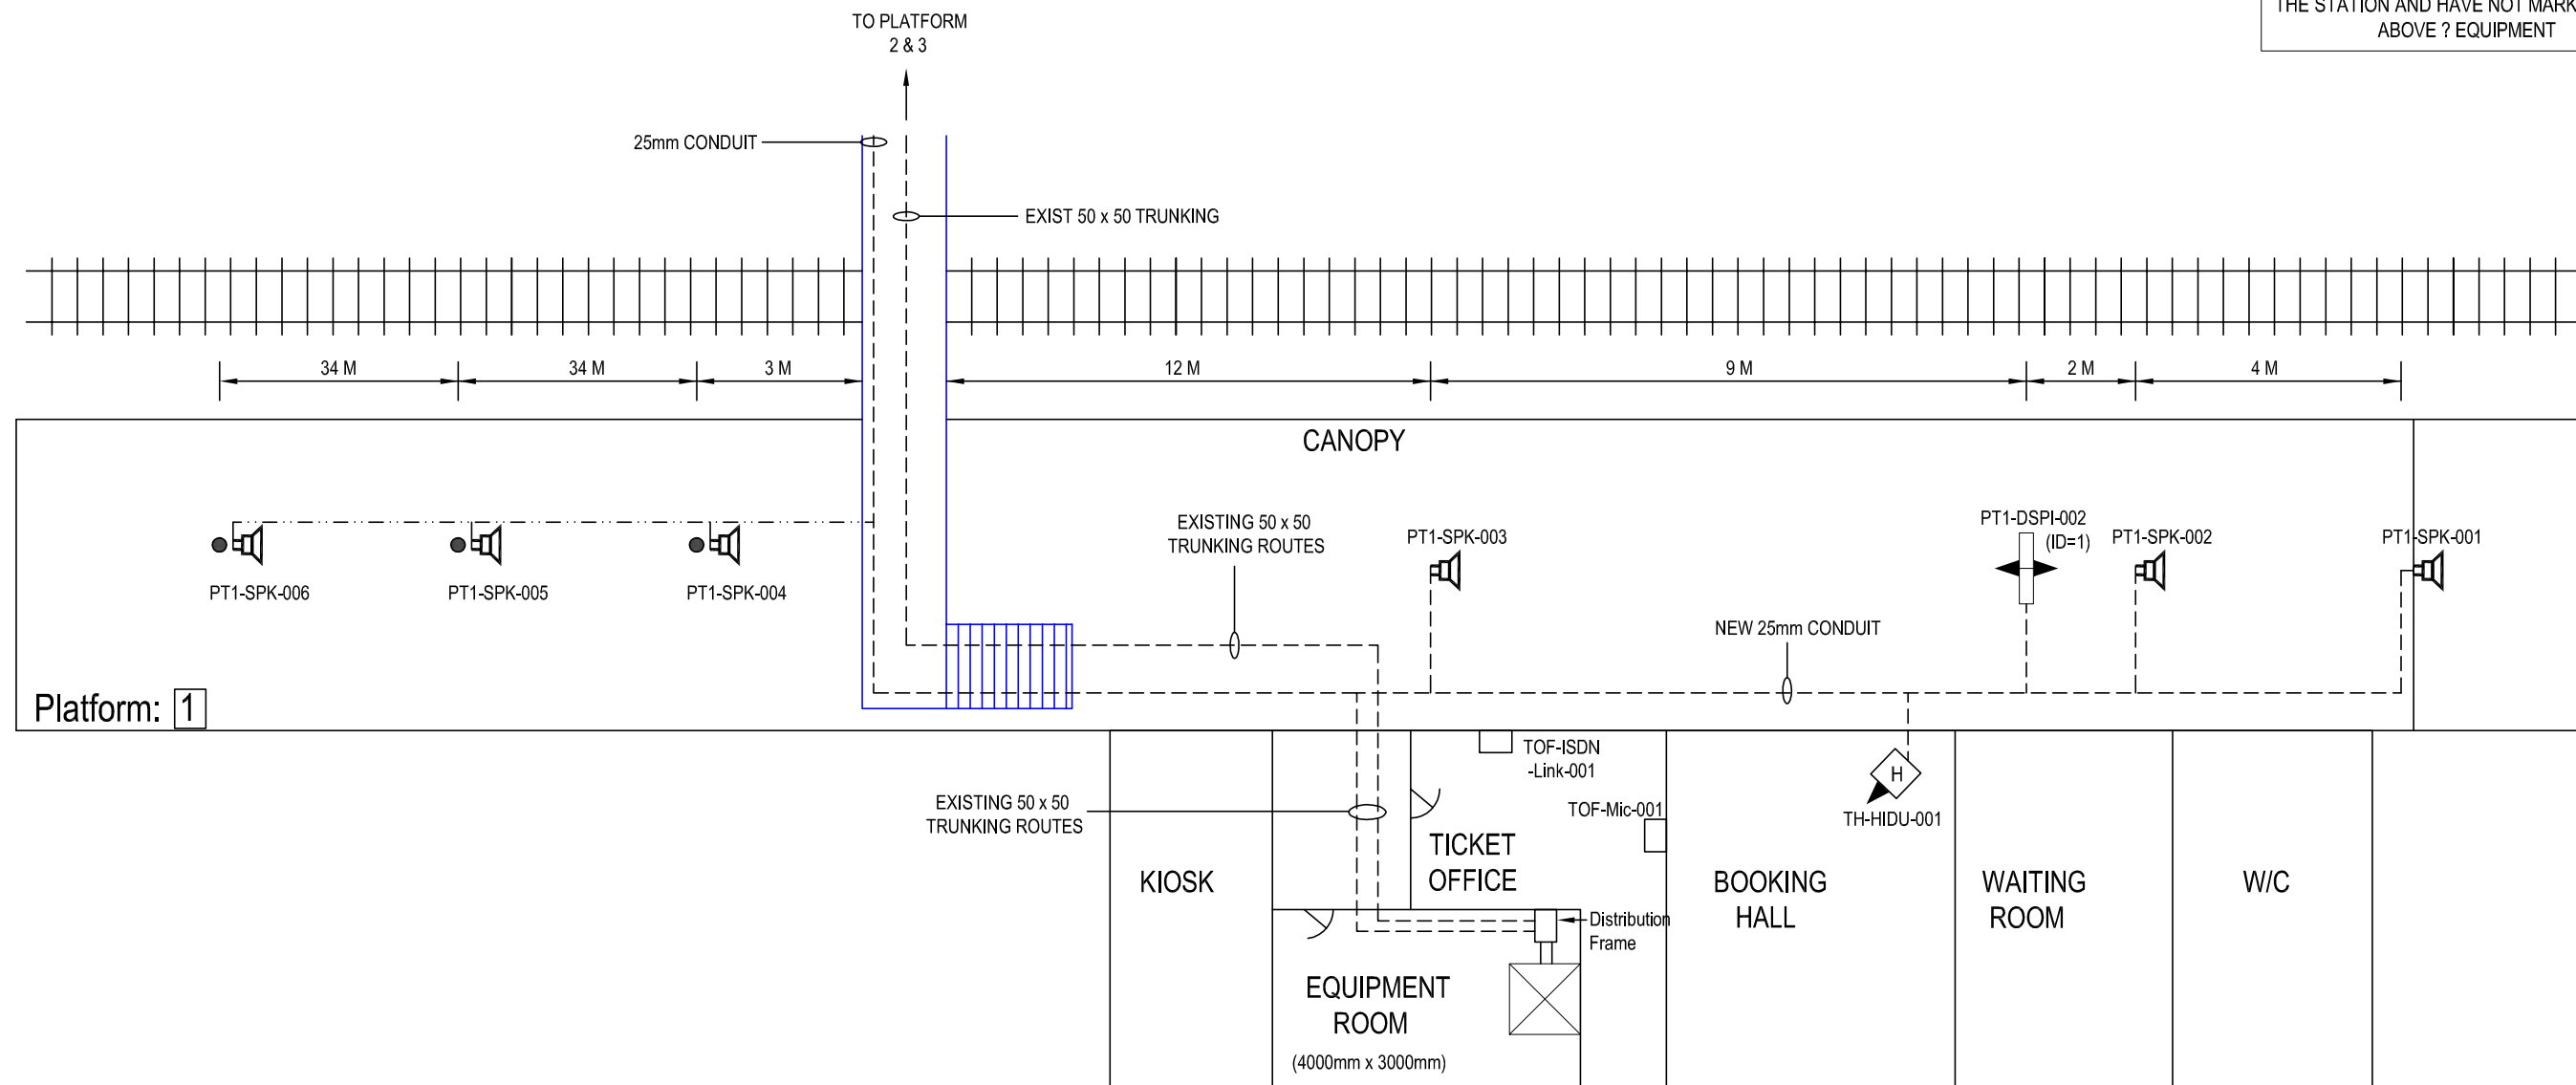

IF IN DOUBT ASK!


MATERIAL	CONSTRUCTION	NAME	SIGNATURE	DATE	 <p>AMEY DATEL Project Offices 1st Floor, Platform 2/3 Eastleigh Station Southampton Road Eastleigh Hants SO50 9FL</p>	SITE/PROJECT		
		DRAWN BY	D GADDU	16-04-2002		SOUTH WEST TRAINS CIS PROJECT		
FINISH		CHECKED BY	T WONG		<p>COPYRIGHT © AMEY Rail All rights reserved. Neither this drawing or any of the information it contains may be copied or communicated to third parties without the written permission of the copyright holder</p>	TITLE		
		APPD BY	A SMITH			ALTON AS BUILT		
		CAD Ref:			SCALE	DRG No.	ISSUE	SHEET
		CONTRACTOR'S Ref:			NTS	SM803-75544	B	1 of 2

SM803-75544

WAN	
CIRCUIT ID	KXIP 600361
IP ADDRESS	10.22.7.98.1


"PLATFORM 1 HP ISDN"
01420-543057

All Equipment tags to be prefixed with "AON-"

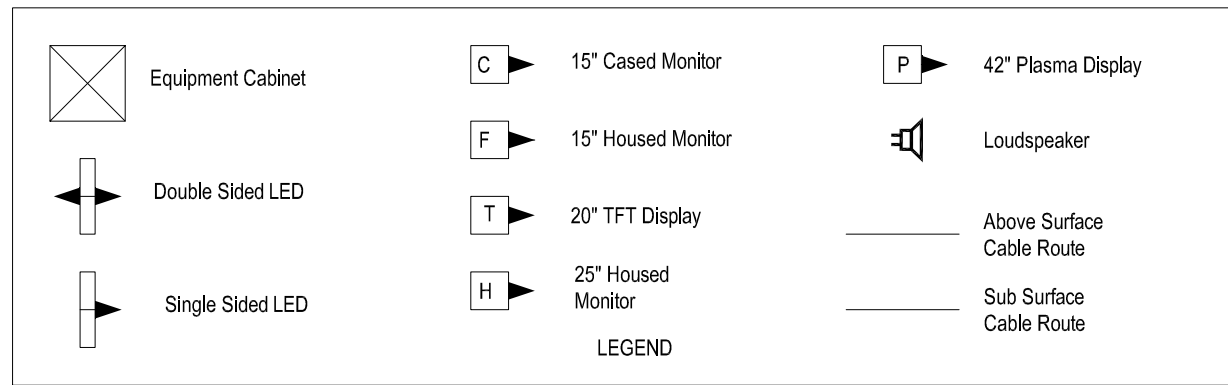

Equipment	Dist Board	
CIS CABINET	LTG/POWER/1	WAY 24
PLAT 1 LED	?	?
PLAT 2 LED	LTG/POWER/1	WAY 48
MONITOR B/H	?	?

NOTE: SERCO ELECTRICAL HAVE RE-WIRED THE STATION AND HAVE NOT MARKED UP ABOVE ? EQUIPMENT

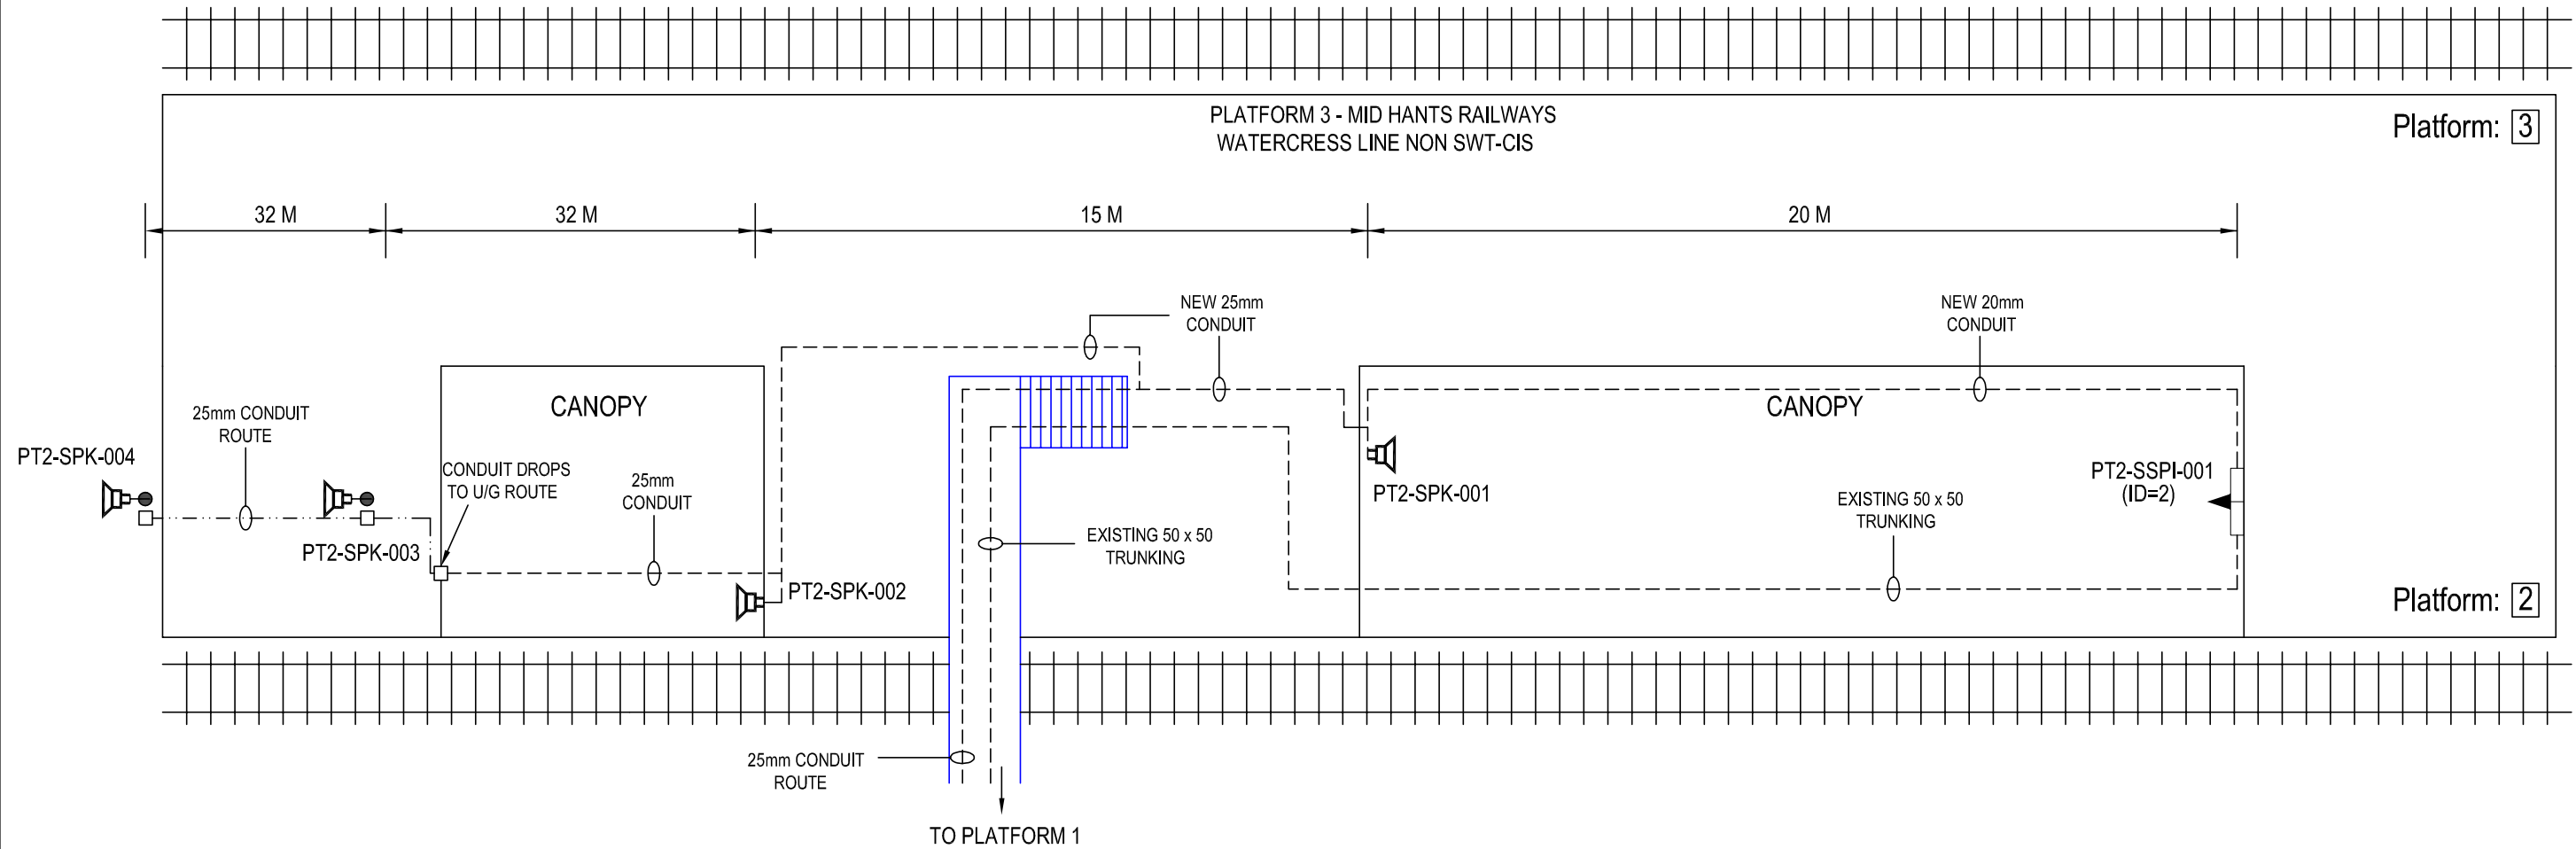

IF IN DOUBT ASK!

MATERIAL	CONSTRUCTION	DRAWN BY	D GADDU	SIGNATURE		<p>AMEY DATEL Project Offices 1st Floor, Platform 2/3 Eastleigh Station Southampton Road Eastleigh Hants SO50 9FL</p>	SITE/PROJECT		SOUTH WEST TRAINS CIS PROJECT	
		CHECKED BY	T WONG	DATE	17-04-2002		TITLE		ALTON AS BUILT	
FINISH		APPD BY	A SMITH			<p>COPYRIGHT © AMEY Rail All rights reserved. Neither this drawing or any of the information it contains may be copied or communicated to third parties without the written permission of the copyright holder</p>	SCALE	DRG No.	ISSUE	SHEET
		CAD Ref:					NTS	SM803-75544	B	2 of 2
		CONTRACTOR'S Ref:								