



WAN	
CIRCUIT ID	KXIP 600364
IP ADDRESS	10.227.94.1

"PLATFORM 1 HP ISDN"
01252-342571
"PLATFORM 2 HP ISDN"
01252-342572

All Equipment tags to be prefixed with "ASH-"

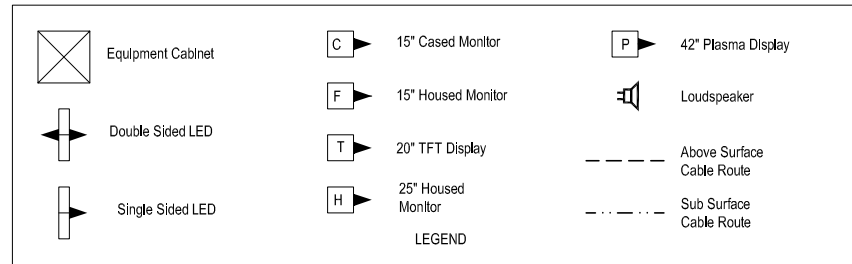

Equipment	Dist Board
TH-FIDU-001	GP1 CCT15
CIS RACK	GP1 CCT16
PT2-DSPI-001	GP1 CCT17
PT1-DSPI-002	GP1 CCT18

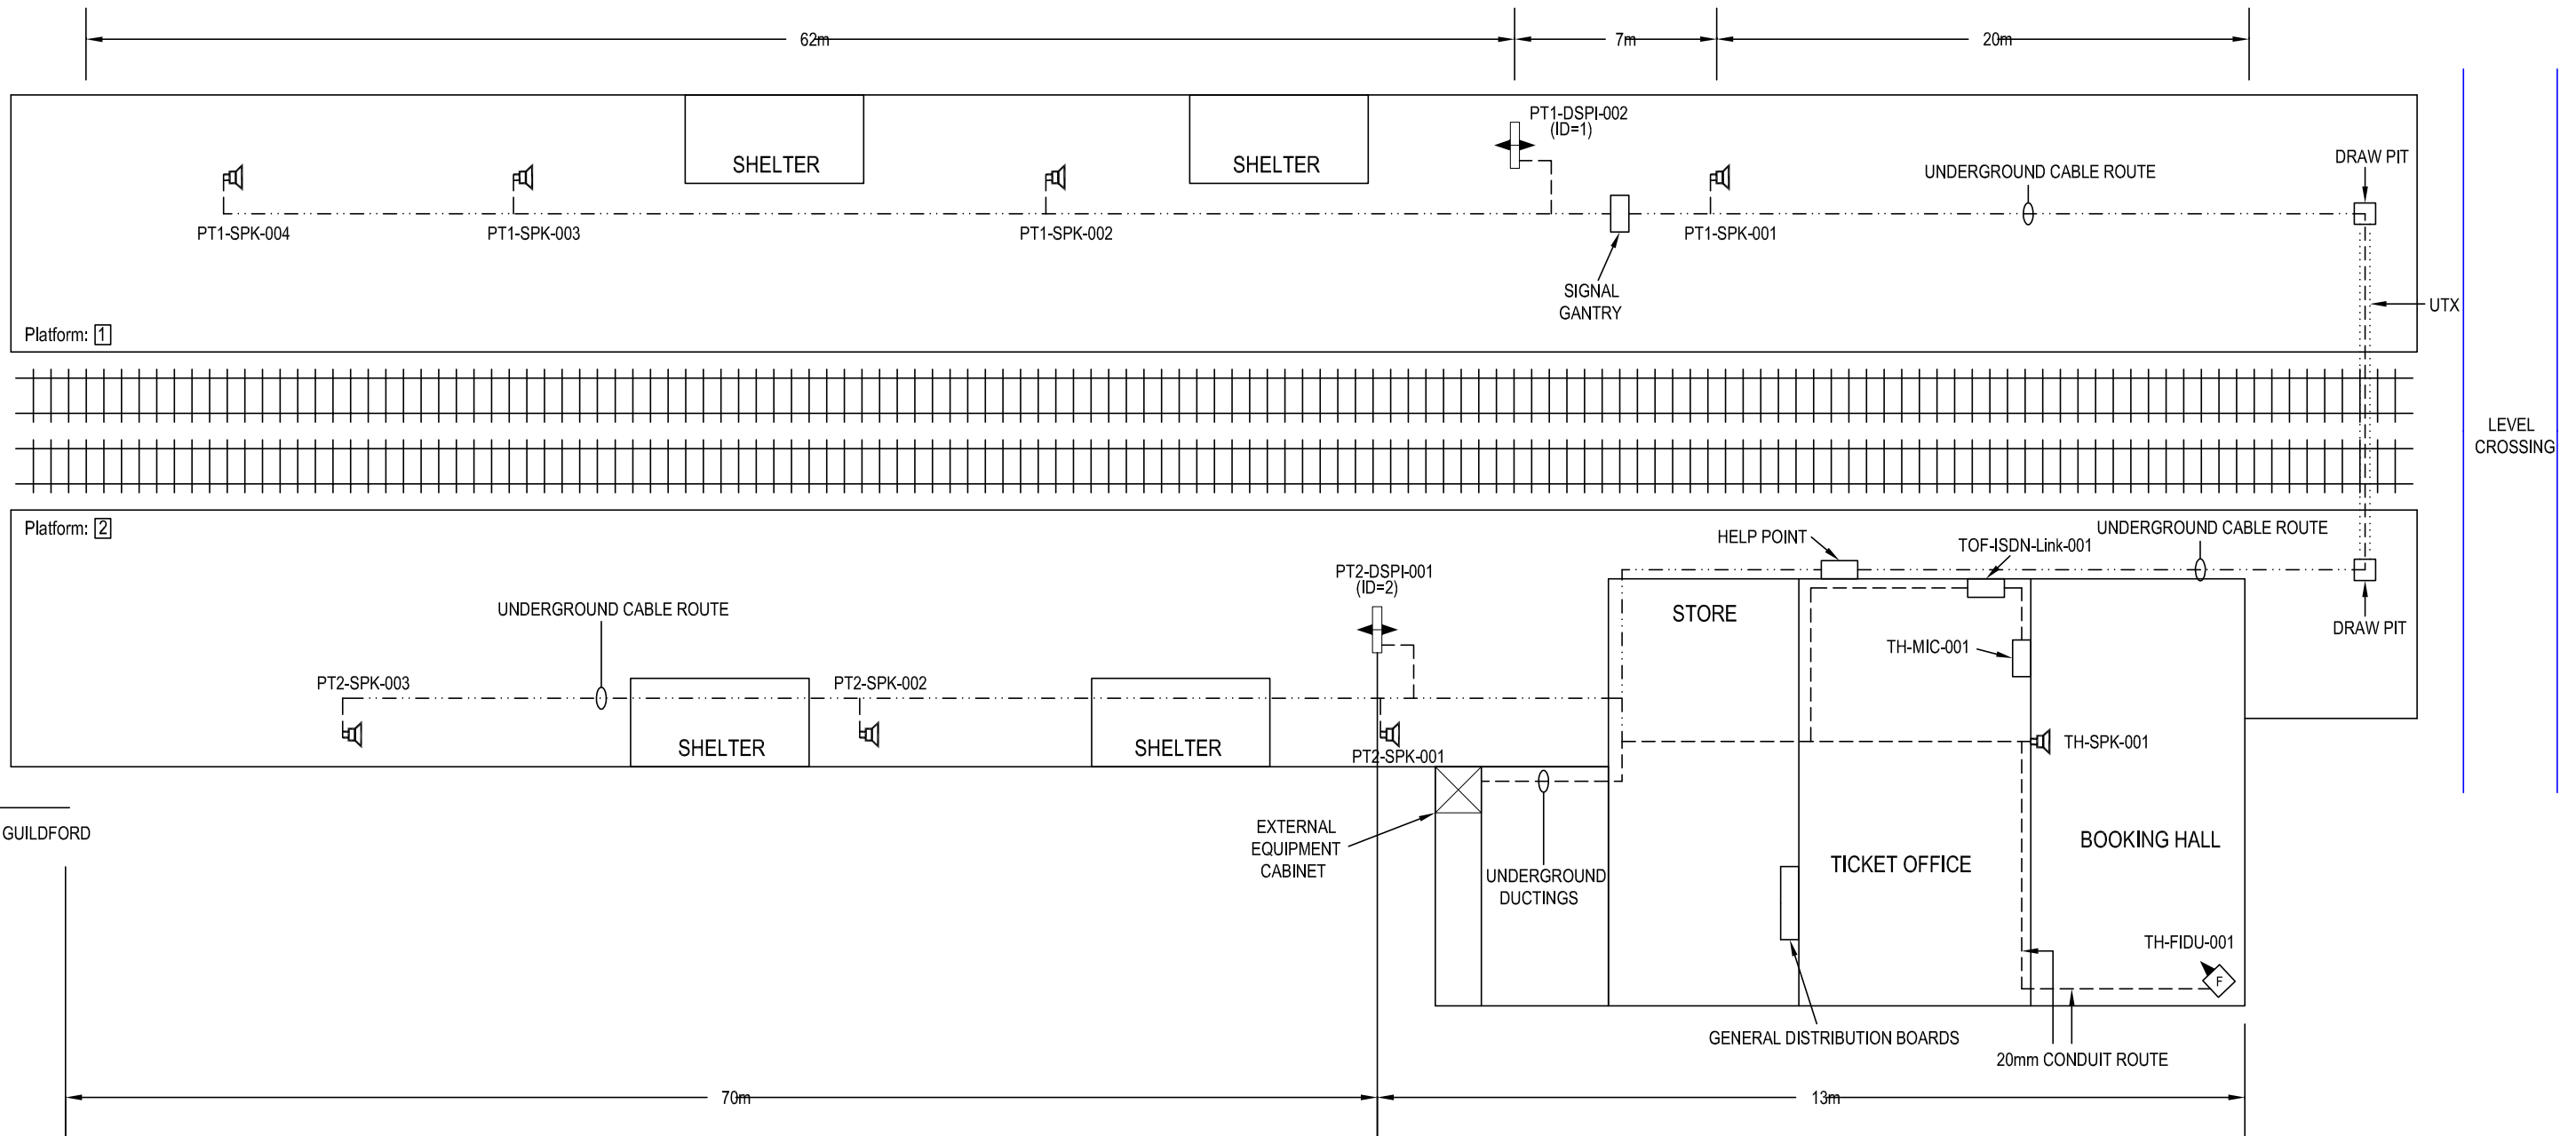


IF IN DOUBT ASK!

Date of Last Modification: 25 April 2003

This Drawing Supersedes Any Previous Drawings

CONSTRUCTION	NAME	SIGNATURE	DATE
DRAWN BY	J STEVENS		25-04-2003
CHECKED BY	T WONG		
APPD BY	A SMITH		
APPD BY			
CAD Ref:			
CONTRACTOR'S Ref:			



AMEY DATEL Project
 Offices
 1st Floor, Platform
 2/3
 Eastleigh Station
 Southampton Road
 Eastleigh
 Hants
 SO50 9FL

COPYRIGHT © AMEY Rail
 All rights reserved. Neither this drawing or any of the information it contains may be copied or communicated to third parties without the written permission of the copyright holder

SITE/PROJECT		SOUTH WEST TRAINS CIS PROJECT	
TITLE		ASH AS BUILT	
SCALE	DRG No.	ISSUE	SHEET
NTS	SM803-75641	C	1 of 1