



WAN	
CIRCUIT ID	KXIP900450
IP ADDRESS	10.227.95.1

"PLATFORM 1 HP ISDN"
01-932-830233
"PLATFORM 2 HP ISDN"
01-932-830234

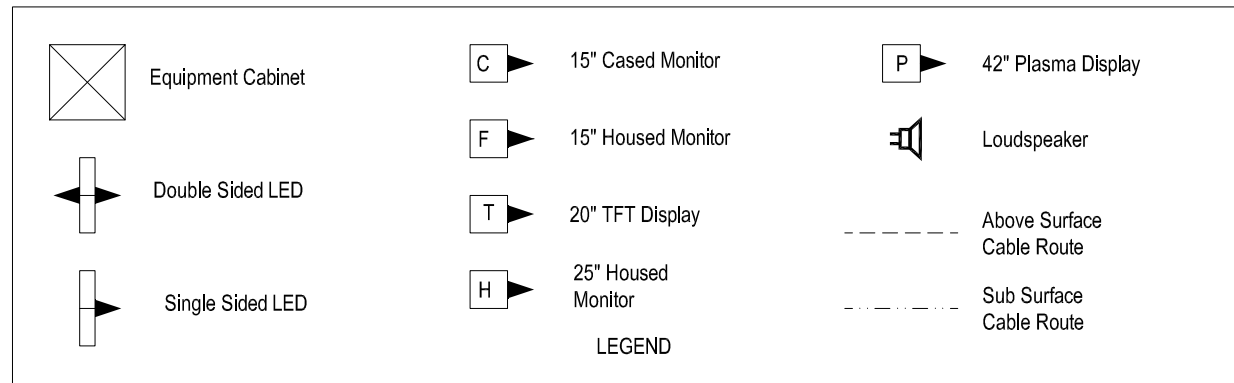

Equipment	Dist Board
CIS RACK	NEW BOARD
TOF-CIDU-001	EXISTING SPUR
PT1-FIDU-002	EXISTING SPUR
PT1-DSPI-001	GP1 CCT 6
PT2-DSPI-002	GP1 CCT 4

All Equipment tags to be prefixed with "ASN-"

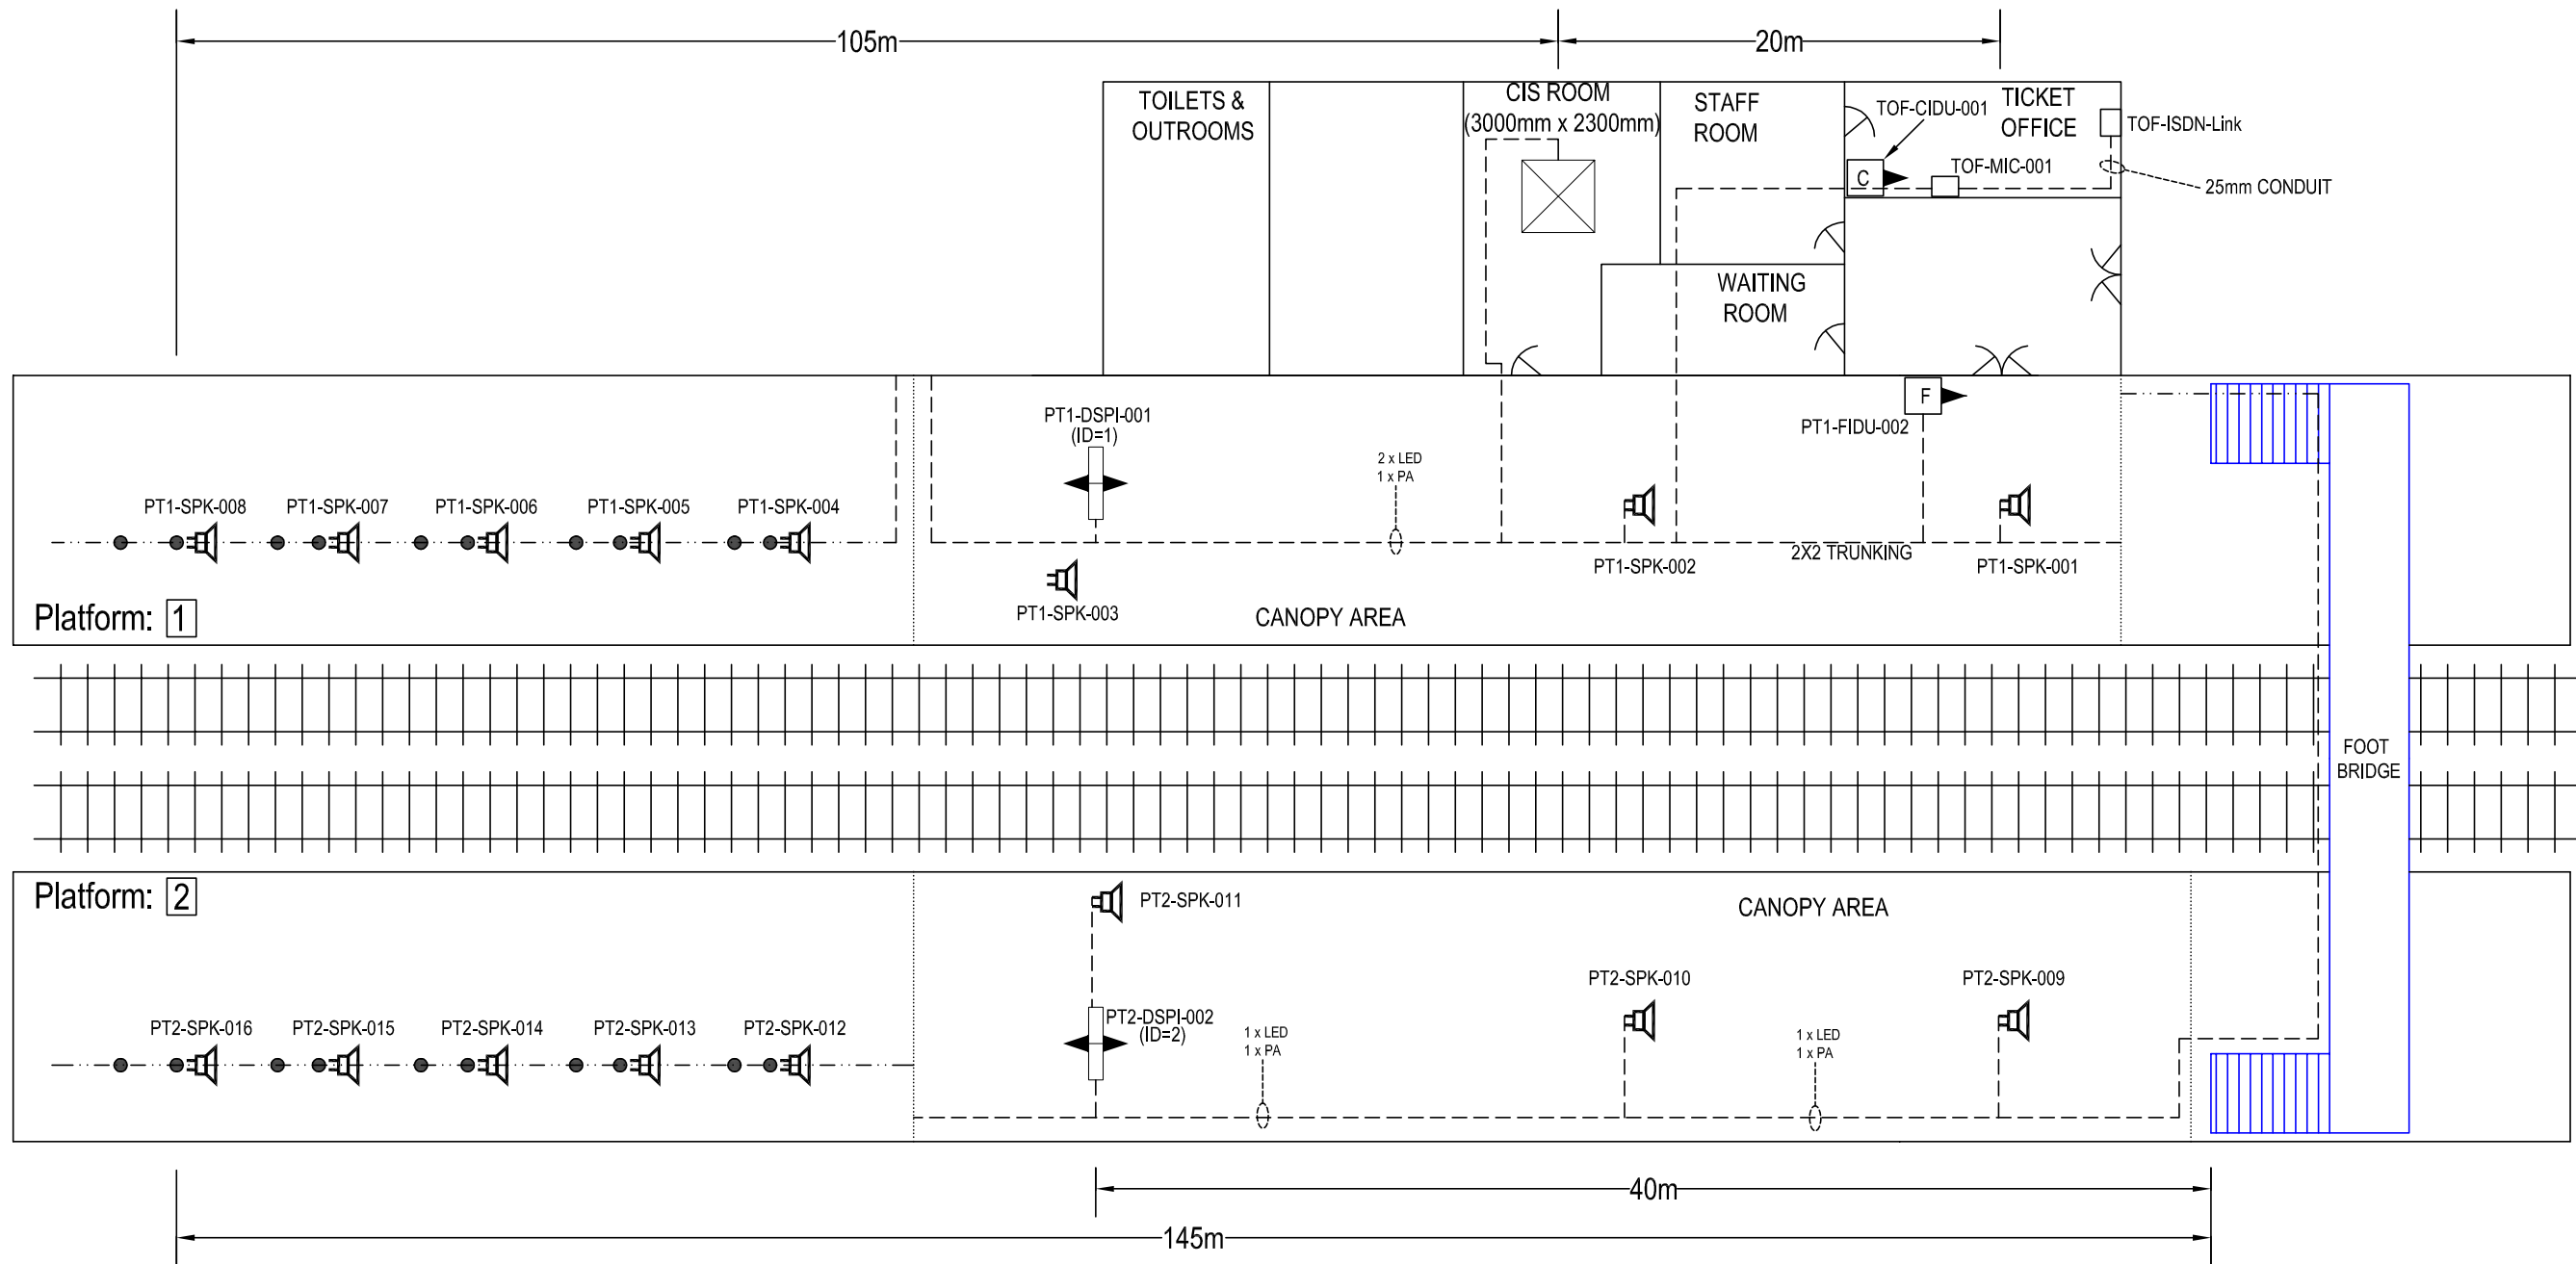

IF IN DOUBT ASK!

MATERIAL	CONSTRUCTION	NAME	SIGNATURE	DATE	<p>AMEY DATEL Project Offices 1st Floor, Platform 2/3 Eastleigh Station Southampton Road Eastleigh Hants SO50 9FL</p>	SITE/PROJECT			
		DRAWN BY	D GADDU	08-03-2002		SOUTH WEST TRAINS CIS PROJECT			
FINISH	CONSTRUCTION	CHECKED BY	T WONG		<p>COPYRIGHT © AMEY Rail All rights reserved. Neither this drawing or any of the information it contains may be copied or communicated to third parties without the written permission of the copyright holder</p>	TITLE			
		APPD BY	A SMITH			ADDLESTONE AS BUILT			
		CAD Ref:				SCALE	DRG No.	ISSUE	SHEET
		CONTRACTOR'S Ref:				NTS	SM803-75550	B	1 of 1