



| WAN | |
|------------|--------------|
| CIRCUIT ID | KXIP 600 368 |
| IP ADDRESS | 10.227.90.1 |

| |
|----------------------|
| "PLATFORM 1 HP ISDN" |
| 01297-33346 |


All Equipment tags to be prefixed with "AXM-"

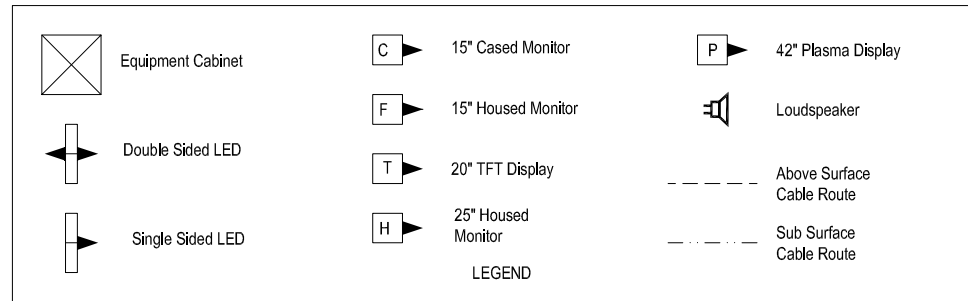

| EQUIPMENT | DIST BOARD |
|-----------------|------------|
| CIS RACK | CCT NO. 1 |
| HEATER | CCT NO. 2 |
| TWIN 13 AMP | CCT NO. 3 |
| CRT TICKET HALL | CCT NO. 4 |
| LED PT1 | CCT NO. 5 |
| SPARE | CCT NO. 6 |

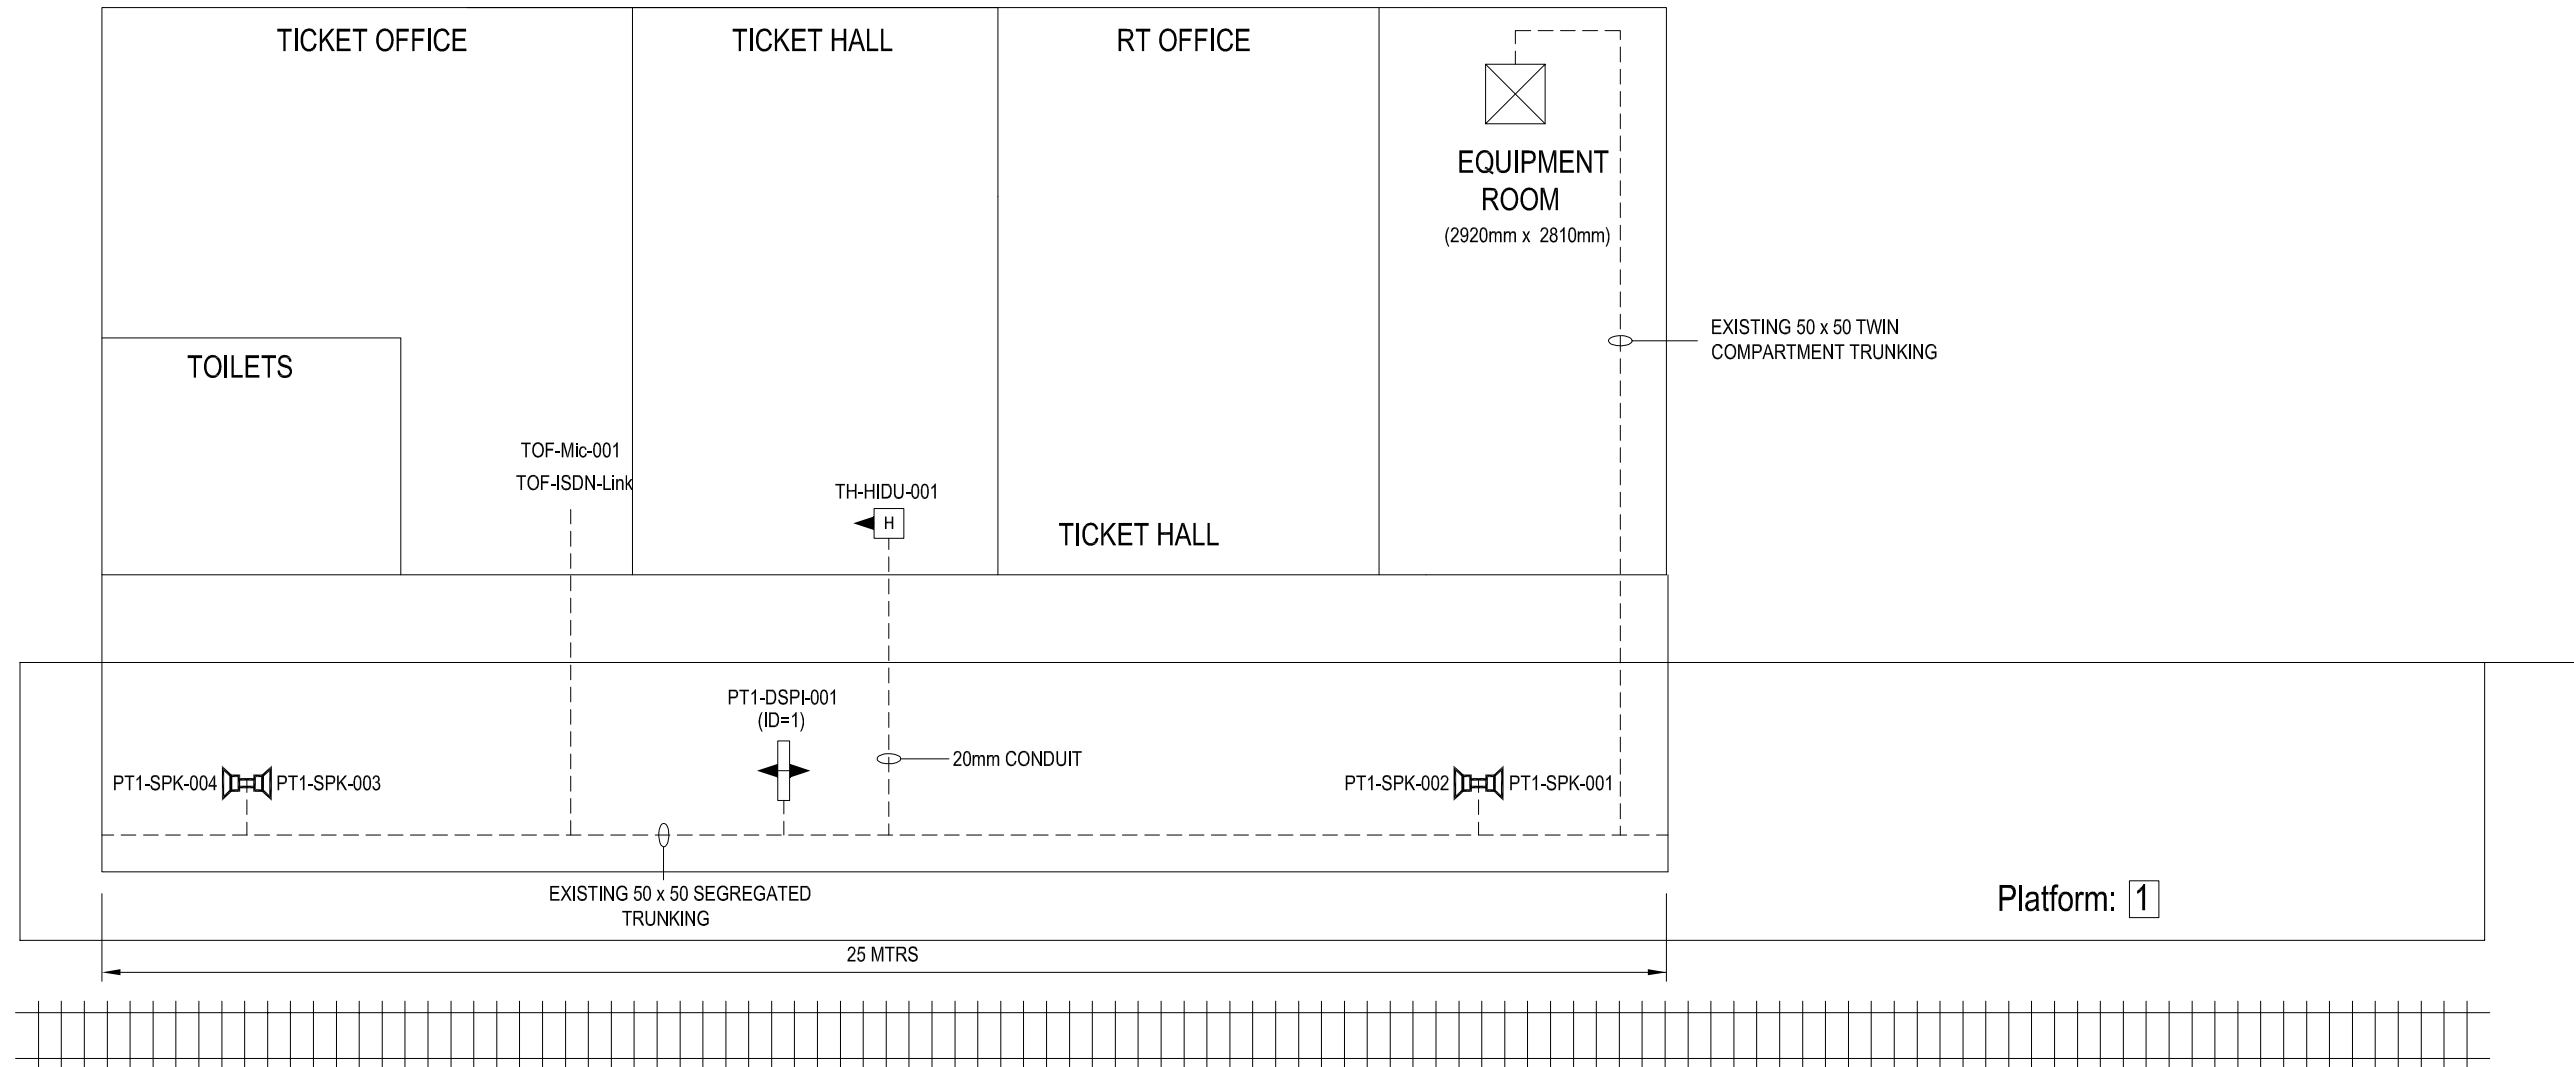

IF IN DOUBT ASK!

| | | | | | | | | | |
|----------|--------------|-------------------|-----------|------------|--|-------------------------------|-------------|-------|--------|
| MATERIAL | CONSTRUCTION | NAME | SIGNATURE | DATE |  AMEY DATEL Project Offices 1st Floor, Platform 2/3 Eastleigh Station Southampton Road Eastleigh Hants SO50 9FL | SITE/PROJECT | | | |
| | | DRAWN BY | D GADDU | 15-03-2002 | | SOUTH WEST TRAINS CIS PROJECT | | | |
| FINISH | CONSTRUCTION | CHECKED BY | T WONG | | COPYRIGHT © AMEY Rail All rights reserved. Neither this drawing or any of the information it contains may be copied or communicated to third parties without the written permission of the copyright holder | TITLE | | | |
| | | APPD BY | | | | AXMINSTER AS BUILT | | | |
| | | APPD BY | | | | SCALE | DRG No. | ISSUE | SHEET |
| | | CAD Ref: | | | | NTS | SM803-75714 | B | 1 of 1 |
| | | CONTRACTOR'S Ref: | | | | | | | |