


SM803-75681


WAN	
CIRCUIT ID	KXIP 900430
IP ADDRESS	10.227.89.1

"PLATFORM 1 HP ISDN"
01276-453028
"PLATFORM 2 HP ISDN"
01276-453035

All Equipment tags to be prefixed with "BAG-"

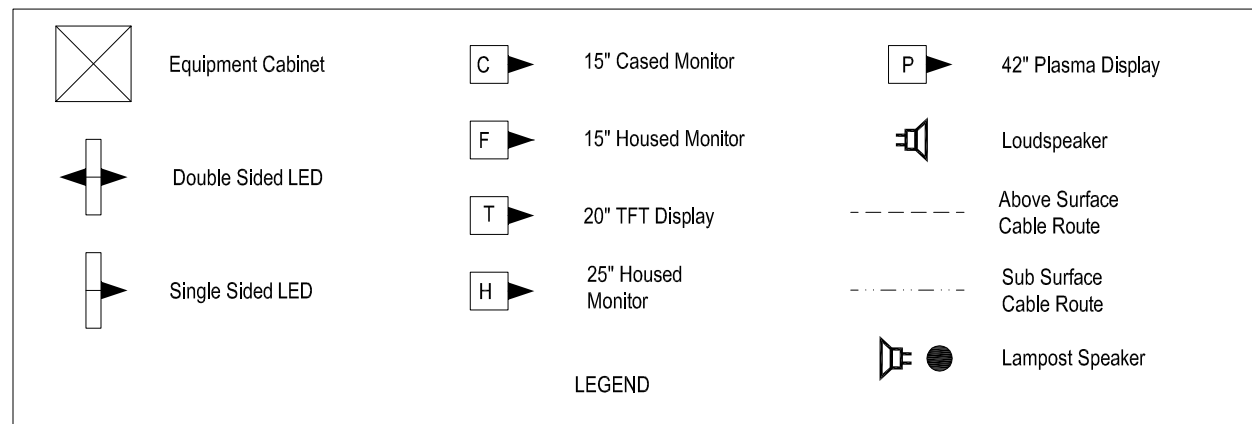

Equipment	Dist Board
1	CIS
2	SOCKET
3	HEAT
4	LIGHT
PT1-DSPI-001	GPI
PT2-DSPI-002	BREAKER UP

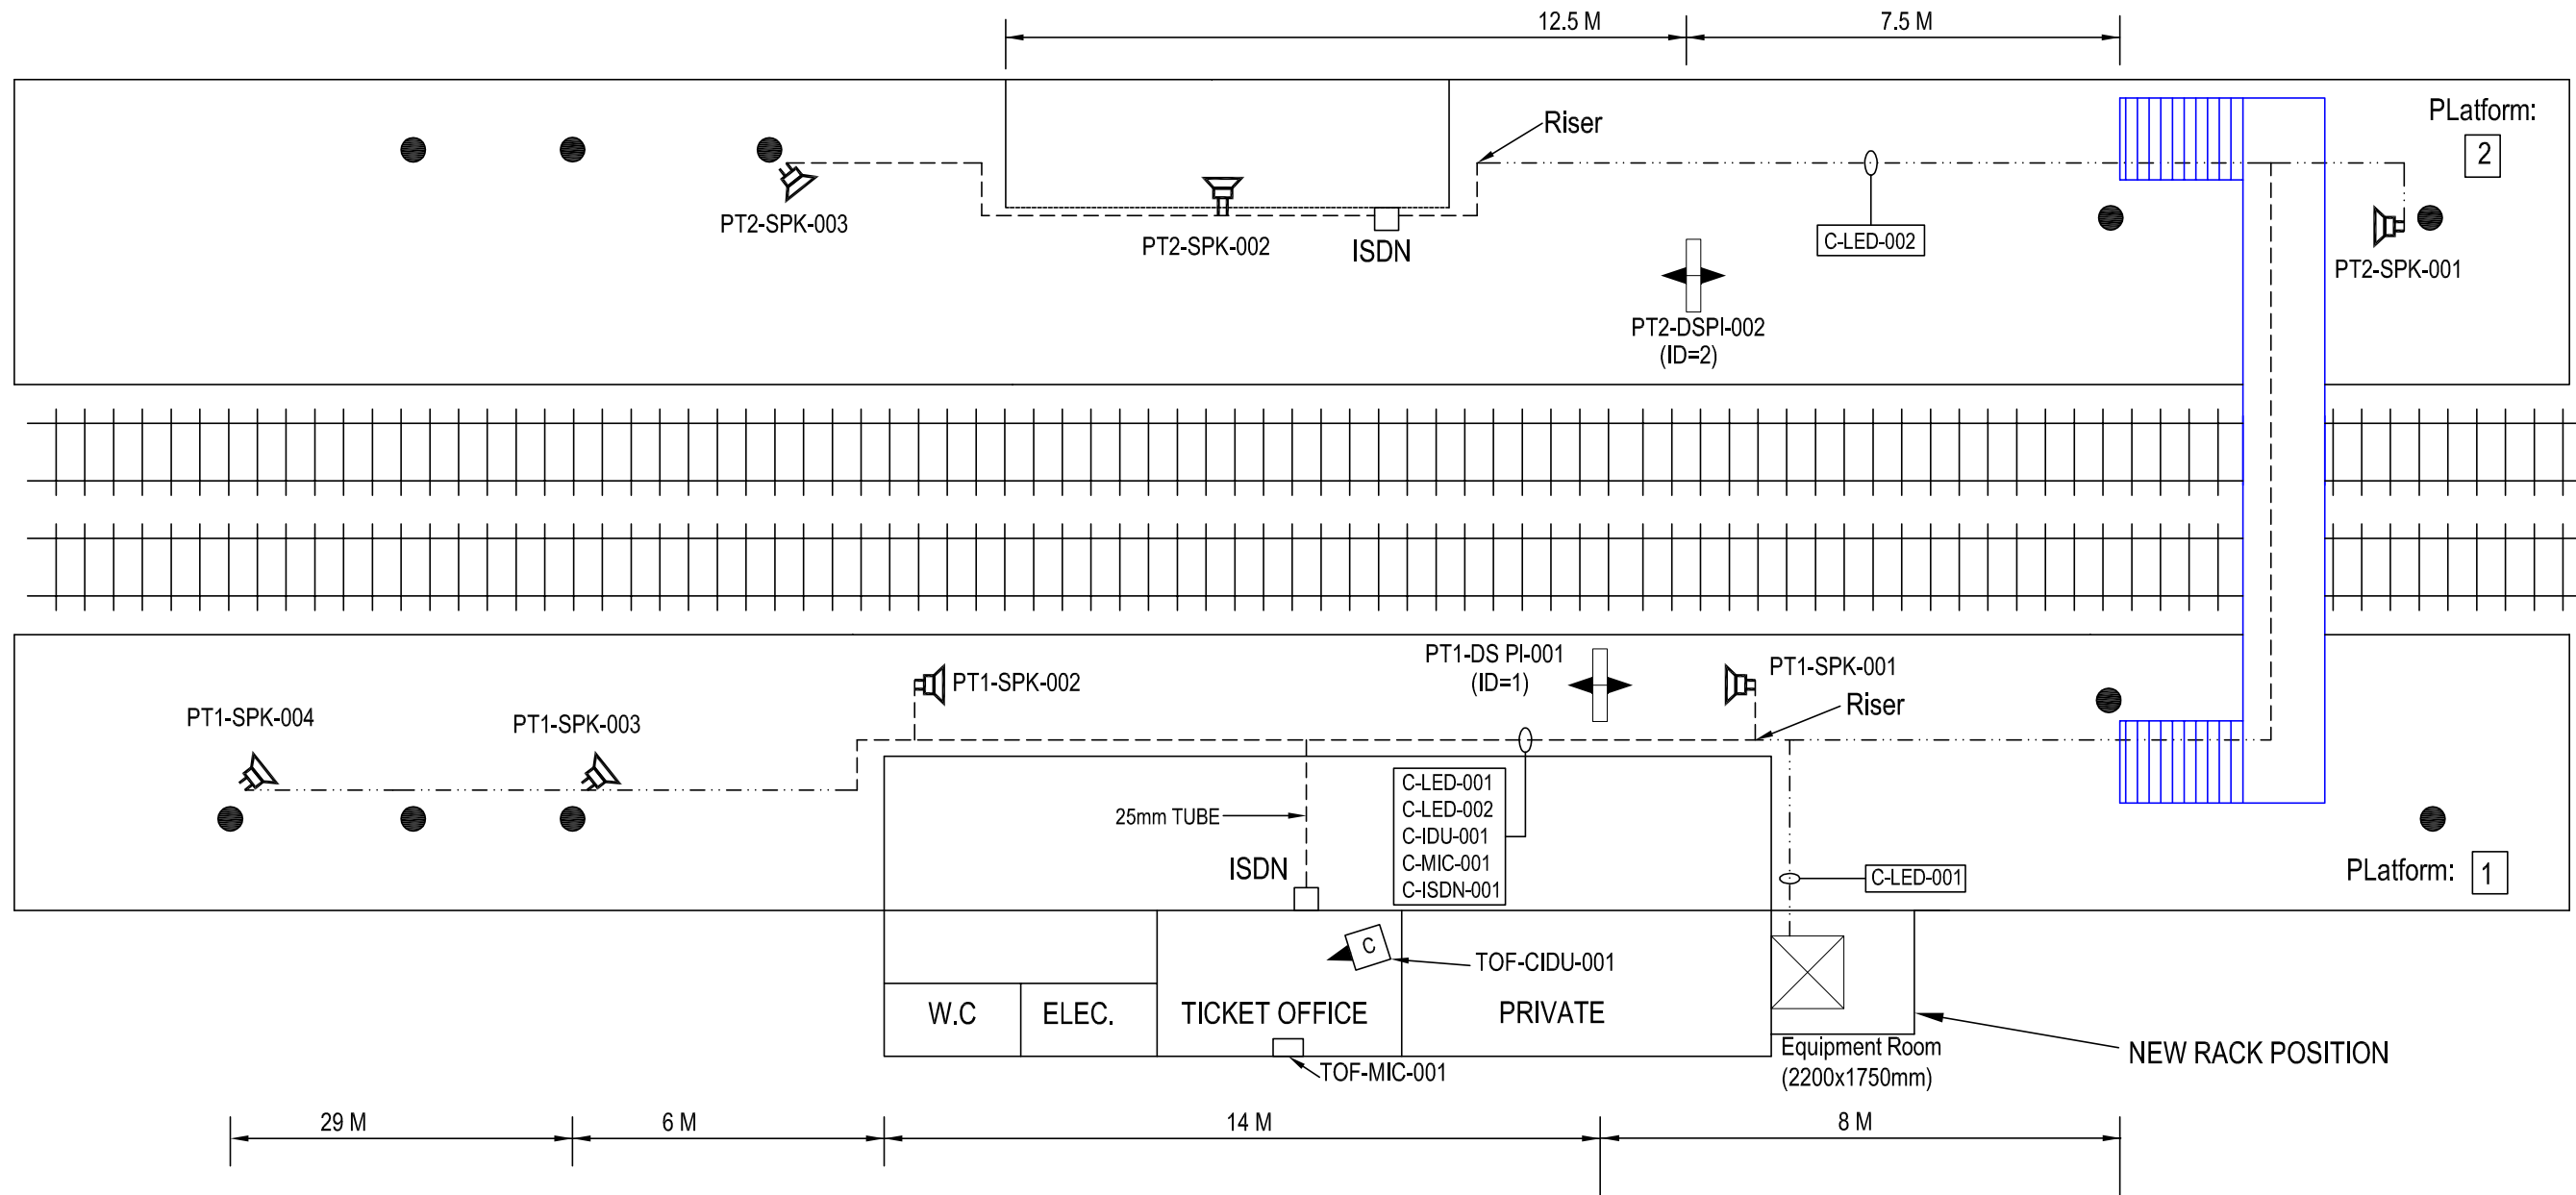

IF IN DOUBT ASK!

MATERIAL	CONSTRUCTION	<table border="1"> <thead> <tr> <th>NAME</th> <th>SIGNATURE</th> <th>DATE</th> </tr> </thead> <tbody> <tr> <td>D GADDU</td> <td></td> <td>26-02-2002</td> </tr> <tr> <td>T WONG</td> <td></td> <td></td> </tr> <tr> <td>A SMITH</td> <td></td> <td></td> </tr> </tbody> </table>	NAME	SIGNATURE	DATE	D GADDU		26-02-2002	T WONG			A SMITH			<p>AMEY DATEL Project Offices 1st Floor, Platform 2/3 Eastleigh Station Southampton Road Eastleigh Hants SO50 9FL</p>	SITE/PROJECT		SOUTH WEST TRAINS CIS PROJECT	
		NAME	SIGNATURE	DATE															
D GADDU		26-02-2002																	
T WONG																			
A SMITH																			
FINISH			TITLE		BAGSHOT AS BUILT														
		CAD Ref:	COPYRIGHT © AMEY Rail All rights reserved. Neither this drawing or any of the information it contains may be copied or communicated to third parties without the written permission of the copyright holder		SCALE	DRG No.	ISSUE	SHEET											
		CONTRACTOR'S Ref:			NTS	SM803-75681	B	1 of 1											