


SM803-75693


WAN	
CIRCUIT ID	KXIP800422
IP ADDRESS	10.227.37.1

"PLATFORM 1 HP ISDN"
01-344-311127
"PLATFORM 2 HP ISDN"
01-344-311128


All Equipment tags to be prefixed with "BCE-"

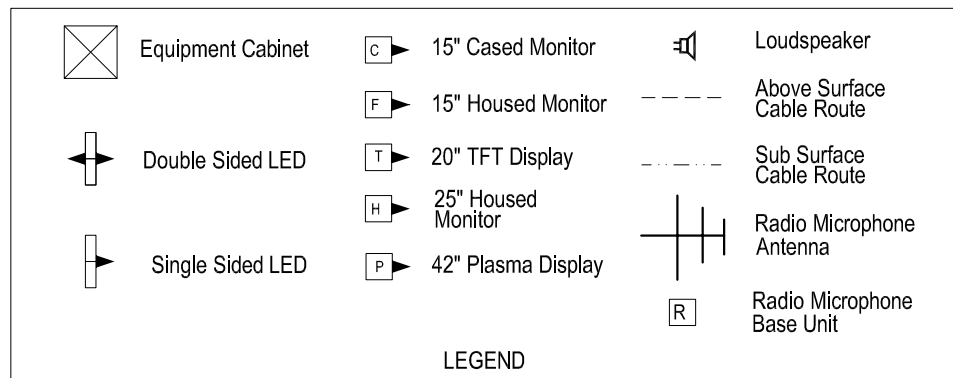

Equipment	Dist Board
RACK	EXISTING SPUR
IDU 001	GP4 CCT 6
IDU 002	GP4 CCT 6
LED 001	EXISTING SPUR
LED 002	EXISTING SPUR

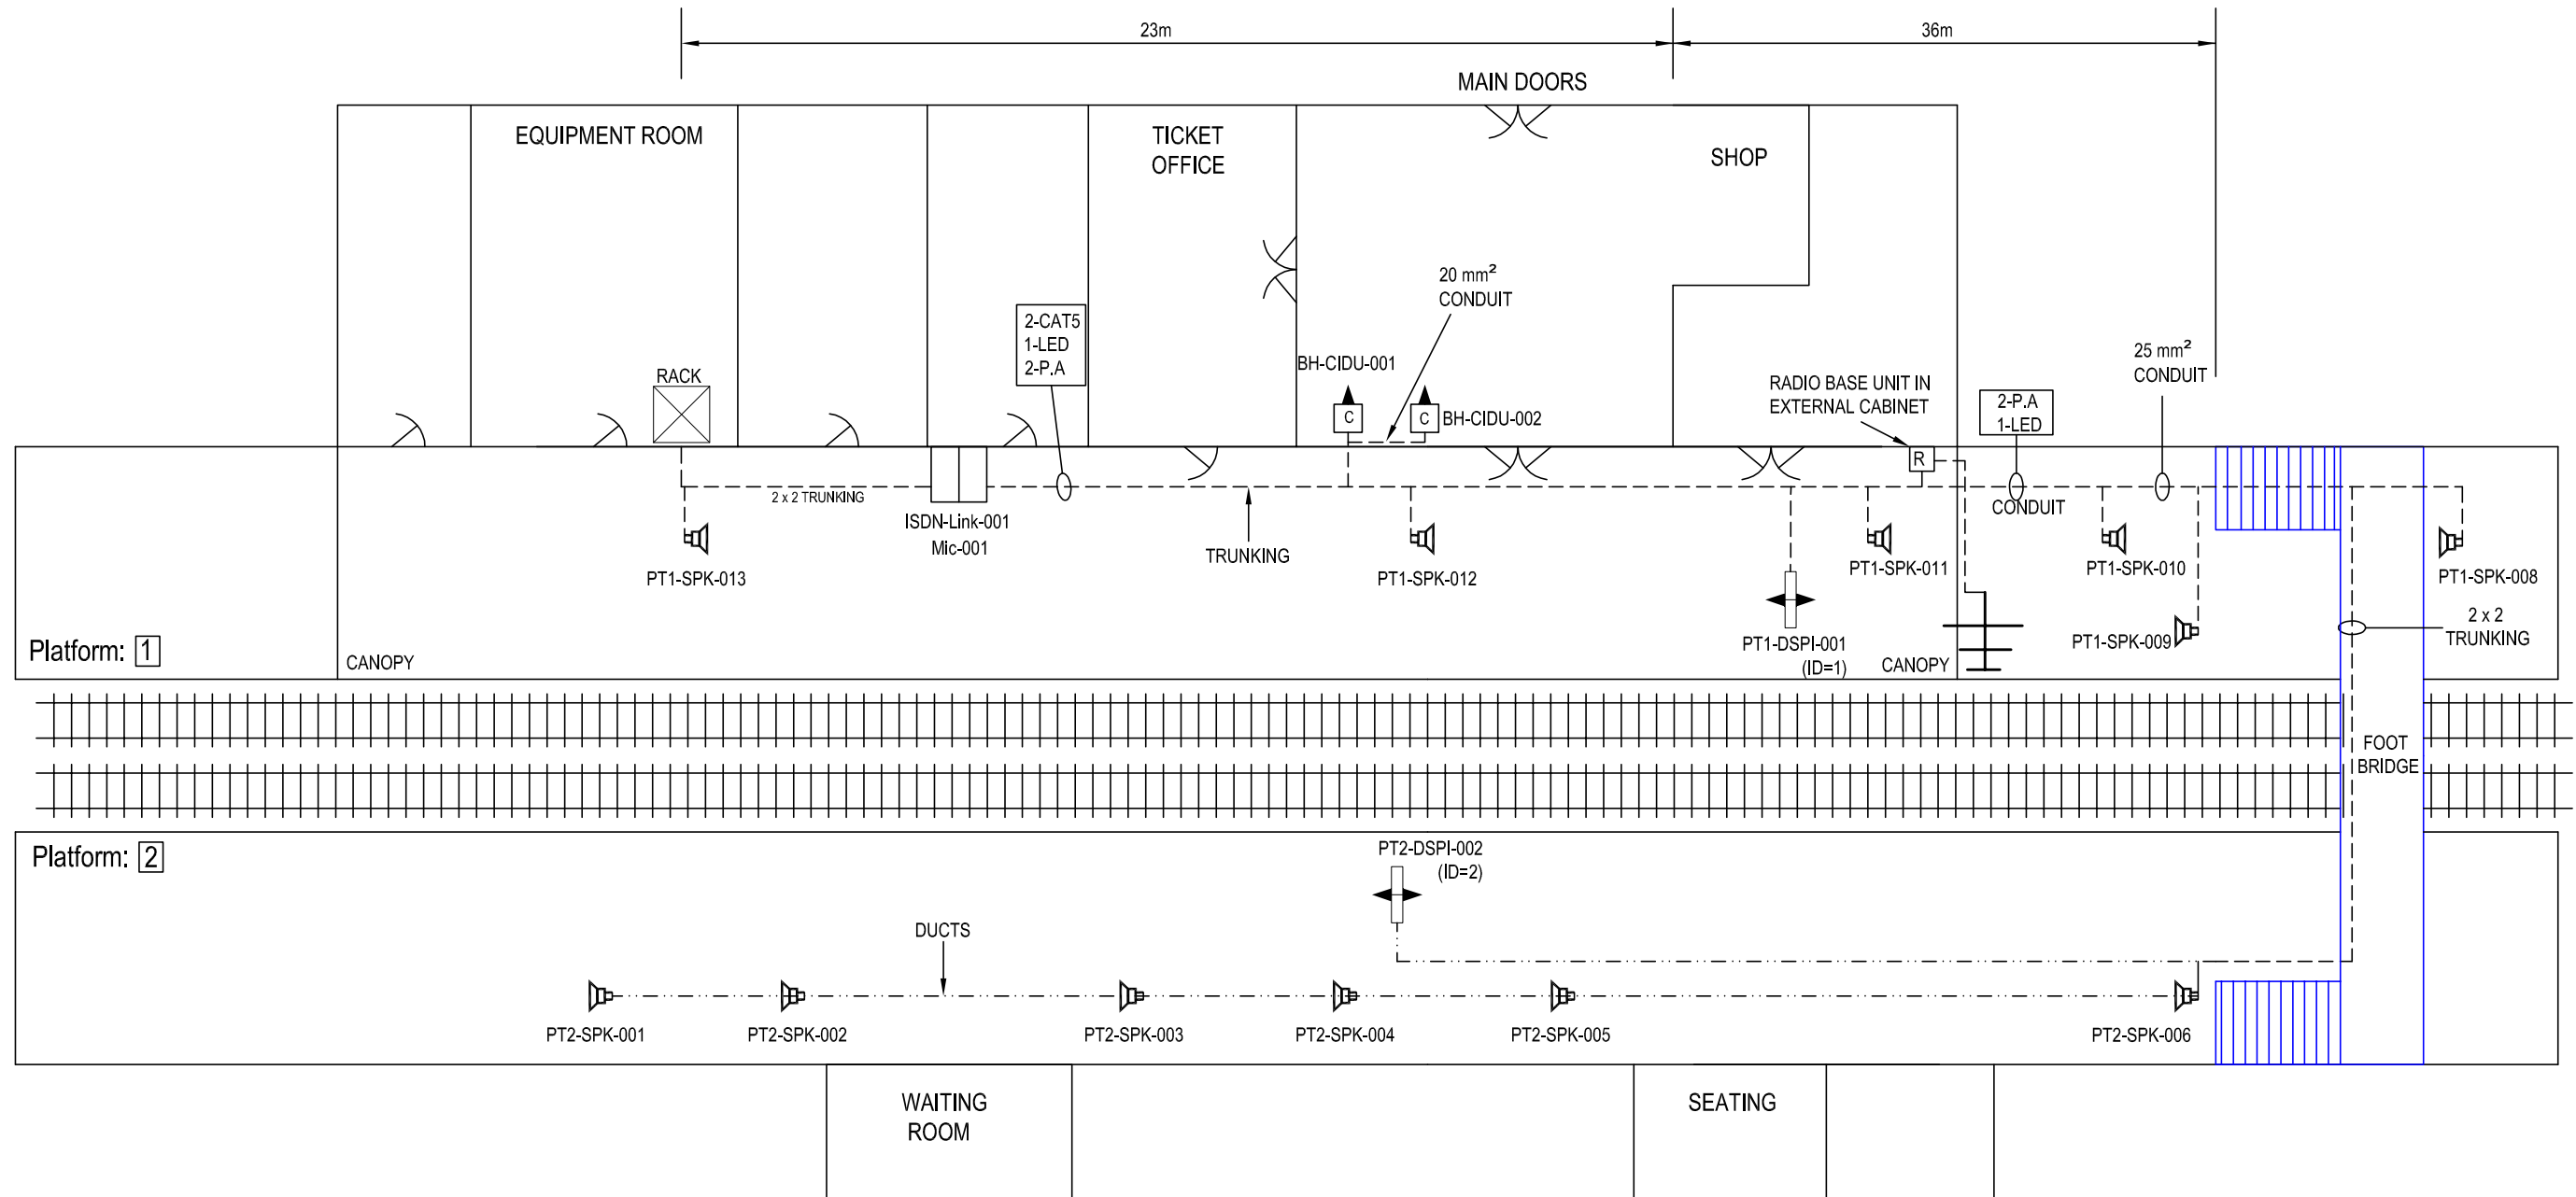

IF IN DOUBT ASK!

MATERIAL	CONSTRUCTION	NAME	SIGNATURE	DATE	 <p>AMEY DATEL Project Offices 1st Floor, Platform 2/3 Eastleigh Station Southampton Road Eastleigh Hants SO50 9FL</p>	SITE/PROJECT				
		DRAWN BY	D GADDU	22-03-2002		SOUTH WEST TRAINS CIS PROJECT				
		CHECKED BY	T WONG			TITLE				
		APPD BY	A SMITH			BRACKNELL STATION AS BUILT				
		APPD BY				SCALE				
FINISH		CAD Ref:				NTS	DRG No.	SM803-75693	ISSUE	SHEET
		CONTRACTOR'S Ref:						B	1 of 1	

COPYRIGHT © AMEY Rail
All rights reserved. Neither this drawing or any of the information it contains may be copied or communicated to third parties without the written permission of the copyright holder