



WAN	
CIRCUIT ID	KXIP 800420
IP ADDRESS	10.227.86.1

"PLATFORM 1 HP ISDN"
02392-470785
"PLATFORM 2 HP ISDN"
02392-470793

All Equipment tags to be prefixed with "BDH-"

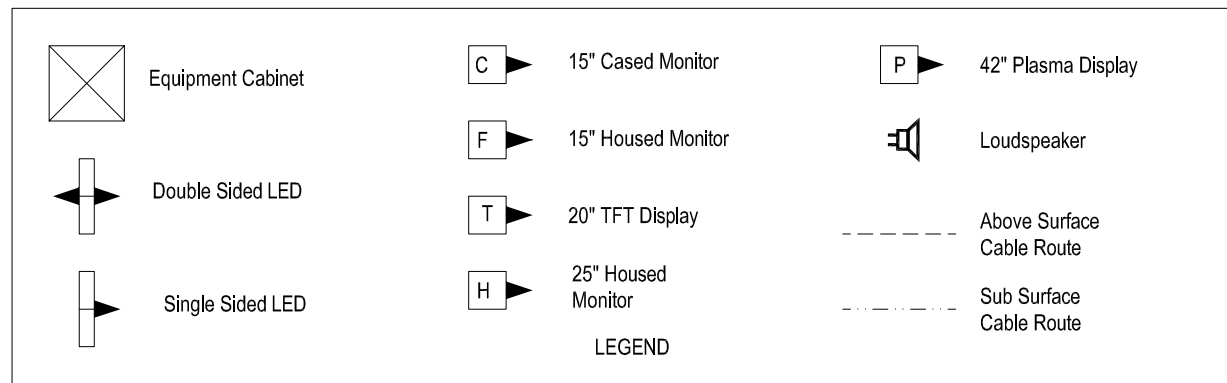

EQUIPMENT	DIST BOARD
CIS RACK	CCT 2
LED	CCT 3
LED	CCT 4

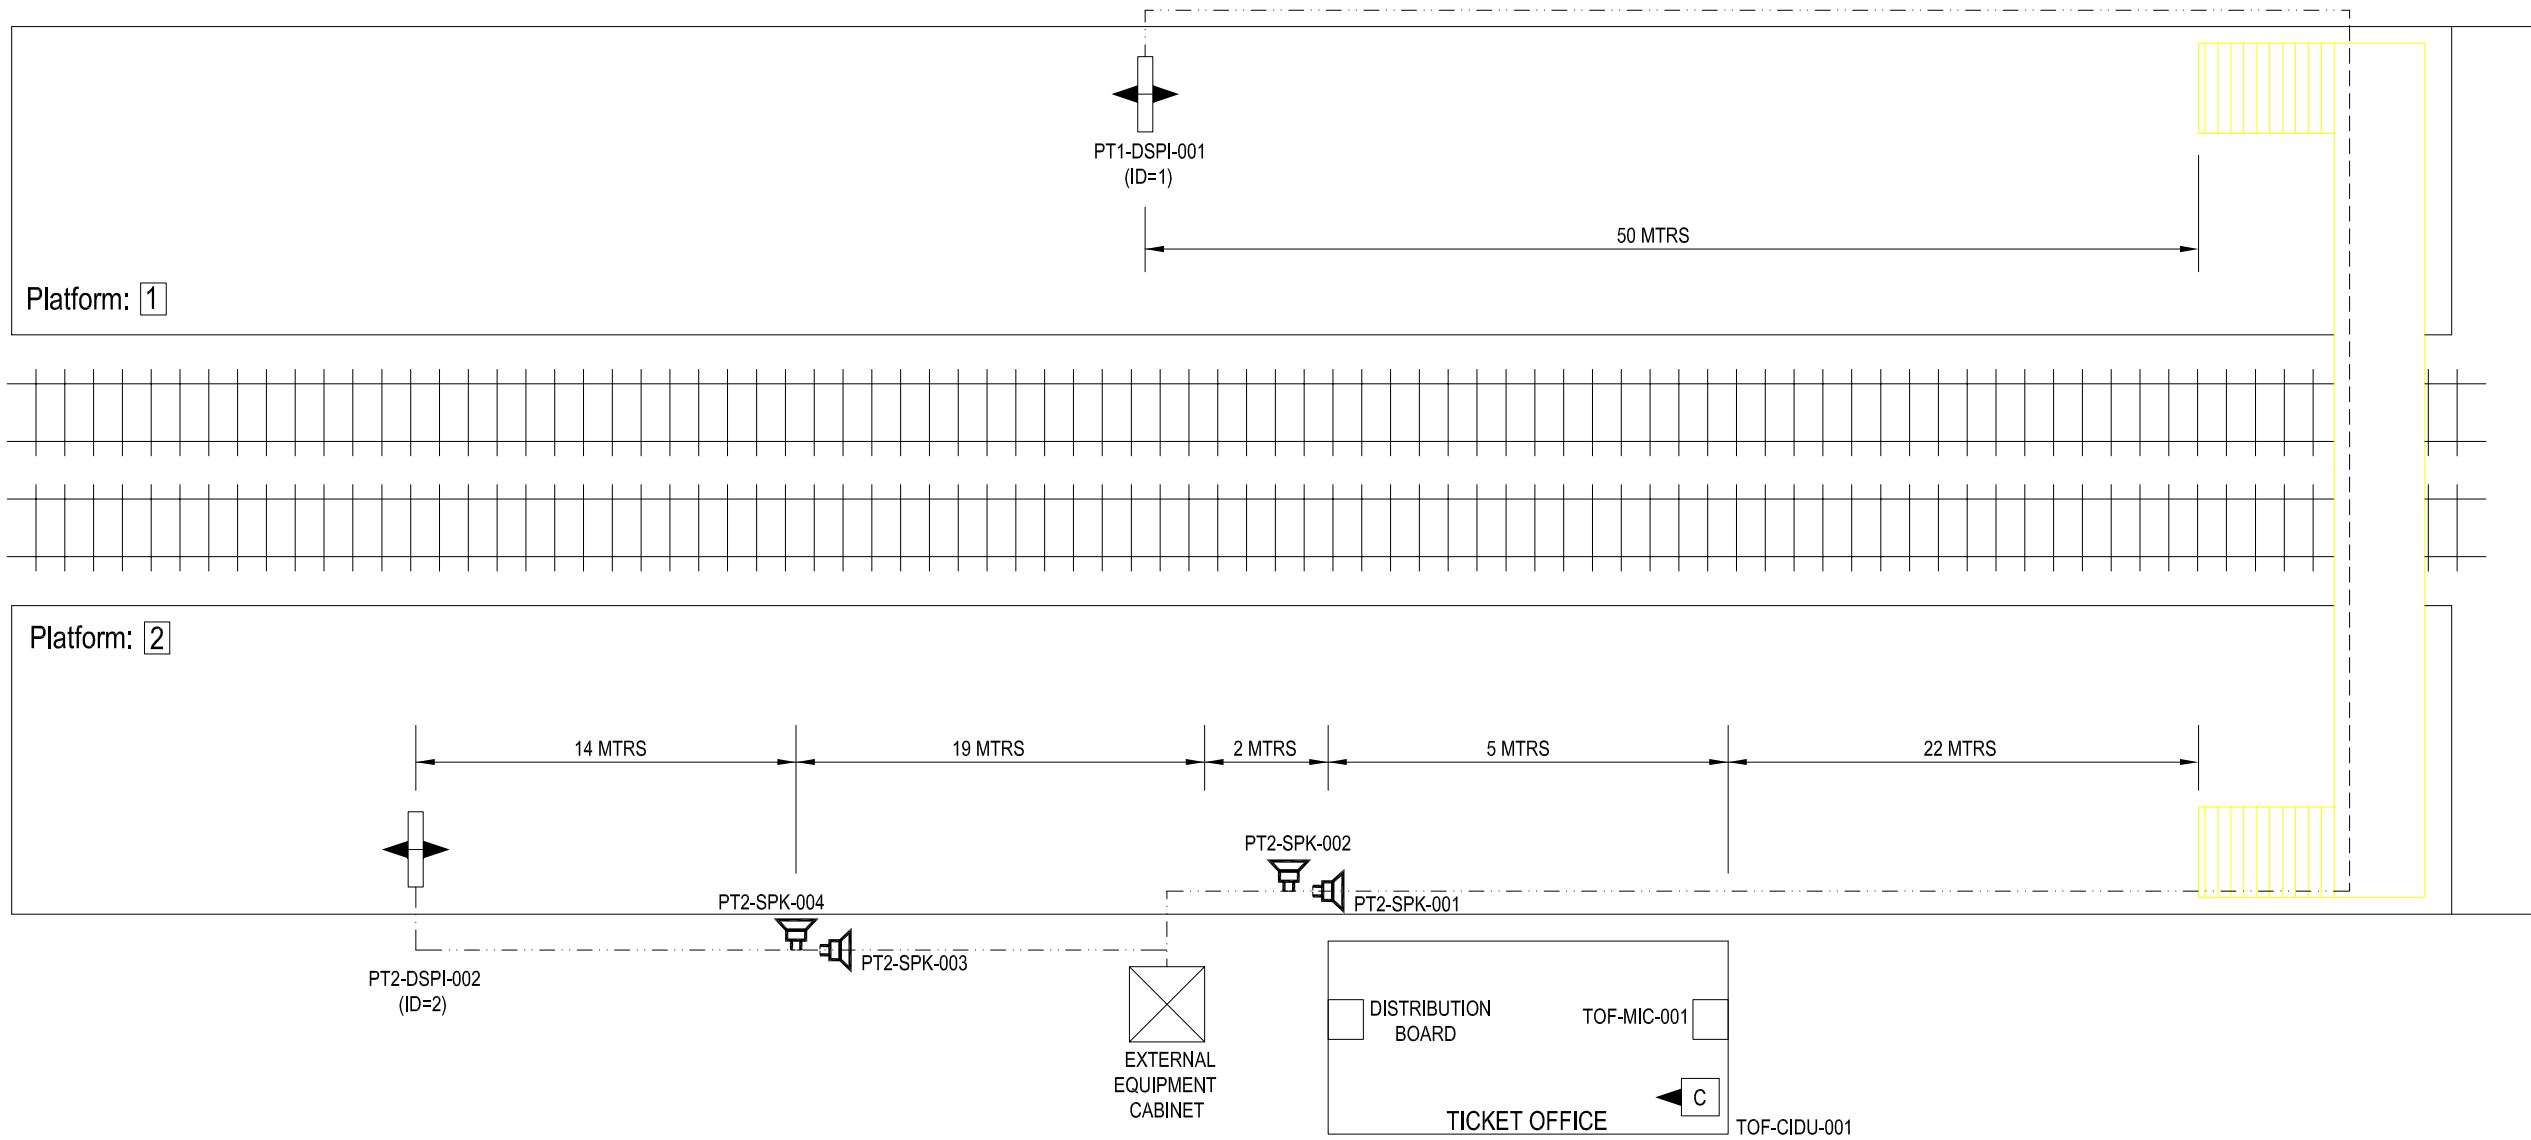

IF IN DOUBT ASK!

MATERIAL	CONSTRUCTION	<table border="1"> <thead> <tr> <th>NAME</th> <th>SIGNATURE</th> <th>DATE</th> </tr> </thead> <tbody> <tr> <td>D GADDU</td> <td></td> <td>12-03-2002</td> </tr> <tr> <td>T WONG</td> <td></td> <td>19-03-2002</td> </tr> <tr> <td></td> <td></td> <td></td> </tr> <tr> <td></td> <td></td> <td></td> </tr> </tbody> </table>	NAME	SIGNATURE	DATE	D GADDU		12-03-2002	T WONG		19-03-2002							<p>AMEY DATEL Project Offices 1st Floor, Platform 2/3 Eastleigh Station Southampton Road Eastleigh Hants SO50 9FL</p>	SITE/PROJECT		SOUTH WEST TRAINS CIS PROJECT	
		NAME	SIGNATURE	DATE																		
D GADDU		12-03-2002																				
T WONG		19-03-2002																				
FINISH			<p>TITLE</p> <p>BEDHAMPTON AS BUILT</p>	SCALE	DRG No.	ISSUE	SHEET															
				NTS	SM803-75538	B	1 of 1															

COPYRIGHT © AMEY Rail
All rights reserved. Neither this drawing or any of the information
it contains may be copied or communicated to third parties
without the written permission of the copyright holder