



WAN	
CIRCUIT ID	KXIP300418
IP ADDRESS	10.227.79.1

"PLATFORM 1 HP ISDN"
020-8568-7146
"PLATFORM 2 HP ISDN"
020-8568-7156

All Equipment tags to be prefixed with "BFD-"

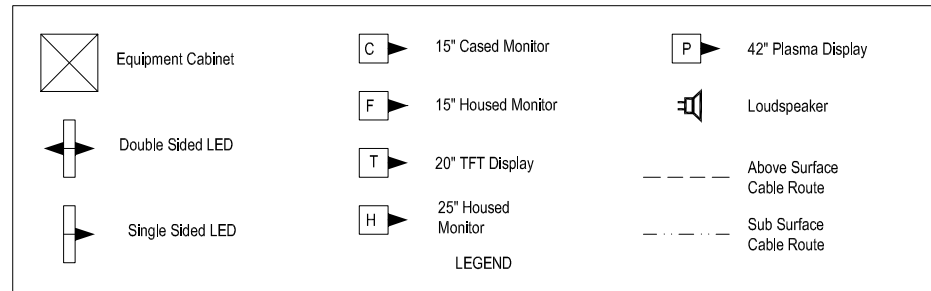

Equipment	Dist Board
CIS RACK	EXISTING POWER SUPPLIES USED
PT1-DSPI-001	
PT2-DSPI-002	

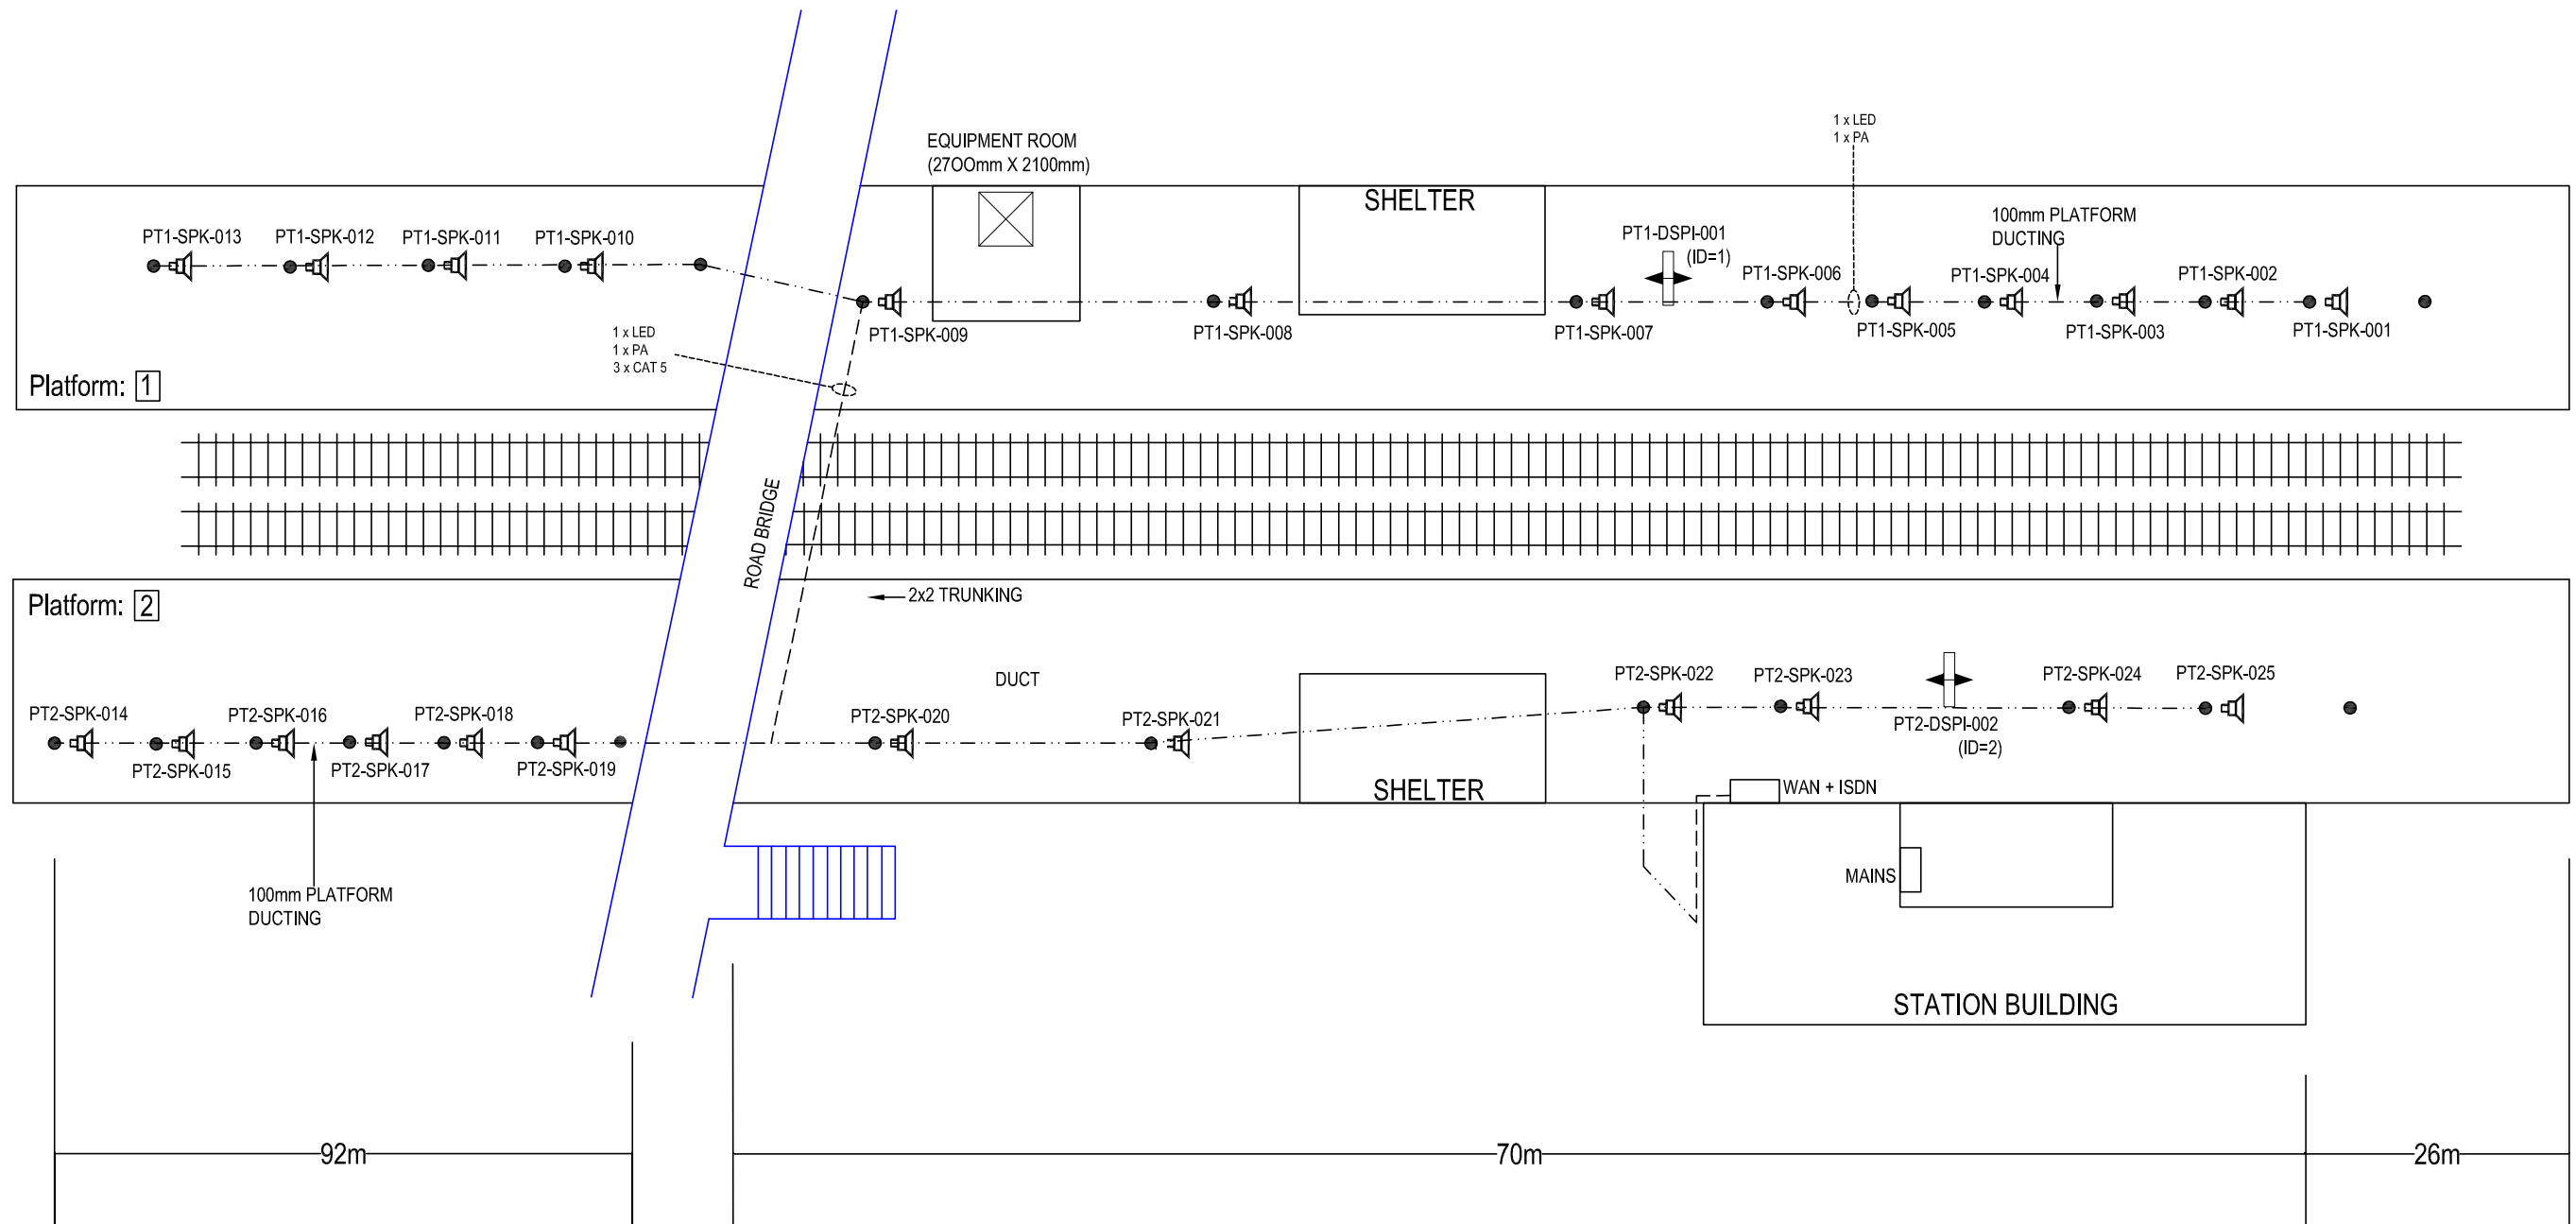

IF IN DOUBT ASK!

MATERIAL	CONSTRUCTION	<table border="1"> <thead> <tr> <th>NAME</th> <th>SIGNATURE</th> <th>DATE</th> </tr> </thead> <tbody> <tr> <td>DRAWN BY: A HATTON</td> <td></td> <td>23-04-2002</td> </tr> <tr> <td>CHECKED BY: T WONG</td> <td></td> <td></td> </tr> <tr> <td>APPD BY: A SMITH</td> <td></td> <td></td> </tr> <tr> <td>APPD BY:</td> <td></td> <td></td> </tr> </tbody> </table>			NAME	SIGNATURE	DATE	DRAWN BY: A HATTON		23-04-2002	CHECKED BY: T WONG			APPD BY: A SMITH			APPD BY:			<p>AMEY DATEL Project Offices 1st Floor, Platform 2/3 Eastleigh Station Southampton Road Eastleigh Hants SO50 9FL</p>		SITE/PROJECT	
		NAME	SIGNATURE	DATE																			
DRAWN BY: A HATTON		23-04-2002																					
CHECKED BY: T WONG																							
APPD BY: A SMITH																							
APPD BY:																							
SOUTH WEST TRAINS CIS PROJECT																							
FINISH	CONSTRUCTION	CAD Ref:			<p>COPYRIGHT © AMEY Rail All rights reserved. Neither this drawing or any of the information it contains may be copied or communicated to third parties without the written permission of the copyright holder</p>		TITLE																
		CONTRACTOR'S Ref:					BRENTFORD AS BUILT																
		SCALE		DRG No.		ISSUE	SHEET																
		NTS		SM803-75552		B	1 of 1																