



WAN	
CIRCUIT ID	KXIP800423
IP ADDRESS	10.227.77.1

"PLATFORM 1 HP ISDN"
01-932-847398
"PLATFORM 2 HP ISDN"
01-932-849720

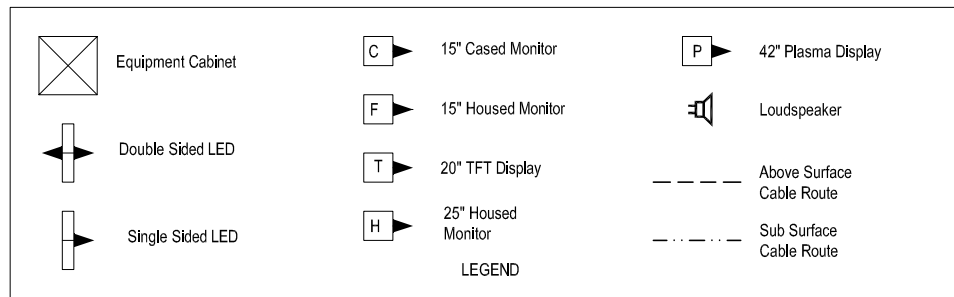

Equipment	Dist Board
TOF-CIDU-001	GP2
PT1-DSPI-001	GP1
PT2-DSPI-002	GP1

All Equipment tags to be prefixed with "BFN-"

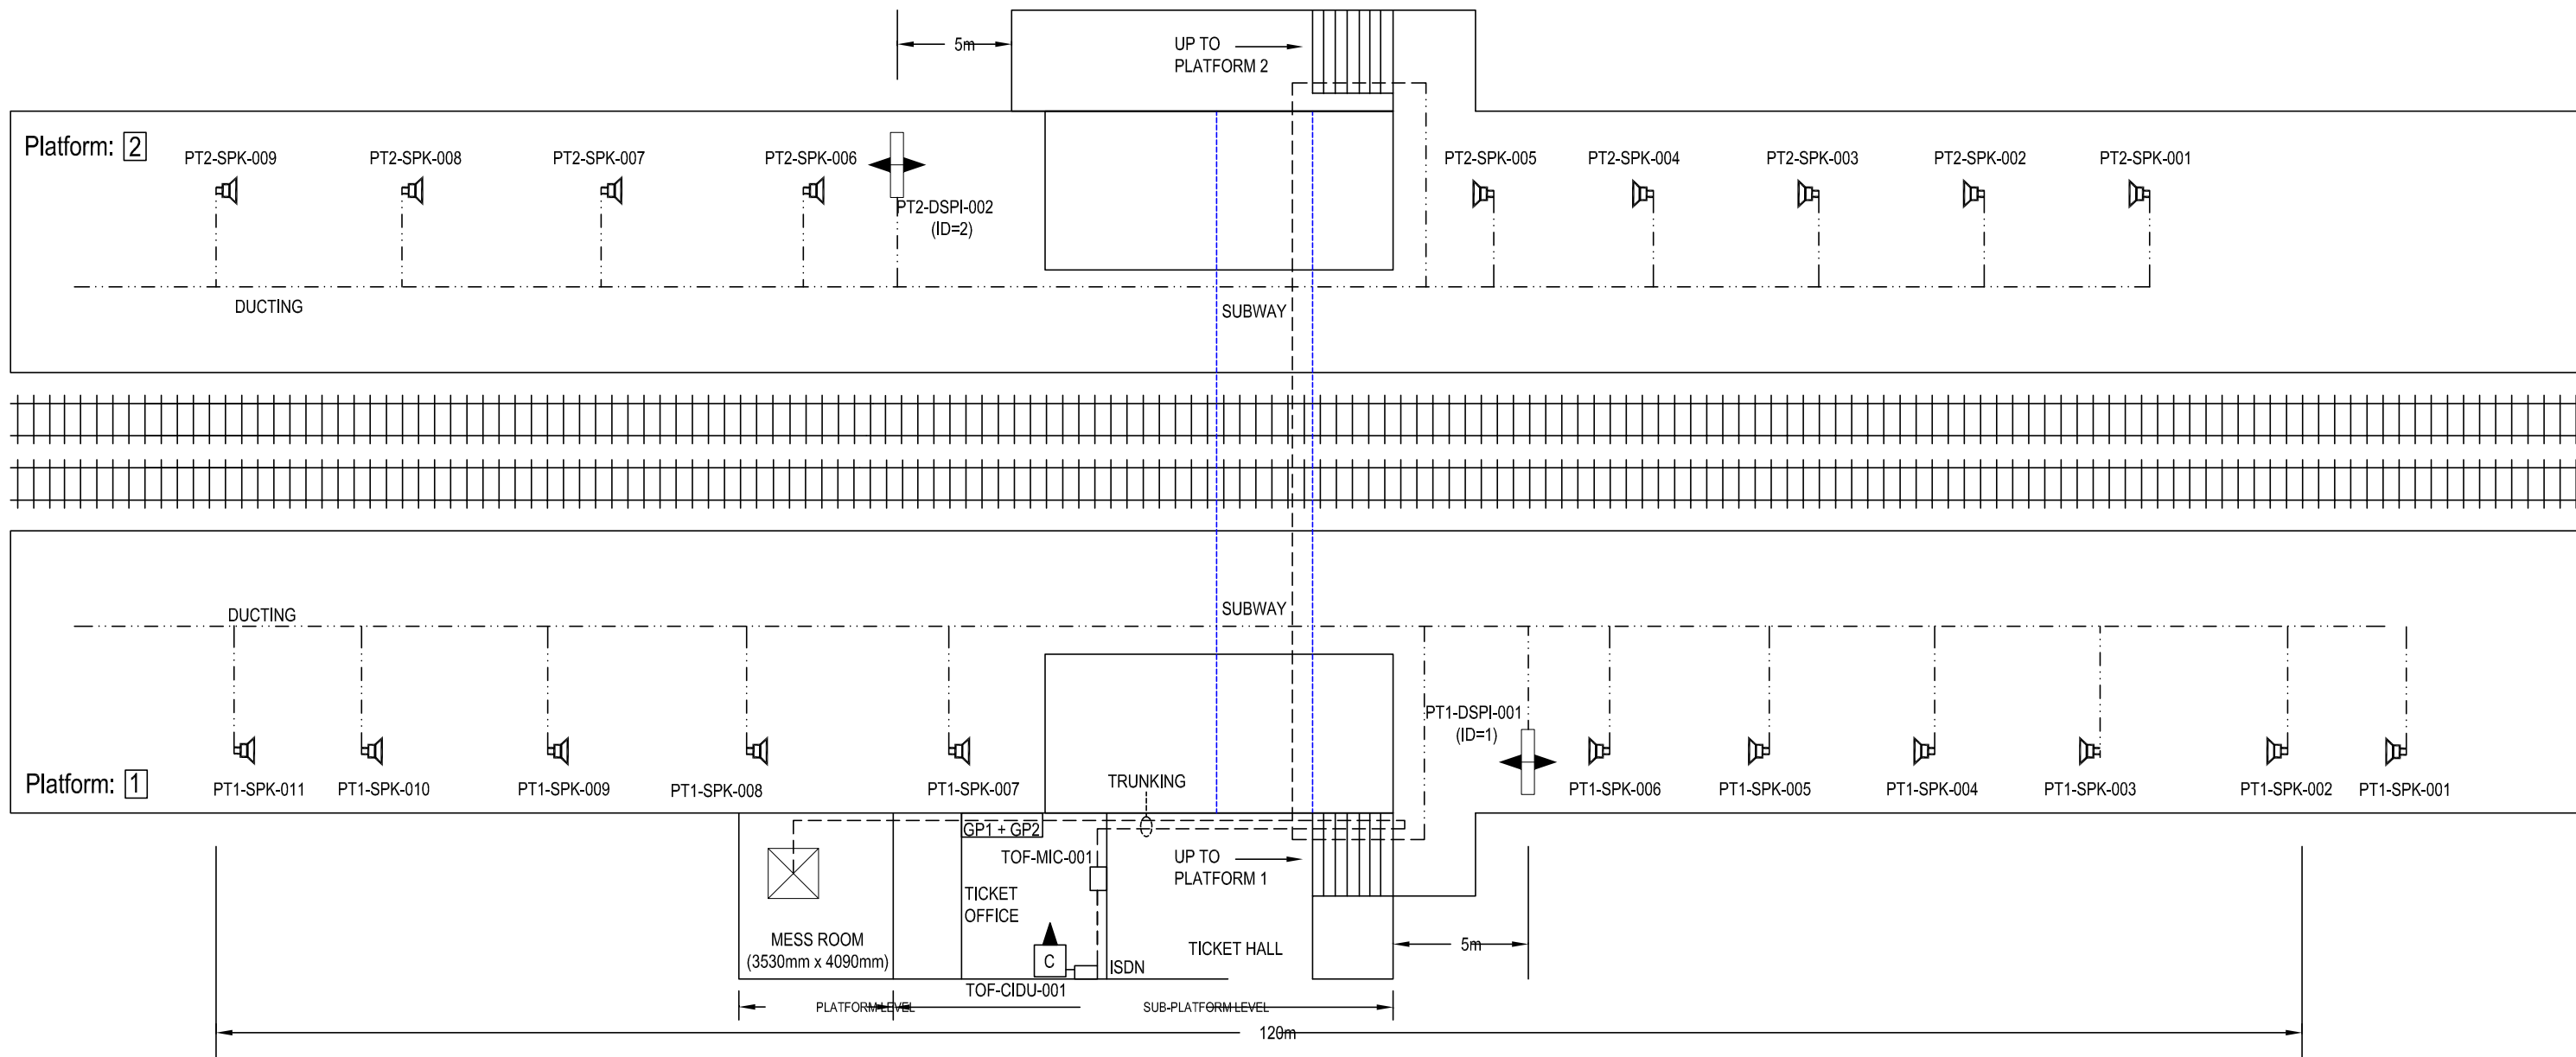

IF IN DOUBT ASK!

MATERIAL	CONSTRUCTION	NAME	SIGNATURE	DATE	<p>AMEY DATEL Project Offices 1st Floor, Platform 2/3 Eastleigh Station Southampton Road Eastleigh Hants SO50 9FL</p>	SITE/PROJECT			
		DRAWN BY	D GADDU	D GADDU		26-03-2002	SOUTH WEST TRAINS CIS PROJECT		
FINISH	CONSTRUCTION	CHECKED BY	T WONG	T WONG	19-06-2002	TITLE			
		APPD BY	A SMITH			BYFLEET & NEW HAW AS BUILT			
		CAD Ref:				SCALE	DRG No.	ISSUE	SHEET
		CONTRACTOR'S Ref:				NTS	SM803-75689	C	1 of 1

COPYRIGHT © AMEY Rail
 All rights reserved. Neither this drawing or any of the information
 it contains may be copied or communicated to third parties
 without the written permission of the copyright holder