


DRG No.

SM803-75626


WAN Details	
CIRCUIT ID	KXIP700393
IP ADDRESS	10.227.82.1

"PLATFORM 1 HP ISDN"
01-372-456178
"PLATFORM 2 HP ISDN"
01-372-457616

All Equipment tags to be prefixed with "BKA-"

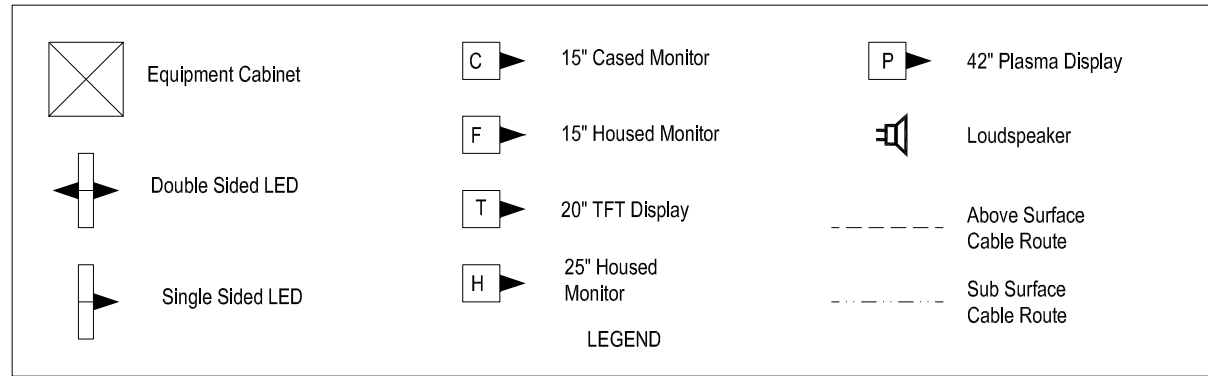

Equipment	Dist Board	
CIS RACK	IN ER ROOM	2
TH-FIDU-001	IN ER ROOM	5
PT1-DSPI-002	IN ER ROOM	4
PT2-DSPI-001	IN ER ROOM	4

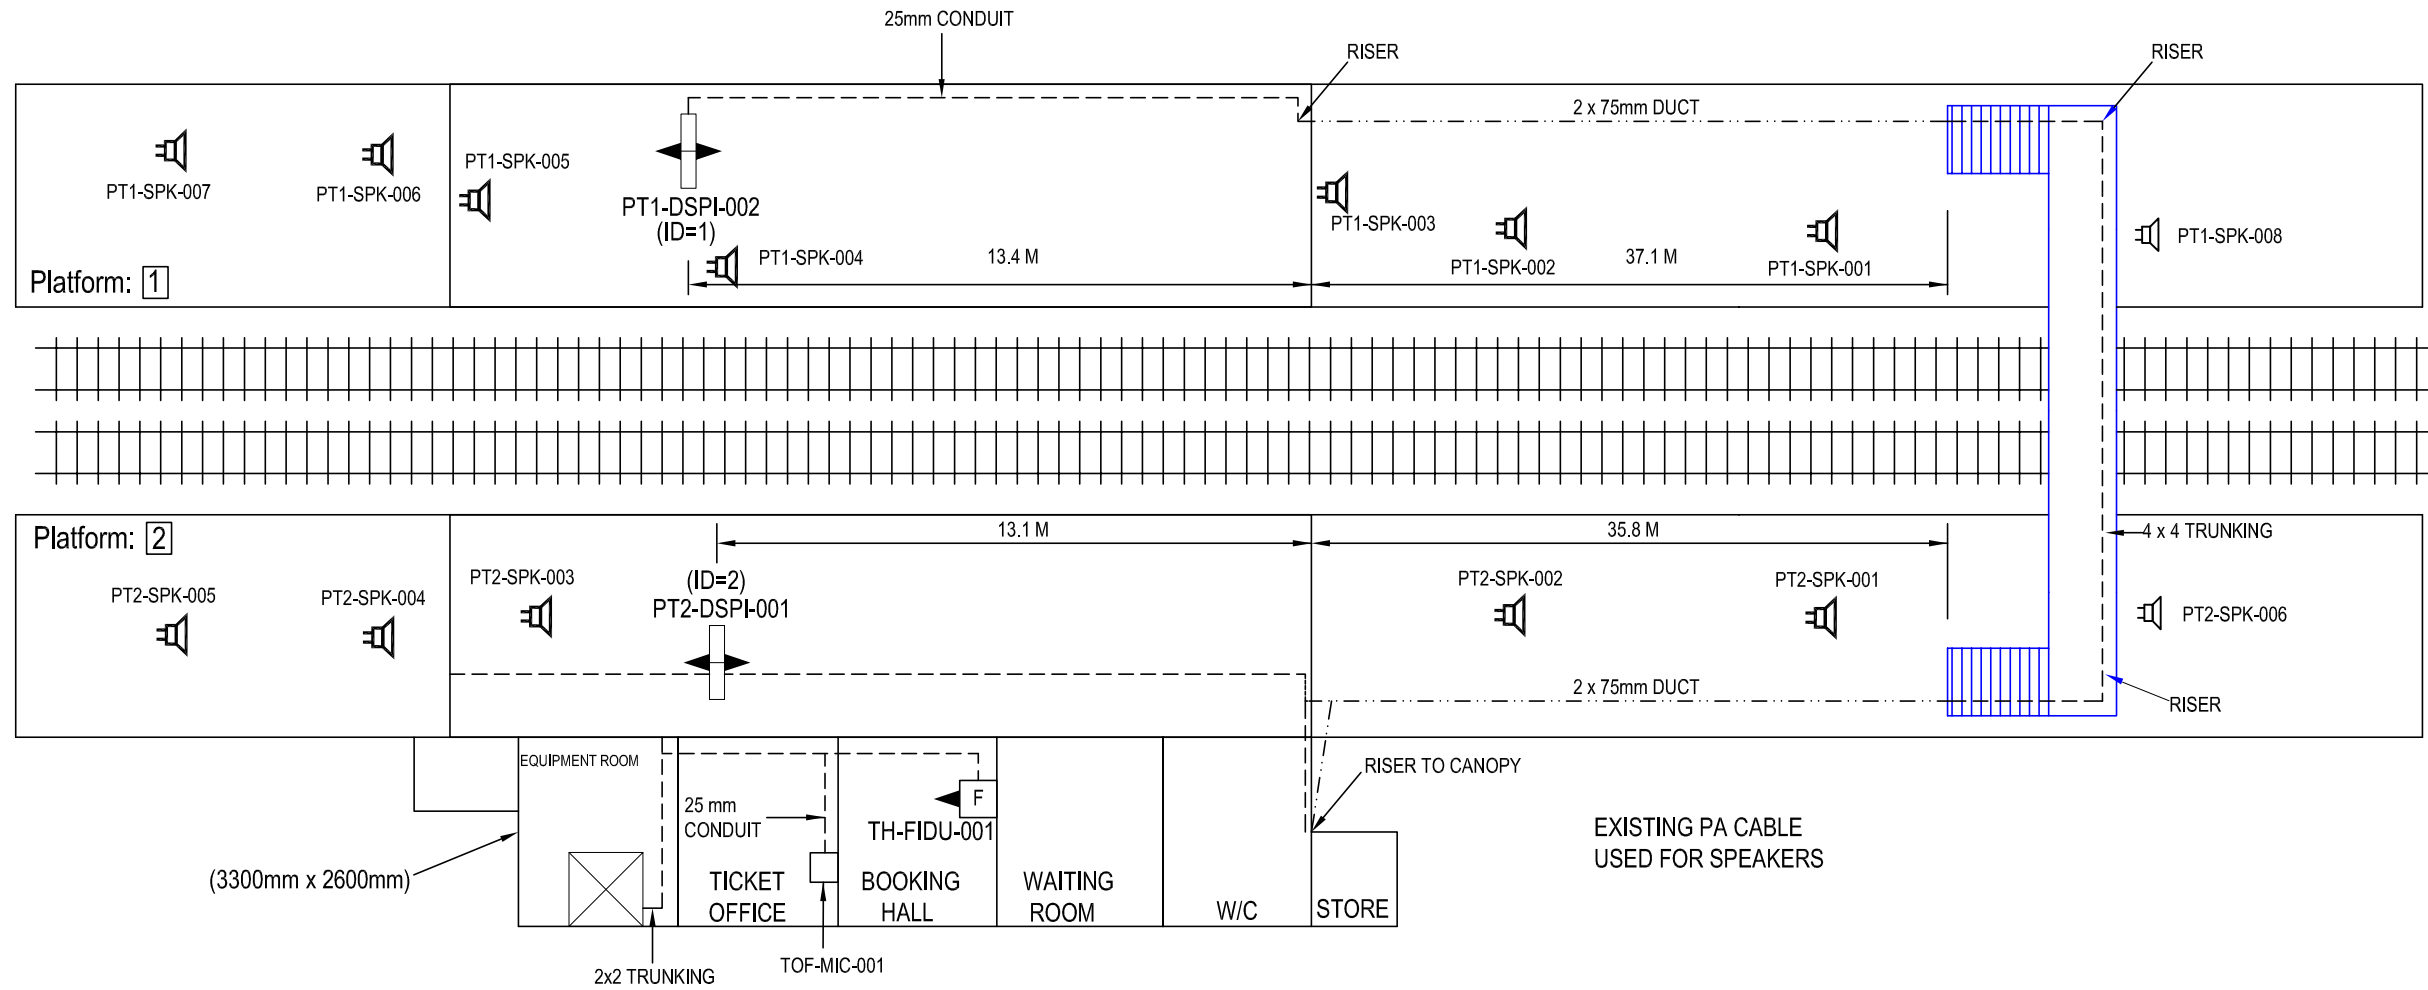

IF IN DOUBT ASK!

Date of Last Modification: 25 April 2003
 This Drawing Supersedes Any Previous Drawings

CONSTRUCTION	NAME	SIGNATURE	DATE
DRAWN BY	J STEVENS		25-04-2003
CHECKED BY	T WONG		
APPD BY	A SMITH		
APPD BY			
CAD Ref:			
CONTRACTOR'S Ref:			

AMEY DATEL Project
 Offices
 1st Floor, Platform
 2/3
 Eastleigh Station
 Southampton Road
 Eastleigh
 Hants
 SO50 9FL

SITE/PROJECT		SOUTH WEST TRAINS CIS PROJECT	
TITLE		BOOKHAM AS BUILT	
SCALE	DRG No.	ISSUE	SHEET
NTS	SM803-75626	C	1 of 1

COPYRIGHT © AMEY Rail
 All rights reserved. Neither this drawing or any of the information it contains may be copied or communicated to third parties without the written permission of the copyright holder