


DRG No. SM803-75687


WAN	
CIRCUIT ID	KXIP 100373
IP ADDRESS	10.227.39.1

"PLATFORM 1 HP ISDN"
01-483-799410
"PLATFORM 2 HP ISDN"
01-483-799441

All Equipment tags to be prefixed with "BKO-"

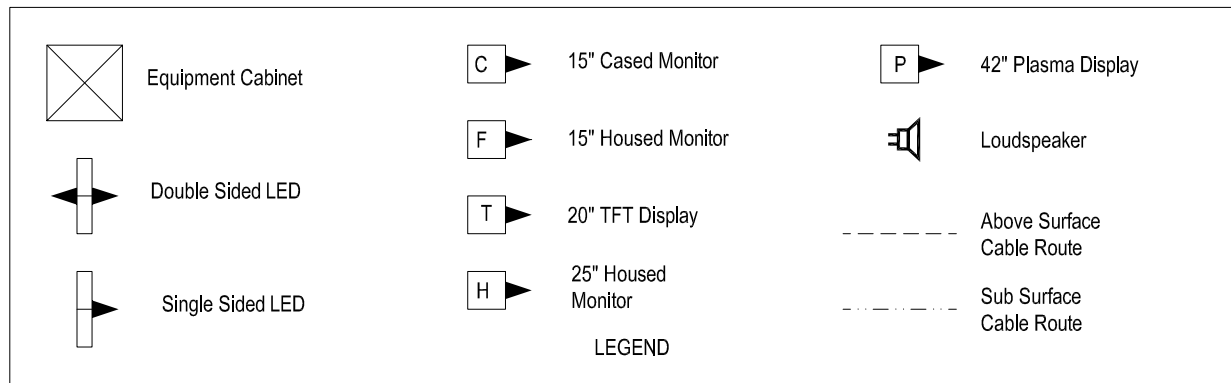


Equipment	Dist Board	
PT1-DSPI-001	DB1 CCT 13	ELEC ROOM
PT2-DSPI-002	DB1 CCT 13	BY COFFEE
BH-HIDU-001	DB CCT 2	MACHINE
TO-CIDU-002	OFF EXISTING RING	

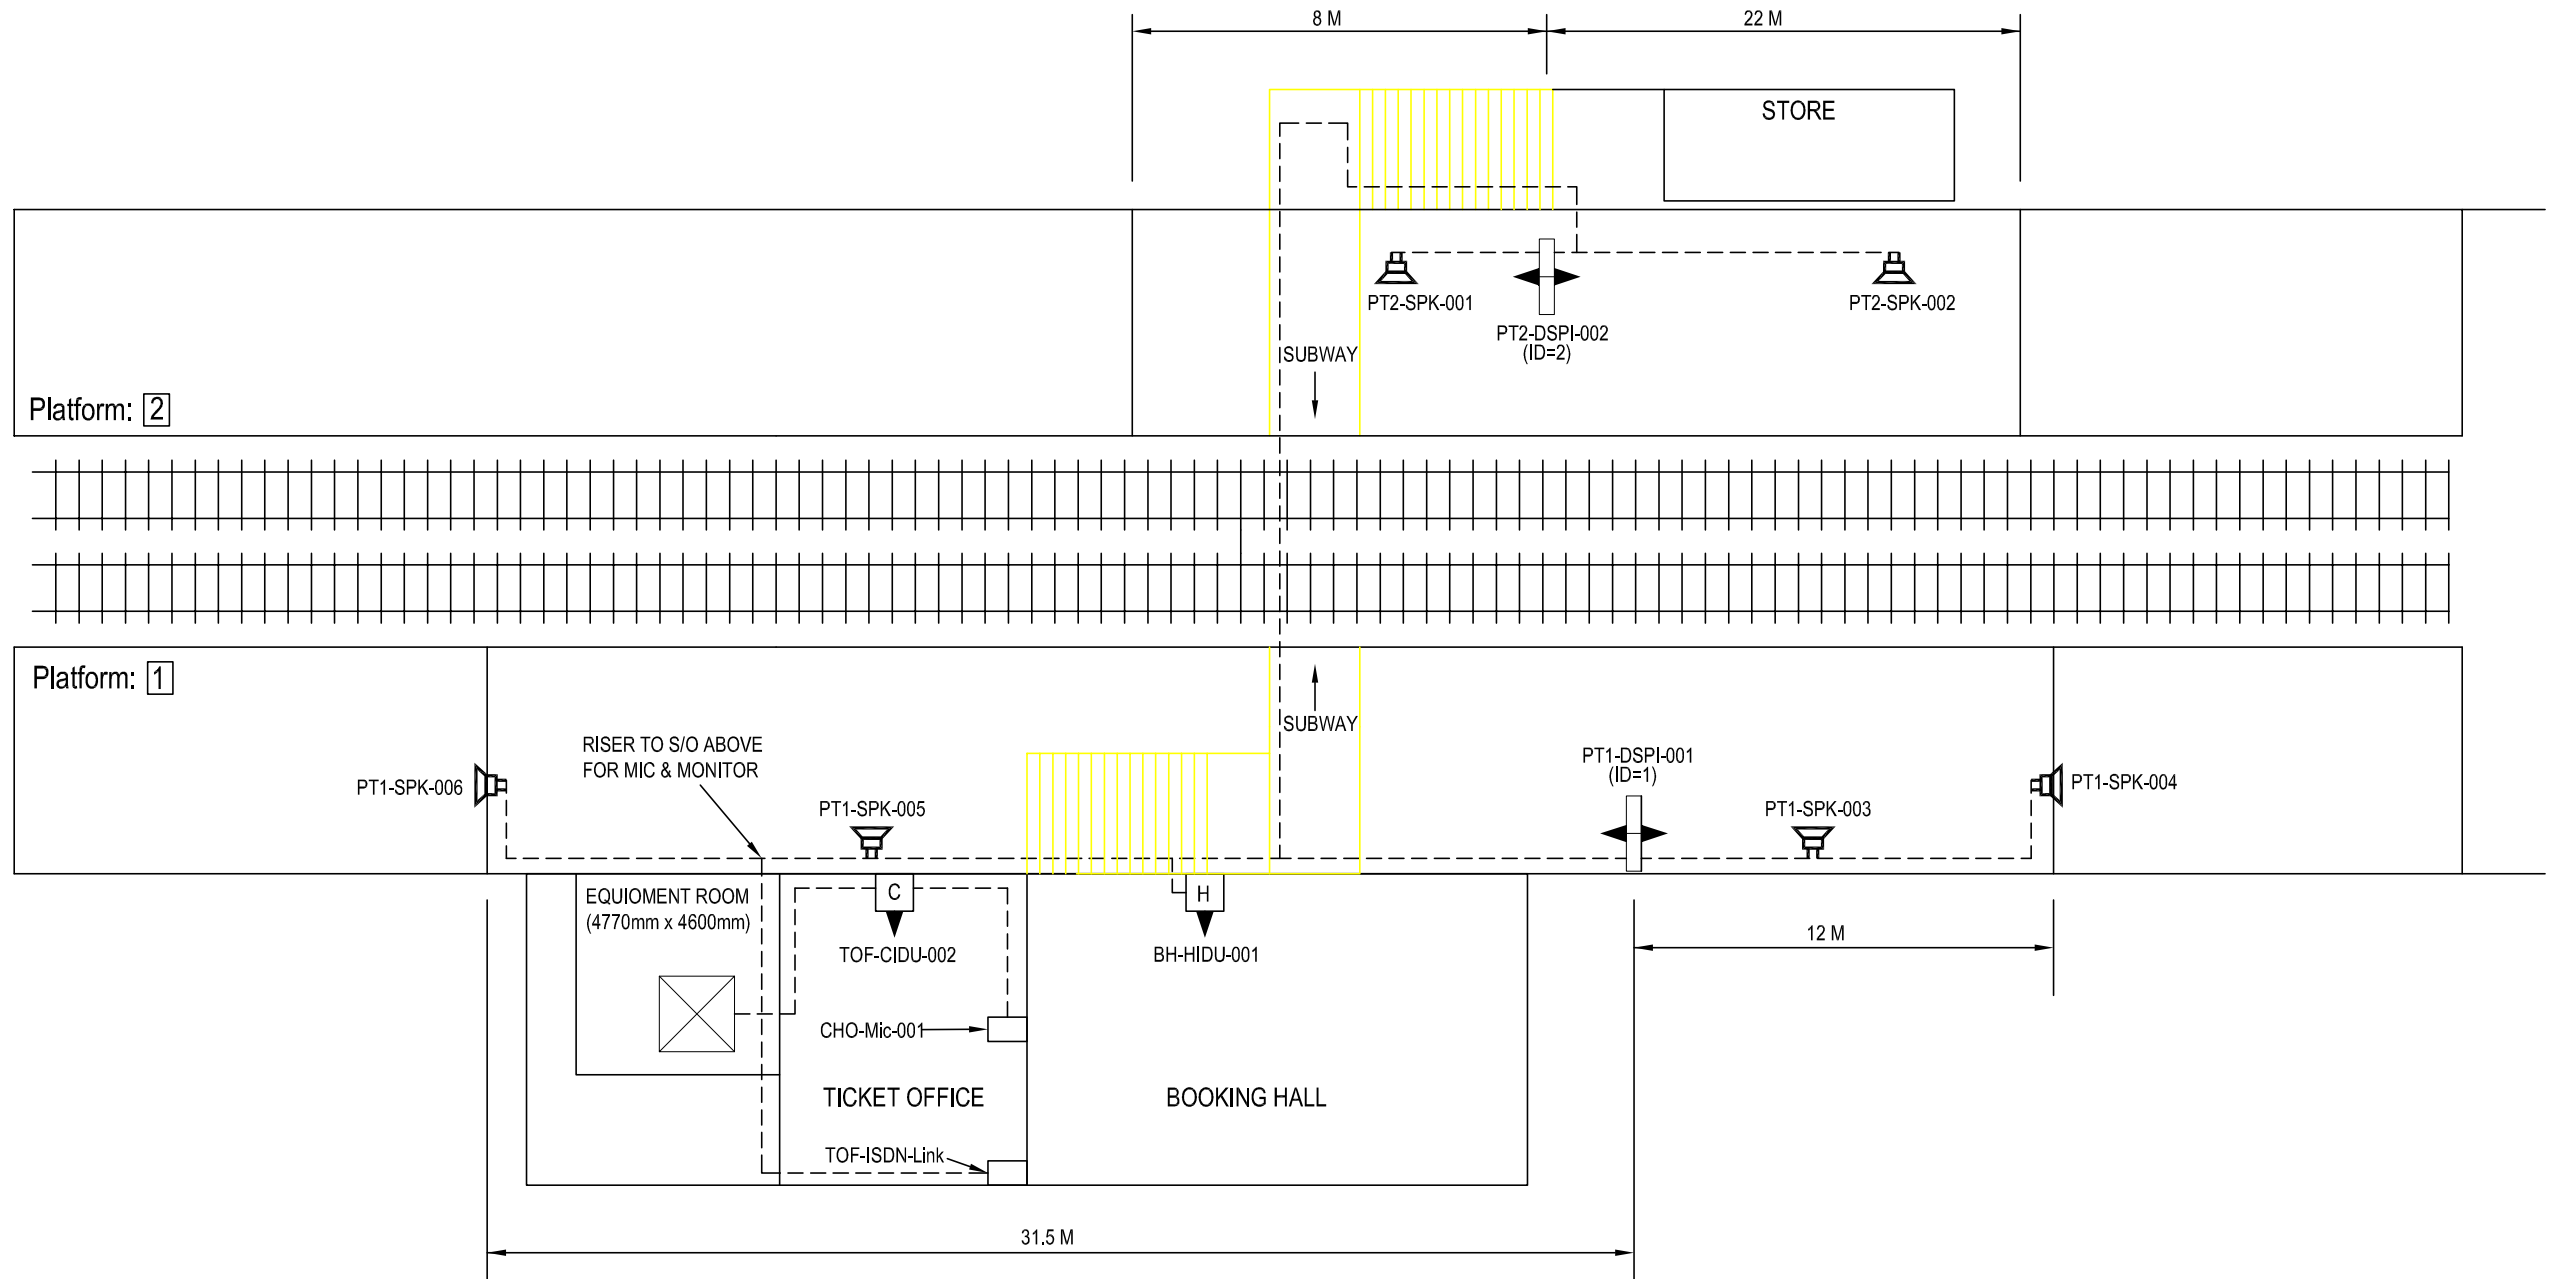

IF IN DOUBT ASK!

MATERIAL	CONSTRUCTION
FINISH	

	NAME	SIGNATURE	DATE
DRAWN BY	D GADDU		18/02/2002
CHECKED BY			
APPD BY			
APPD BY			
CAD Ref:			
CONTRACTOR'S Ref:			



AMEY DATEL Project  
 Offices  
 1st Floor, Platform  
 2/3  
 Eastleigh Station  
 Southampton Road  
 Eastleigh  
 Hants  
 SO50 9FL

COPYRIGHT © AMEY Rail  
 All rights reserved. Neither this drawing or any of the information it contains may be copied or communicated to third parties without the written permission of the copyright holder

SITE/PROJECT		SOUTH WEST TRAINS CIS PROJECT	
TITLE		BROOKWOOD AS BUILT	
SCALE	DRG No.	ISSUE	SHEET
NTS	SM803-75687	A	1 of 1