


DRG No.

SM803-75580


WAN	
CIRCUIT ID	KXIP 300406
IP ADDRESS	10.227.88.1

"PLATFORM 1 HP ISDN"
0208-8760986
"PLATFORM 2 HP ISDN"
0208-8761776

All Equipment tags to be prefixed with "BAB-"

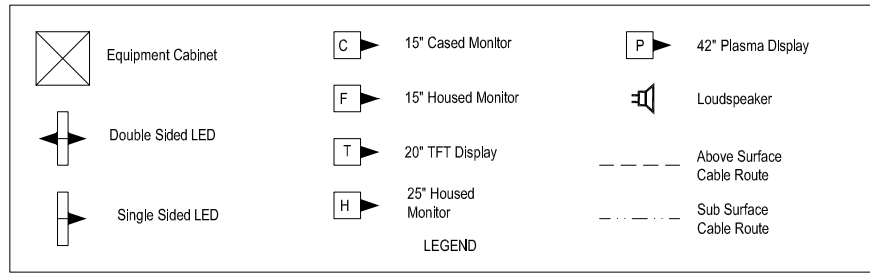

Equipment	Dist Board	Way
RACK	DB 1	WAY NO.2 20 A
CRD PLATFORM 1	DB 1	WAY NO. 13 20 A
CRD PLATFORM 2	DB 2	WAY NO.6 20 A

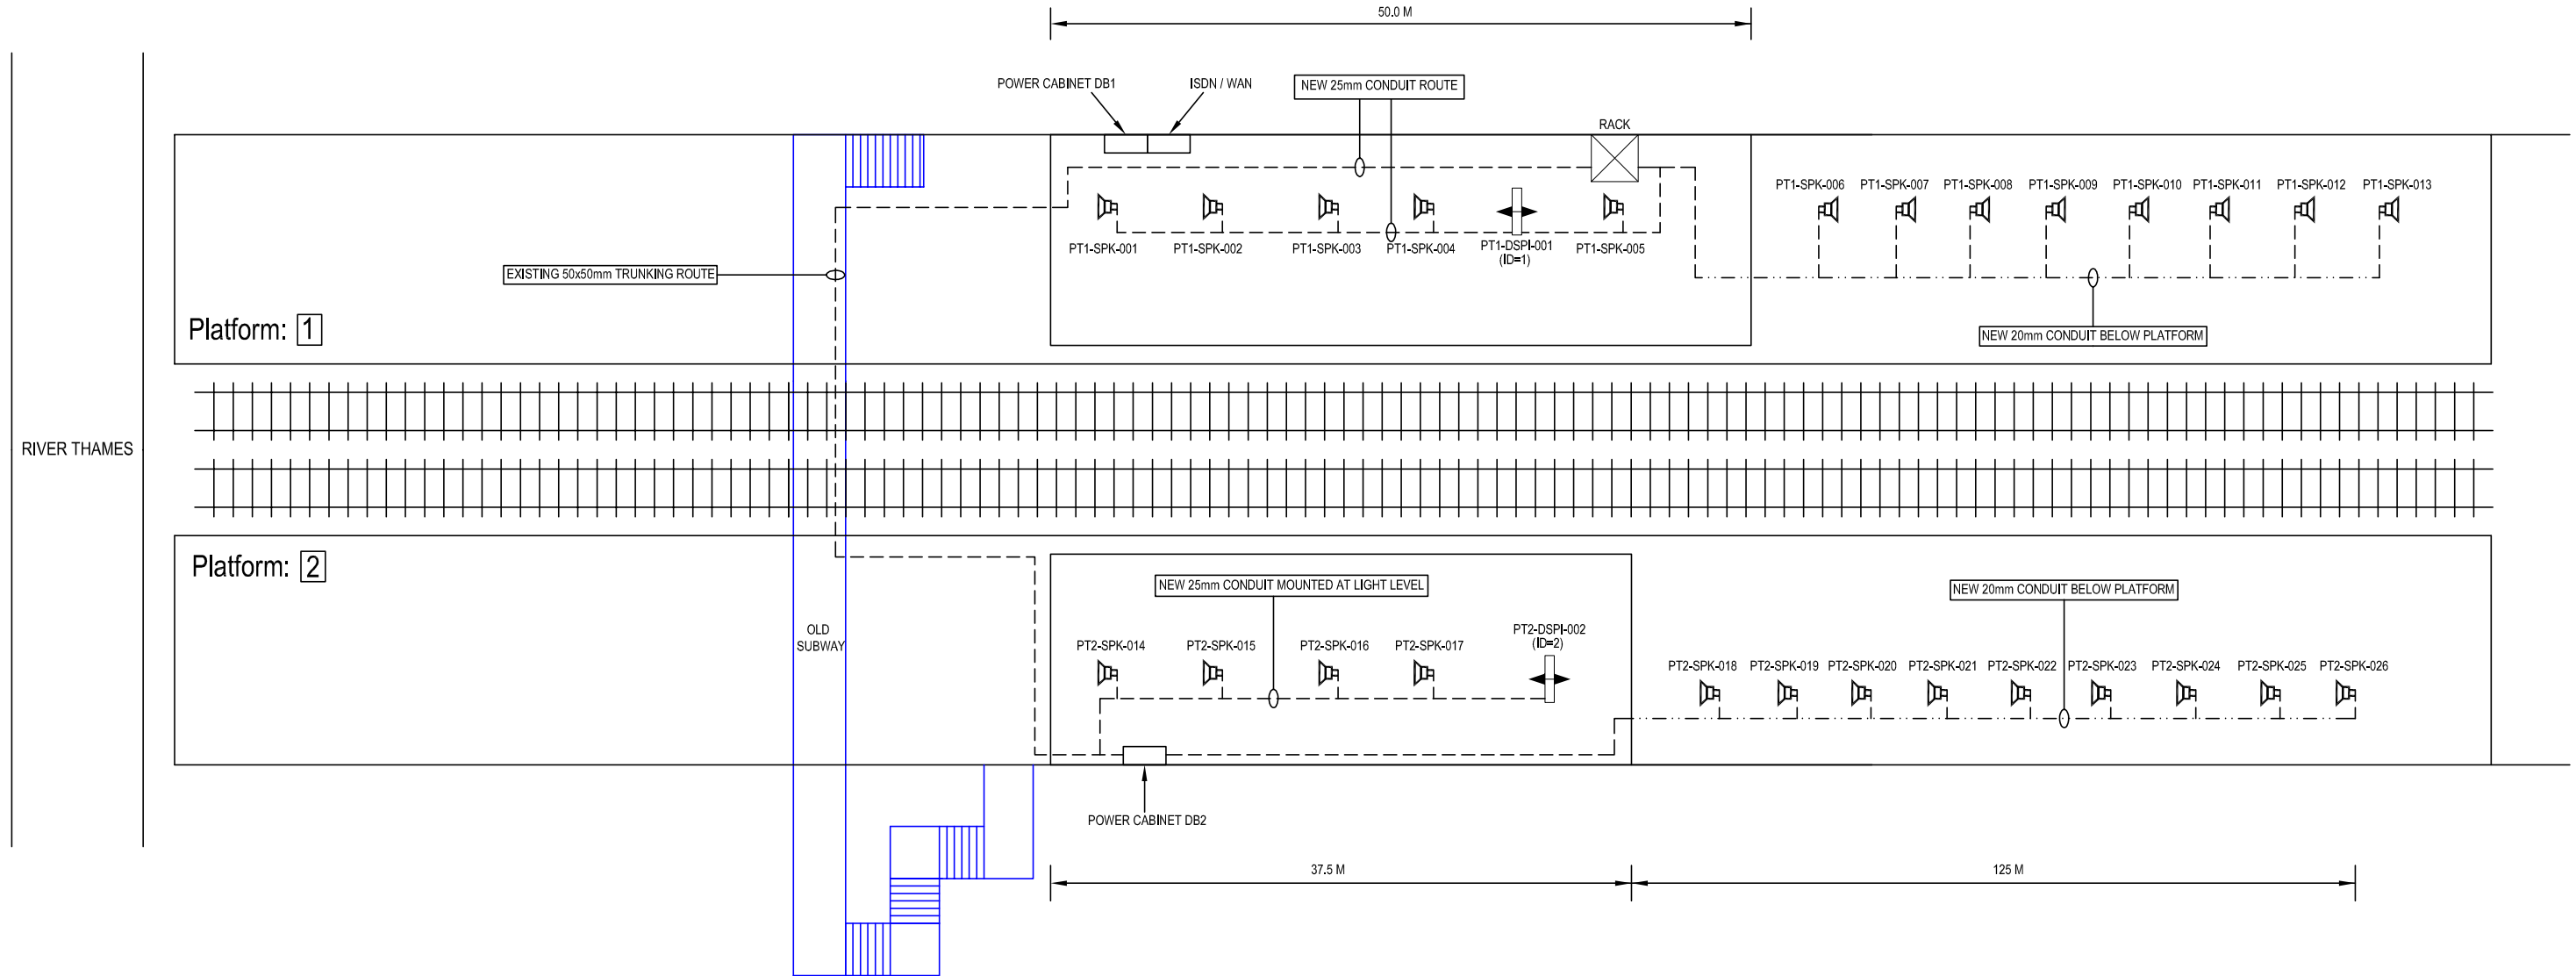

IF IN DOUBT ASK!

MATERIAL	CONSTRUCTION	NAME	SIGNATURE	DATE
		DRAWN BY	D GADDU	12-04-2002
FINISH	CONSTRUCTION	CHECKED BY	T WONG	
		APPD BY	A SMITH	
		APPD BY		
		CAD Ref:		
		CONTRACTOR'S Ref:		



AMEY DATEL Project  
 Offices  
 1st Floor, Platform  
 2/3  
 Eastleigh Station  
 Southampton Road  
 Eastleigh  
 Hants  
 SO50 9FL

COPYRIGHT © AMEY Rail  
 All rights reserved. Neither this drawing or any of the information  
 it contains may be copied or communicated to third parties  
 without the written permission of the copyright holder

SITE/PROJECT		SOUTH WEST TRAINS CIS PROJECT	
TITLE		BARNES BRIDGE AS BUILT	
SCALE	DRG No.	ISSUE	SHEET
NTS	SM803-75580	B	1 of 1