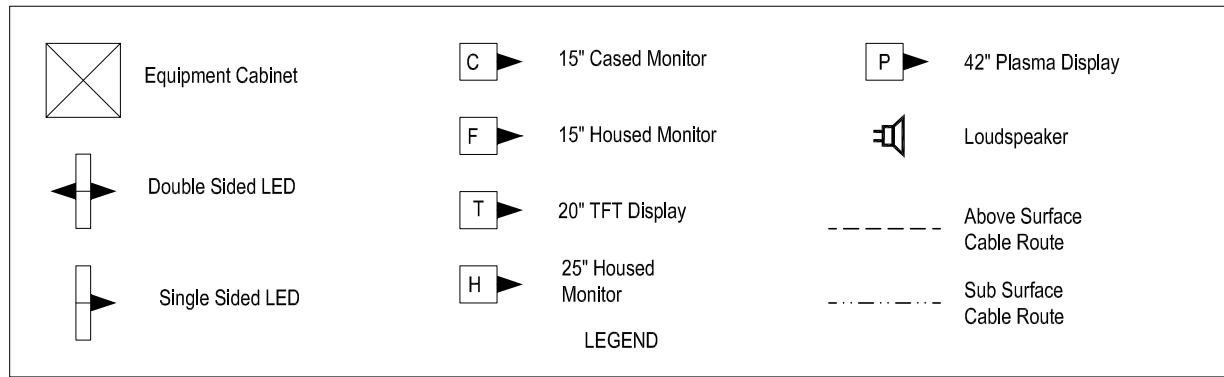


DRG No. SM803-75551


WAN	
CIRCUIT ID	KXIP 600369
IP ADDRESS	10.227.117.1

"PLATFORM 4 HP ISDN"
0208-8674217
"PLATFORM 4 HP ISDN"
0208-8672782
"PLATFORM 4 HP ISDN"
0208-8674397




Equipment	Dist Board
	EXISTING SUPPLIES USED

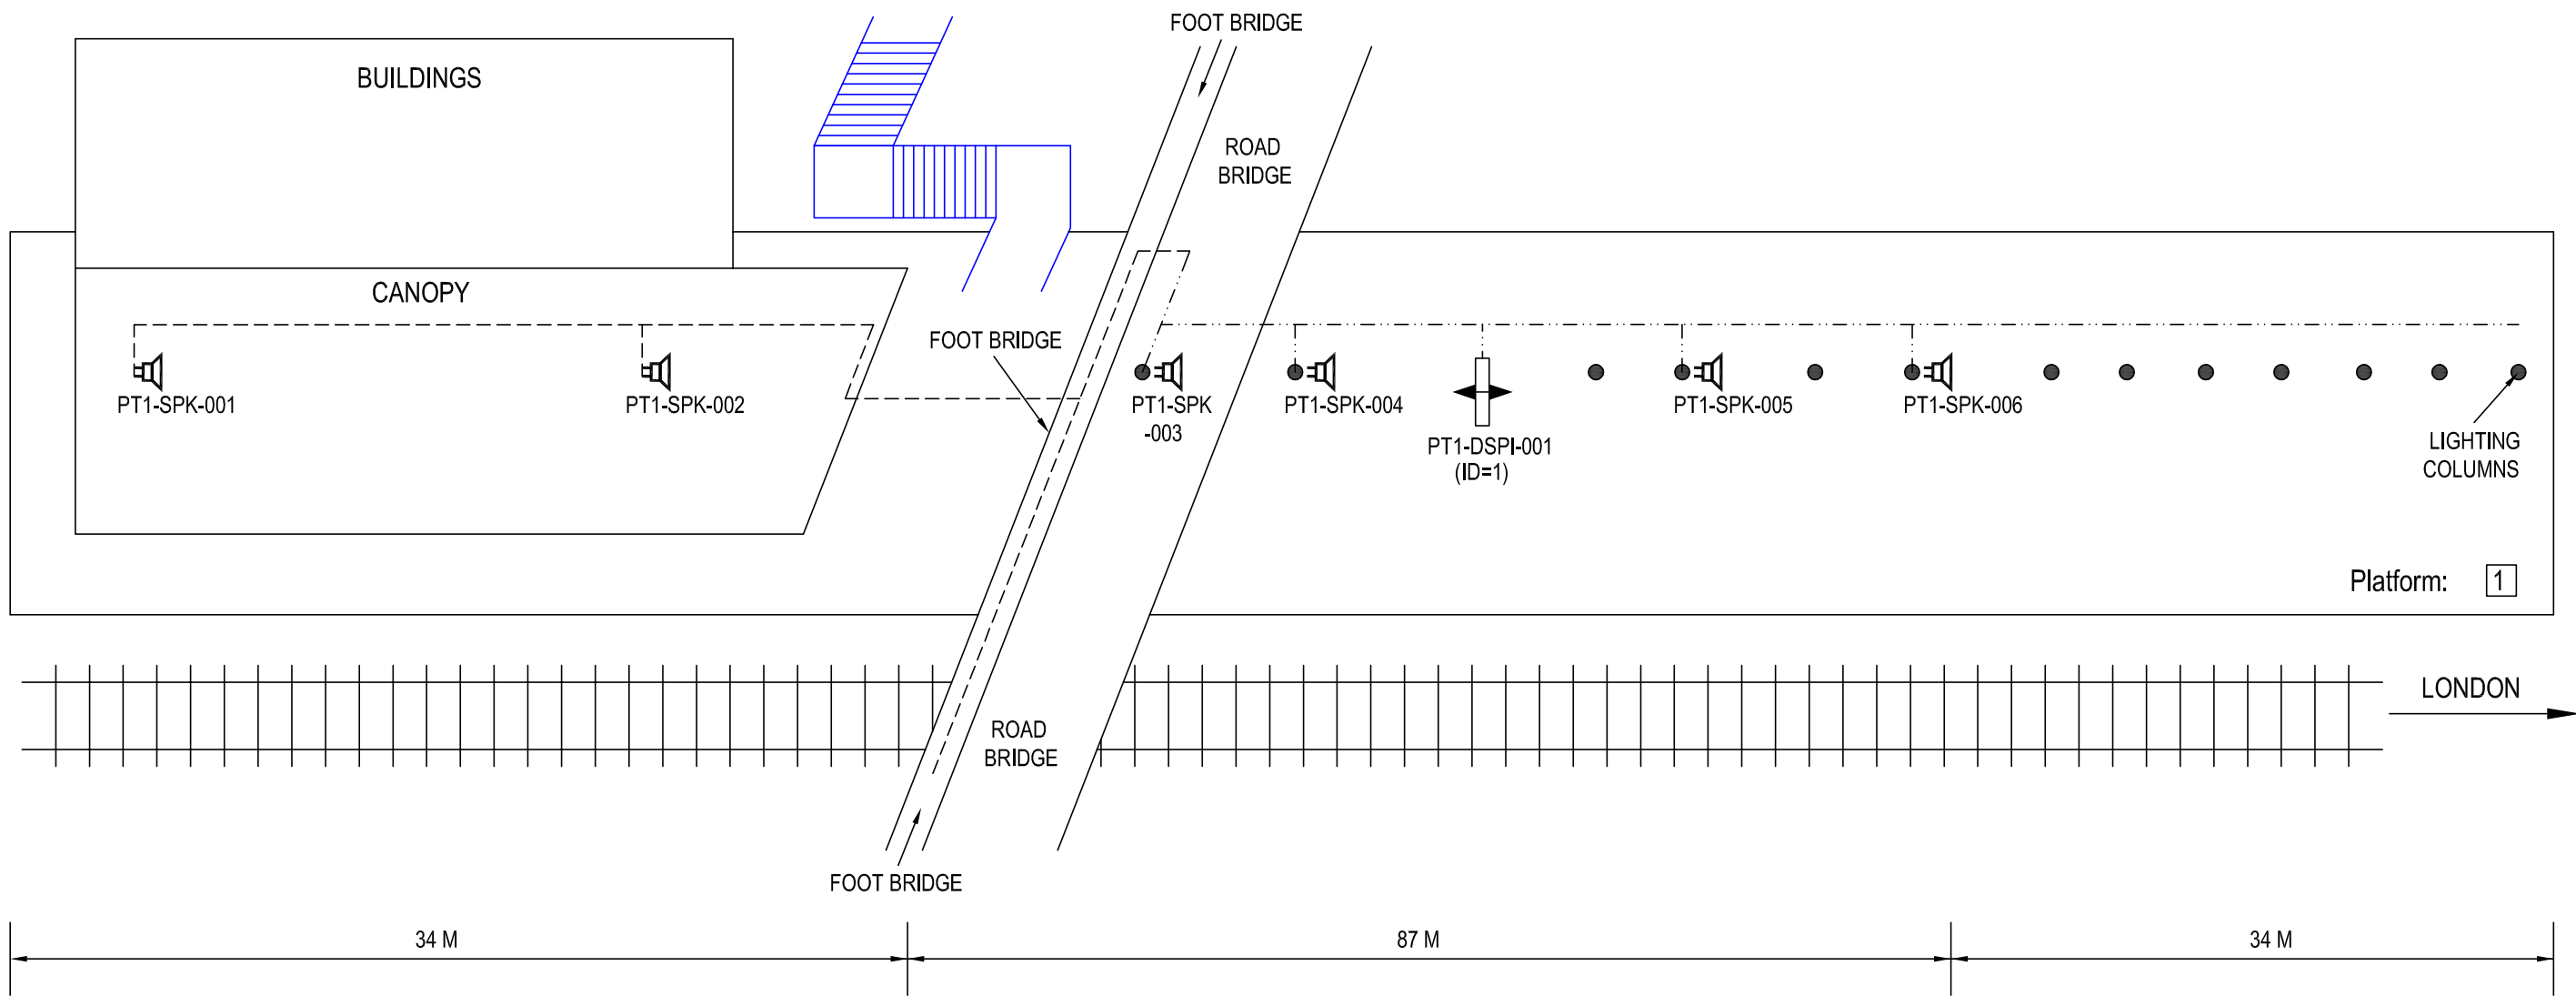All Equipment tags to be prefixed with "BNS-"



MATERIAL	CONSTRUCTION	NAME	SIGNATURE	DATE
		DATE		
FINISH		DRAWN BY	D GADDU	05-03-2002
		CHECKED BY	T WONG	
		APPD BY	A SMITH	
		APPD BY		
		CAD Ref:		
		CONTRACTOR'S Ref:		

IF IN DOUBT ASK!



AMEY DATEL Project
 Offices
 1st Floor, Platform
 2/3
 Eastleigh Station
 Southampton Road
 Eastleigh
 Hants
 SO50 9FL


COPYRIGHT © AMEY Rail
 All rights reserved. Neither this drawing or any of the information
 it contains may be copied or communicated to third parties
 without the written permission of the copyright holder

SITE/PROJECT		SOUTH WEST TRAINS CIS PROJECT	
TITLE		BARNES STATION PLATFORM 1 AS BUILT	
SCALE	DRG No.	ISSUE	SHEET
NTS	SM803-75551	B	1 of 3

SM803-75884



WAN	
CIRCUIT ID	KXIP 600369
IP ADDRESS	10.227.117.1

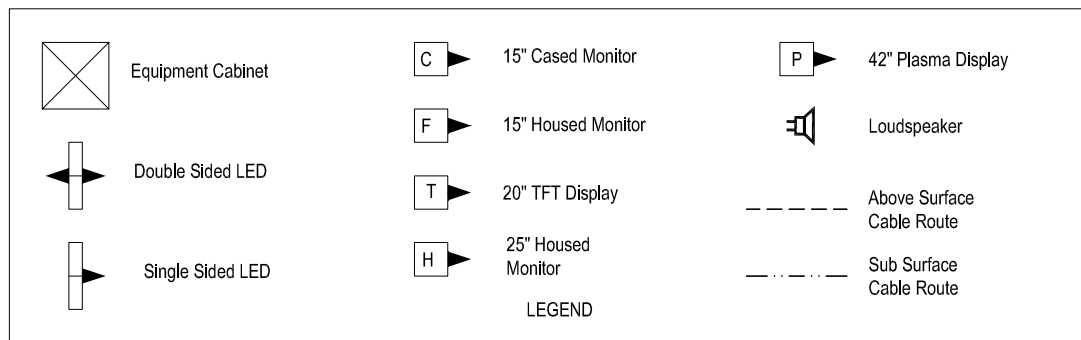"PLATFORM 4 HP ISDN"
0208-8674217
"PLATFORM 4 HP ISDN"
0208-8672782
"PLATFORM 4 HP ISDN"
0208-8674397



Equipment	Dist Board
	EXISTING SUPPLIES USED

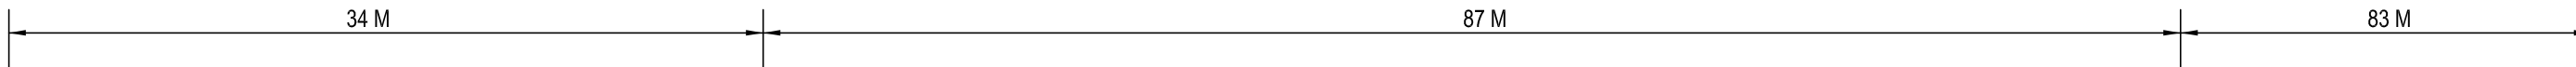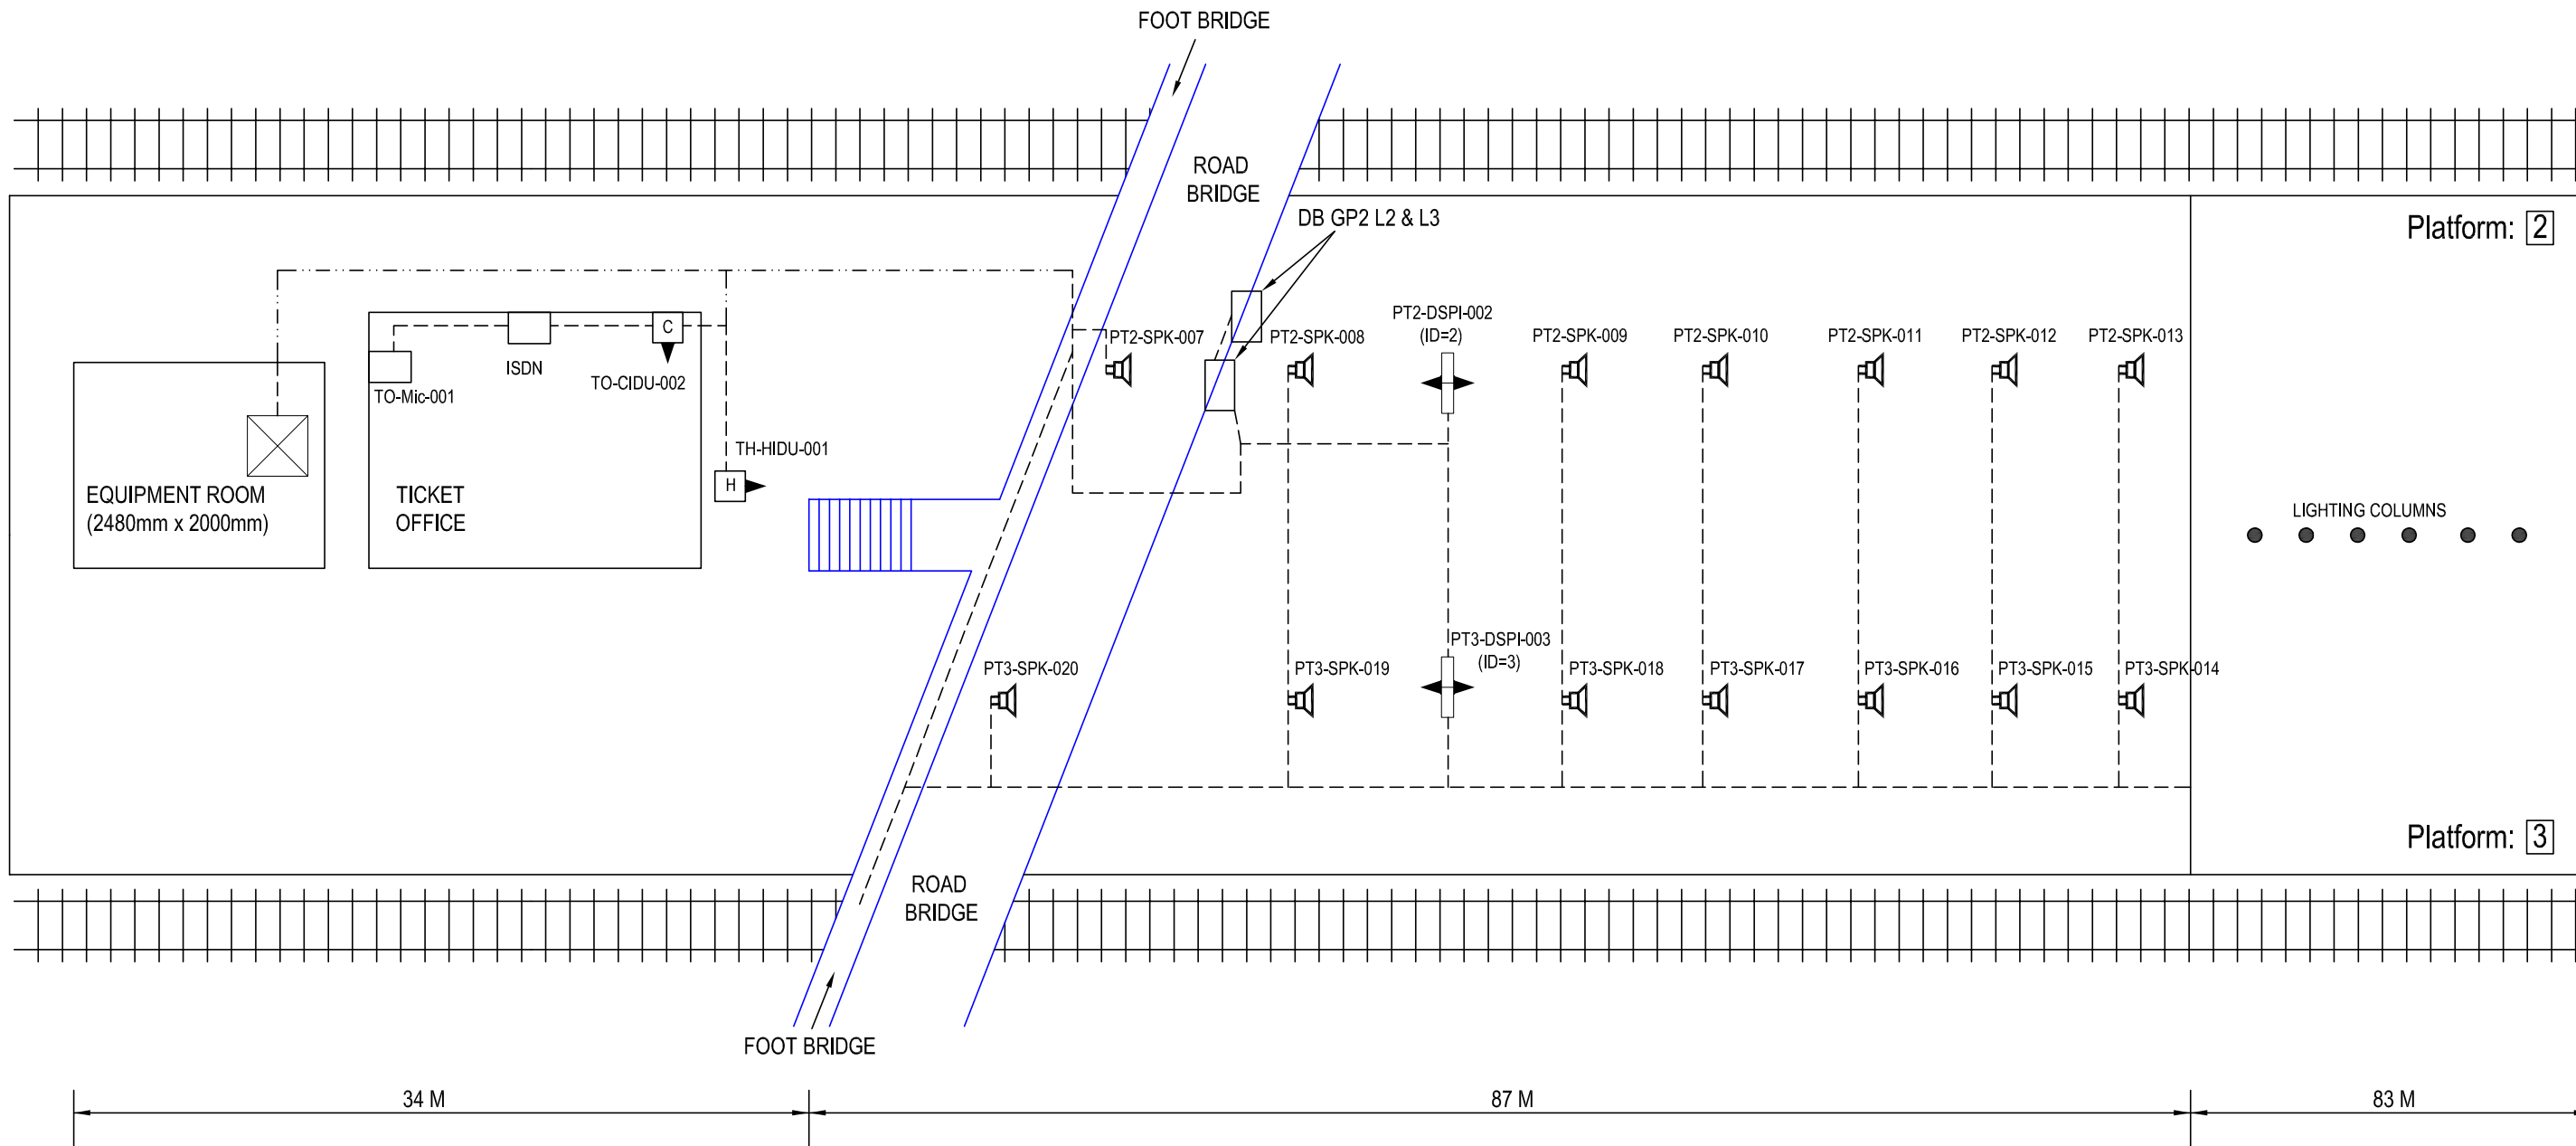All Equipment tags to be prefixed with "BNS-"



IF IN DOUBT ASK!












MATERIAL	CONSTRUCTION	<table border="1"> <tr> <th>NAME</th> <th>SIGNATURE</th> <th>DATE</th> </tr> <tr> <td>D GADDU</td> <td></td> <td>05-03-2002</td> </tr> <tr> <td>T WONG</td> <td></td> <td></td> </tr> <tr> <td>A SMITH</td> <td></td> <td></td> </tr> </table>	NAME	SIGNATURE	DATE	D GADDU		05-03-2002	T WONG			A SMITH			<p>AMEY DATEL Project Offices 1st Floor, Platform 2/3 Eastleigh Station Southampton Road Eastleigh Hants SO50 9FL</p>	SITE/PROJECT SOUTH WEST TRAINS CIS PROJECT	
		NAME	SIGNATURE	DATE													
D GADDU		05-03-2002															
T WONG																	
A SMITH																	
FINISH			TITLE BARNES STATION PLATFORMS 2 & 3 AS BUILT														
		CAD Ref:	<p>COPYRIGHT © AMEY Rail All rights reserved. Neither this drawing or any of the information it contains may be copied or communicated to third parties without the written permission of the copyright holder</p>	SCALE NTS	DRG No. SM803-75884												
		CONTRACTOR'S Ref:		ISSUE B	SHEET 2 of 3												

DRG No.

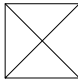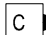SM803-75551


WAN	
CIRCUIT ID	KXIP 600369
IP ADDRESS	10.227.117.1

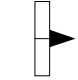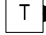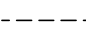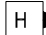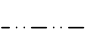"PLATFORM 4 HP ISDN"
0208-8674217
"PLATFORM 4 HP ISDN"
0208-8672782
"PLATFORM 4 HP ISDN"
0208-8674397

 Equipment Cabinet	 15" Cased Monitor	 42" Plasma Display
 Double Sided LED	 15" Housed Monitor	 Loudspeaker
 Single Sided LED	 20" TFT Display	 Above Surface Cable Route
	 25" Housed Monitor	 Sub Surface Cable Route
	LEGEND	

Equipment	Dist Board
	EXISTING SUPPLIES USED

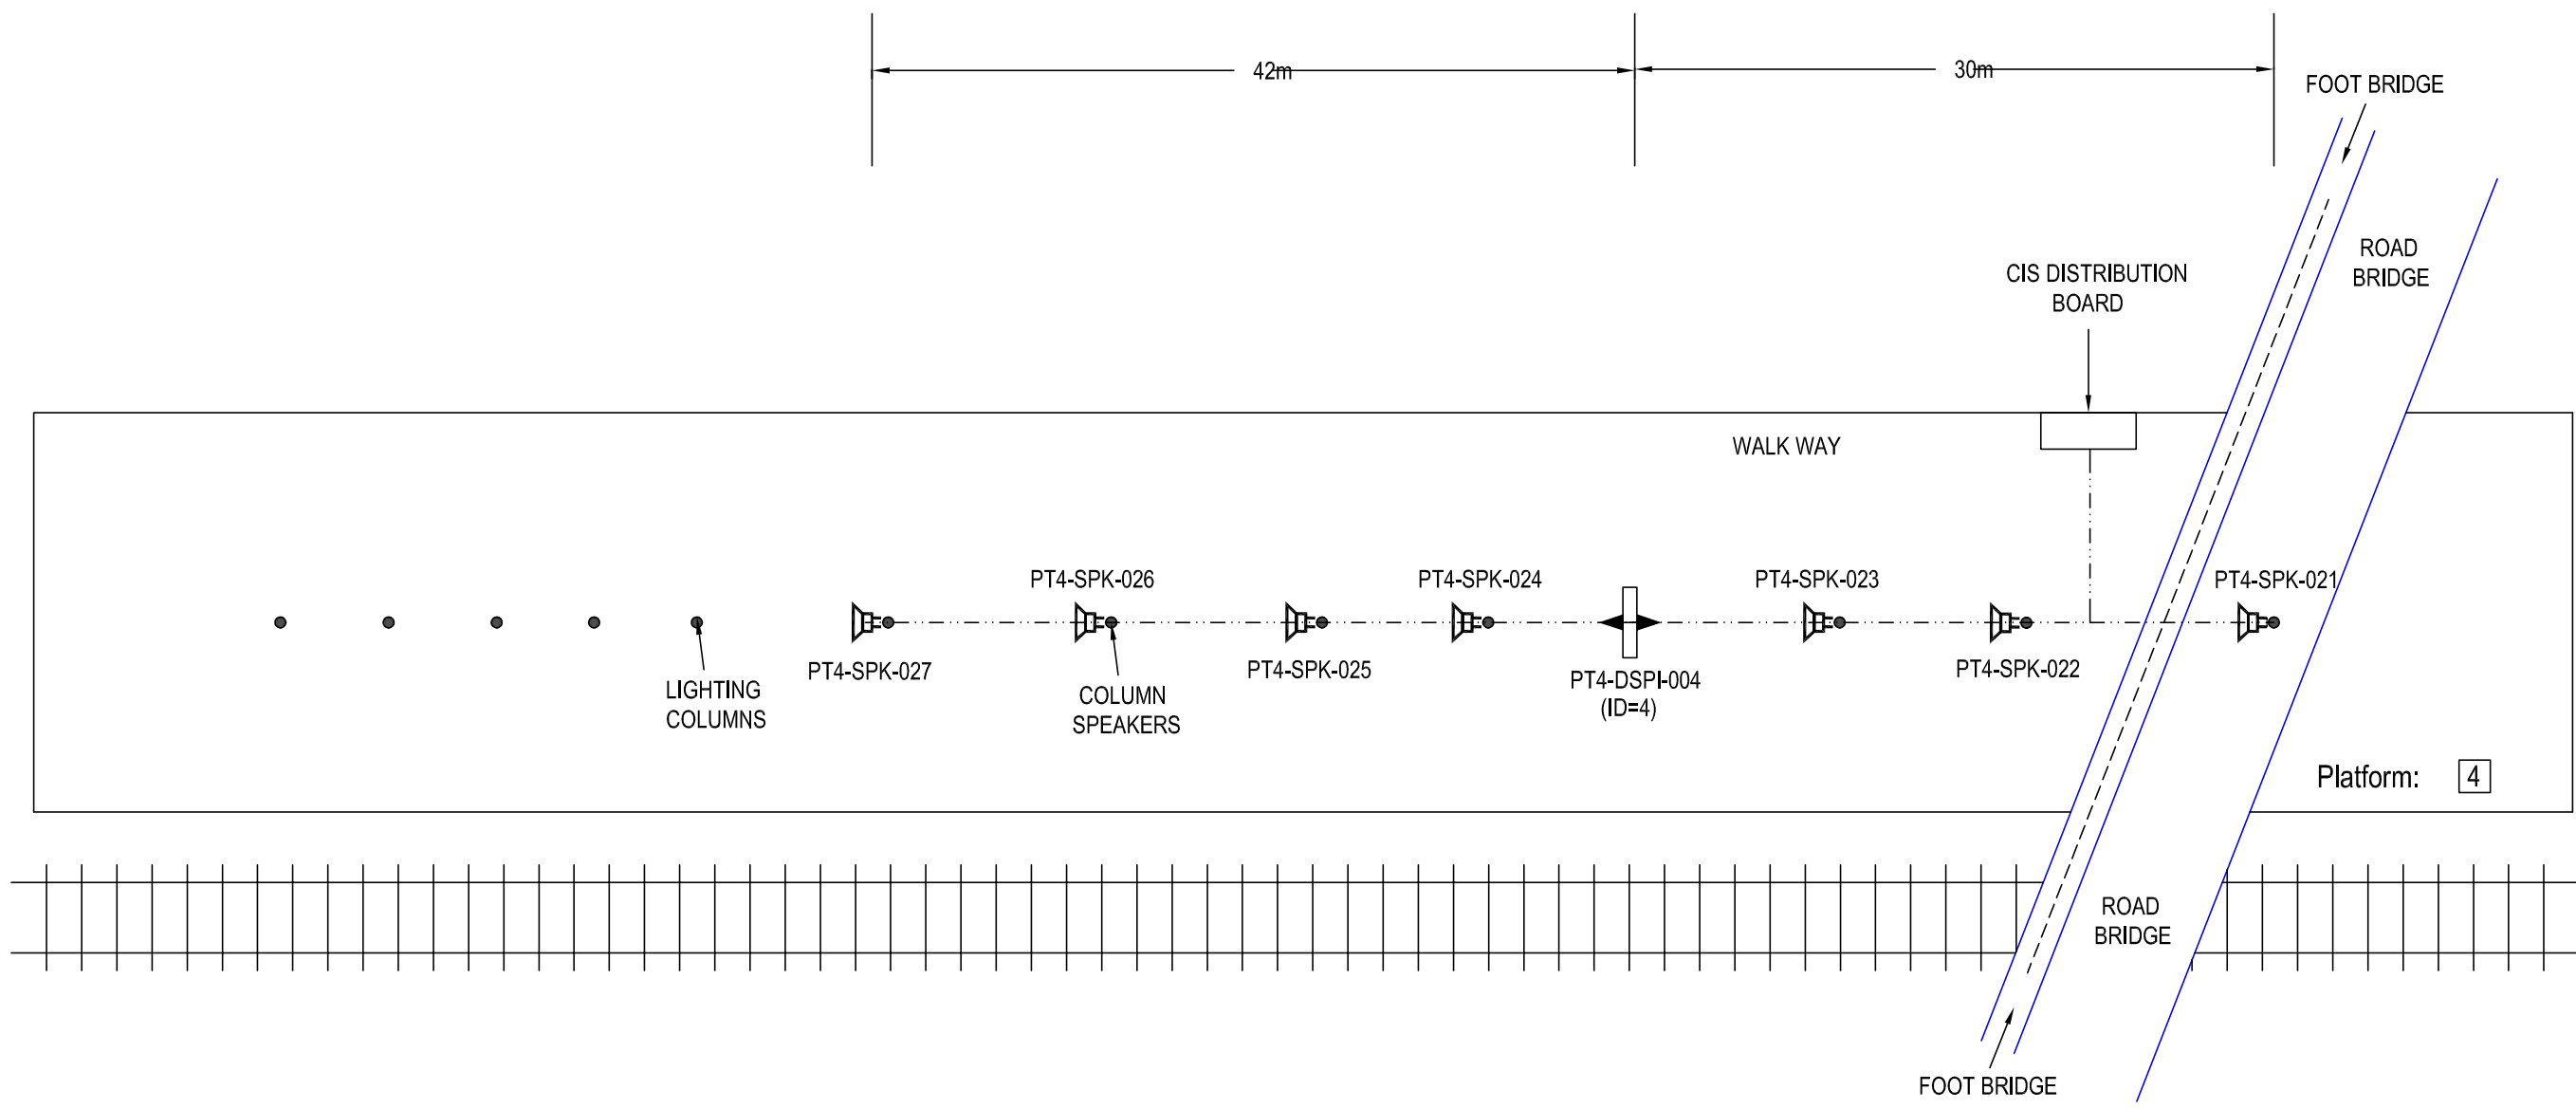All Equipment tags to be prefixed with "BNS-"



IF IN DOUBT ASK!

MATERIAL	CONSTRUCTION	NAME	SIGNATURE	DATE	 AMEY DATEL Project Offices 1st Floor, Platform 2/3 Eastleigh Station Southampton Road Eastleigh Hants SO50 9FL	SITE/PROJECT		SOUTH WEST TRAINS CIS PROJECT	
		DRAWN BY	D GADDU	05-03-2002		TITLE	BARNES STATION PLATFORM 4 AS BUILT		
FINISH		CHECKED BY	T WONG		COPYRIGHT © AMEY Rail All rights reserved. Neither this drawing or any of the information it contains may copied or communicated to third parties without the written permission of the copyright holder	SCALE	DRG No.	ISSUE	SHEET
		APPD BY	A SMITH			NTS	SM803-75551	B	3 of 3
		CAD Ref.							
		CONTRACTOR'S Ref:							