


SM803-75849



WAN	
CIRCUIT ID	KXIP700394
IP ADDRESS	10.227.81.1

"PLATFORM 1 HP ISDN"
01-489-799483
"PLATFORM 2 HP ISDN"
01-489-799484

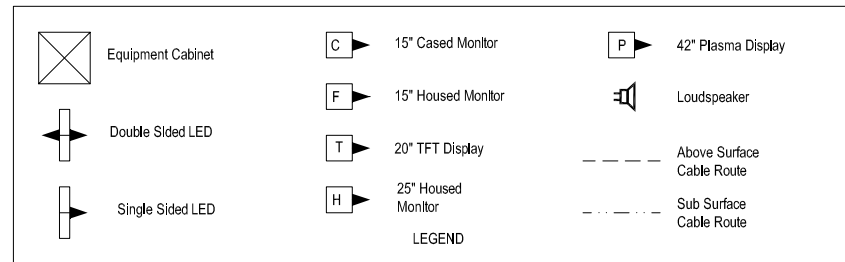


Equipment	Dist Board
SPARES	CCT 1
PT1-DSPI-001	CCT 2
PT2-DSPI-002	CCT 3
CIS RACK	CCT 4

All Equipment tags to be prefixed with "PKS-"

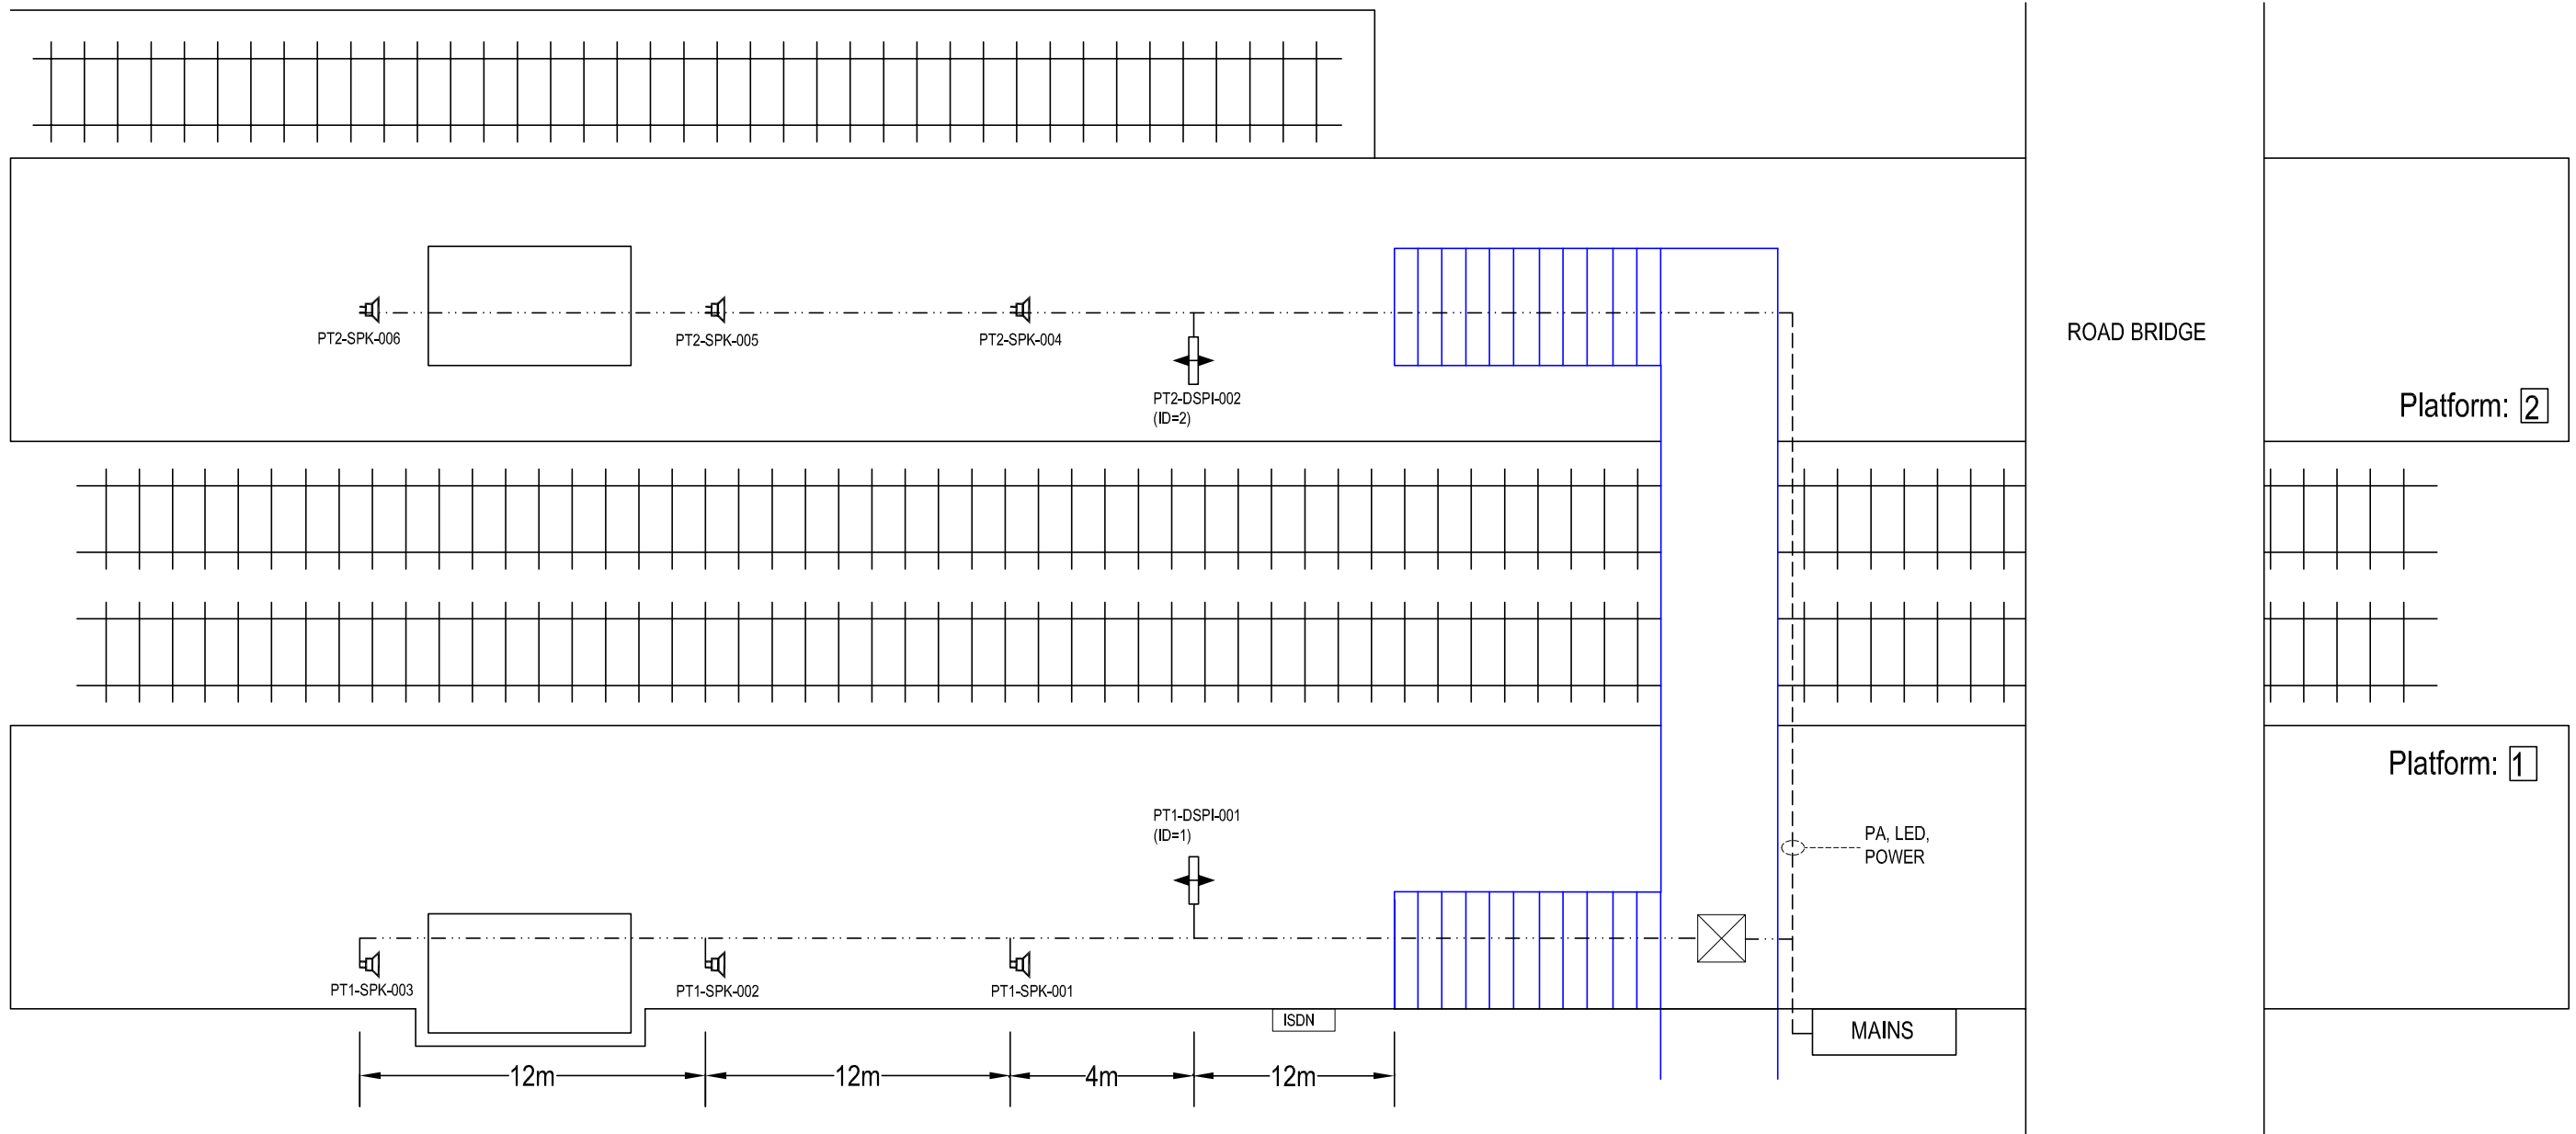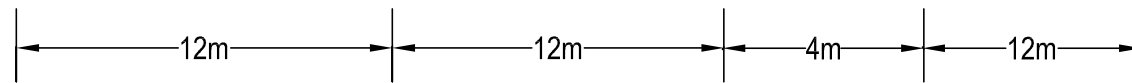

IF IN DOUBT ASK!

MATERIAL	CONSTRUCTION	NAME	SIGNATURE	DATE	 AMEY DATEL Project Offices 1st Floor, Platform 2/3 Eastleigh Station Southampton Road Eastleigh Hants SO50 9FL	SITE/PROJECT		SOUTH WEST TRAINS CIS PROJECT	
		DRAWN BY	A HATTON	08-05-02		TITLE	BOTLEY AS BUILT		
FINISH	CONSTRUCTION	CHECKED BY	T WONG		COPYRIGHT © AMEY Rail All rights reserved. Neither this drawing or any of the information it contains may copied or communicated to third parties without the written permission of the copyright holder	SCALE	DRG No.	ISSUE	SHEET
		APPD BY	A SMITH			NTS	SM803-75849	B	1 of 1
		CAD Ref:							
		CONTRACTOR'S Ref:							