


DRG No.

SM803-75581


WAN	
CIRCUIT ID	KXIP6003716
IP ADDRESS	10.227.84.1

"PLATFORM 1 HP ISDN"
020-8390-7662
"PLATFORM 2 HP ISDN"
020-8390-2816

All Equipment tags to be prefixed with "BRS-"

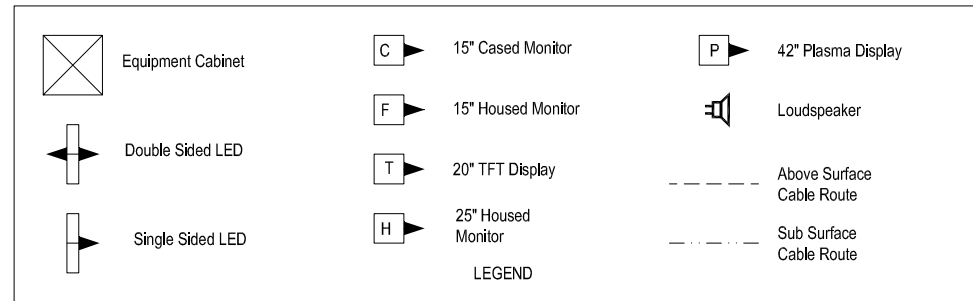

Equipment	Dist Board
CIS RACK	CCT 3
TH-HIDU-001	CCT 3
PT1-DSPI-001	CCT4
PT2-DSPI-002	CCT 2

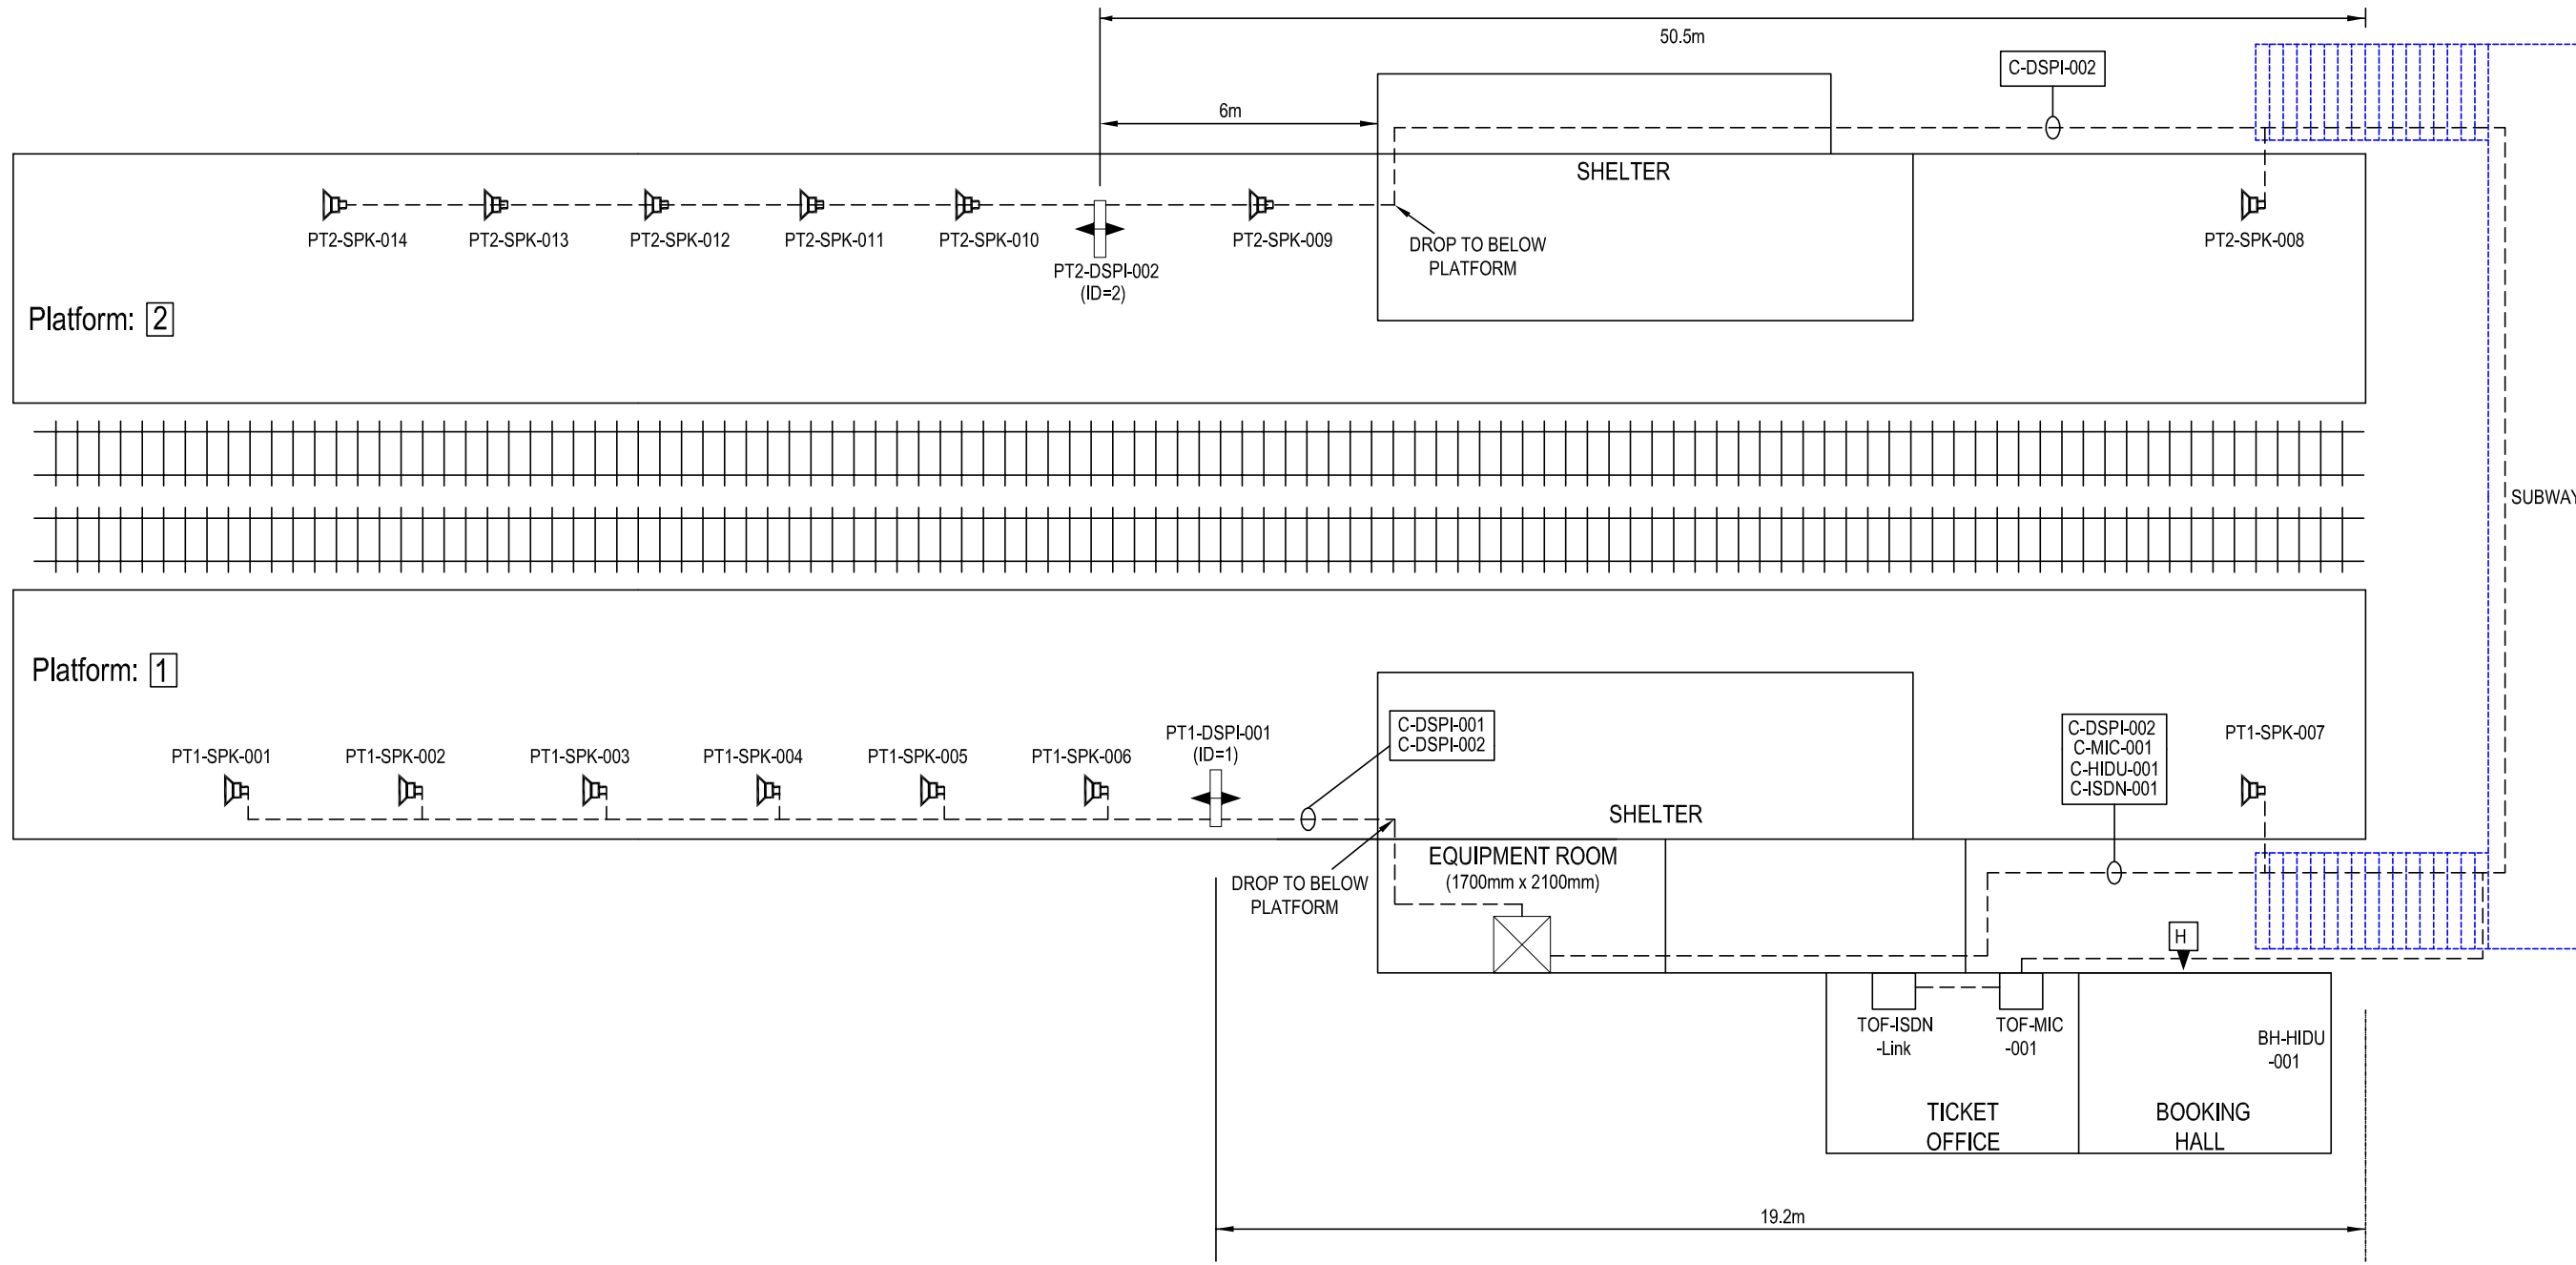

MATERIAL	CONSTRUCTION
FINISH	

NAME	SIGNATURE	DATE
D GADDU		13-03-2002
T WONG		
A SMITH		
CAD Ref:		
CONTRACTOR'S Ref:		

AMEY DATEL Project  
 Offices  
 1st Floor, Platform  
 2/3  
 Eastleigh Station  
 Southampton Road  
 Eastleigh  
 Hants  
 SO50 9FL

COPYRIGHT © AMEY Rail  
 All rights reserved. Neither this drawing or any of the information it contains may be copied or communicated to third parties without the written permission of the copyright holder

SITE/PROJECT		SOUTH WEST TRAINS CIS PROJECT	
TITLE		BERRYLANDS AS BUILT	
SCALE	DRG No.	ISSUE	SHEET
NTS	SM803-75581	B	1 of 1