




DRG No. SM803-75520


WAN	
CIRCUIT ID	MXIP 201530
IP ADDRESS	10.227.75.1

All Equipment tags to be prefixed with "BSK-"

"PLATFORM 1 HP ISDN"	01256-461166
"PLATFORM 2 HP ISDN"	01256-461169
"PLATFORM 4 HP ISDN"	01256-331193
"PLATFORM 5 HP ISDN"	01256-331252

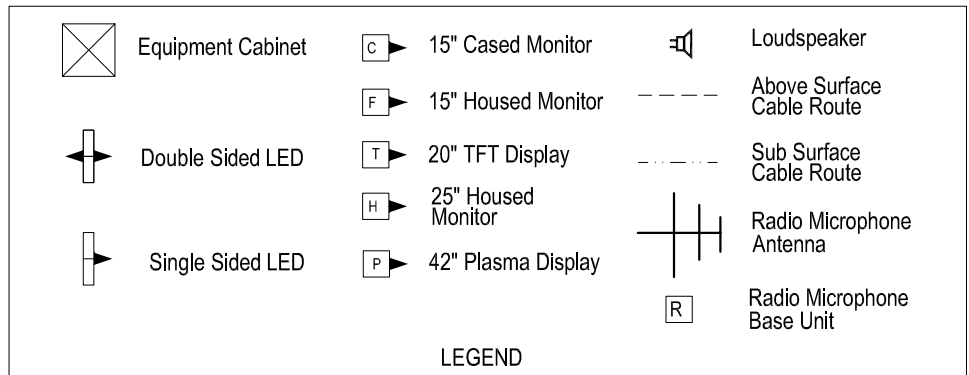


Equipment	Dist Board
CIS RACK	EXISTING DB ON SIDE OFF WALL BY CABINET

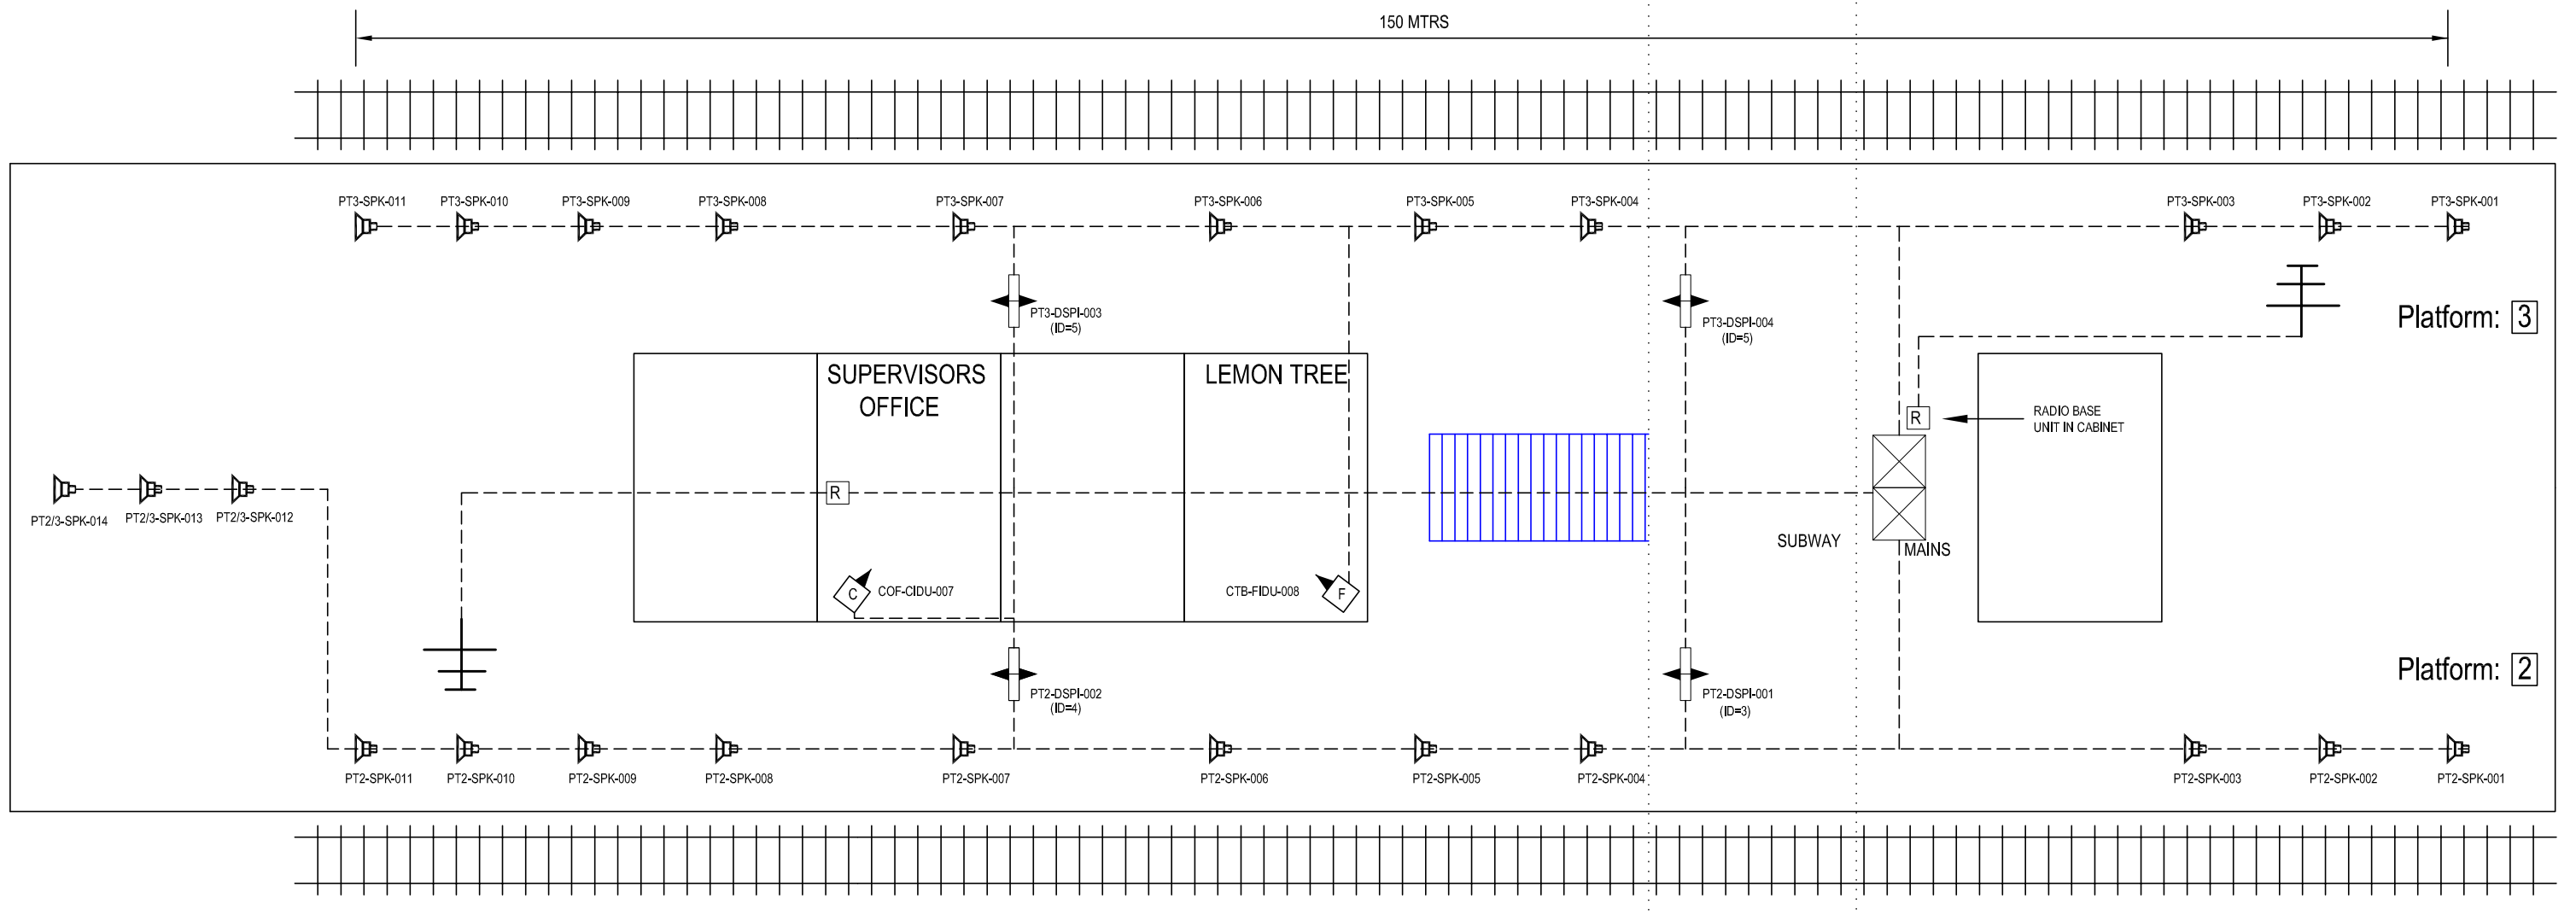

IF IN DOUBT ASK!

Date of Last Modification: 25 April 2003  
This Drawing Supersedes Any Previous Drawings

CONSTRUCTION	NAME	SIGNATURE	DATE
DRAWN BY	J STEVENS		25-04-2003
CHECKED BY	T WONG		
APPD BY	A SMITH		
APPD BY			



AMEY DATEL Project  
Offices  
1st Floor, Platform  
2/3  
Eastleigh Station  
Southampton Road  
Eastleigh  
Hants  
SO50 9FL

SITE/PROJECT		SOUTH WEST TRAINS CIS PROJECT	
TITLE		BASINGSTOKE AS BUILT	

FINISH

CAD Ref:
CONTRACTOR'S Ref:


COPYRIGHT © AMEY Rail  
All rights reserved. Neither this drawing or any of the information it contains may be copied or communicated to third parties without the written permission of the copyright holder

SCALE	DRG No.	ISSUE	SHEET
NTS	SM803-75520	C	2 of 3


WAN	
CIRCUIT ID	MXIP 201530
IP ADDRESS	10.227.75.1

All Equipment tags to be prefixed with "BSK-"

"PLATFORM 1 HP ISDN"	01256-461166
"PLATFORM 2 HP ISDN"	01256-461169
"PLATFORM 4 HP ISDN"	01256-331193
"PLATFORM 5 HP ISDN"	01256-331252

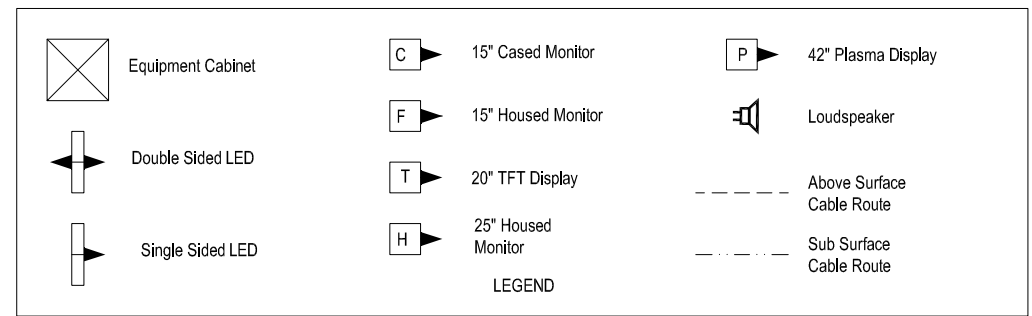

Equipment	Dist Board
CIS RACK	EXISTING DB ON SIDE OFF WALL BY CABINET

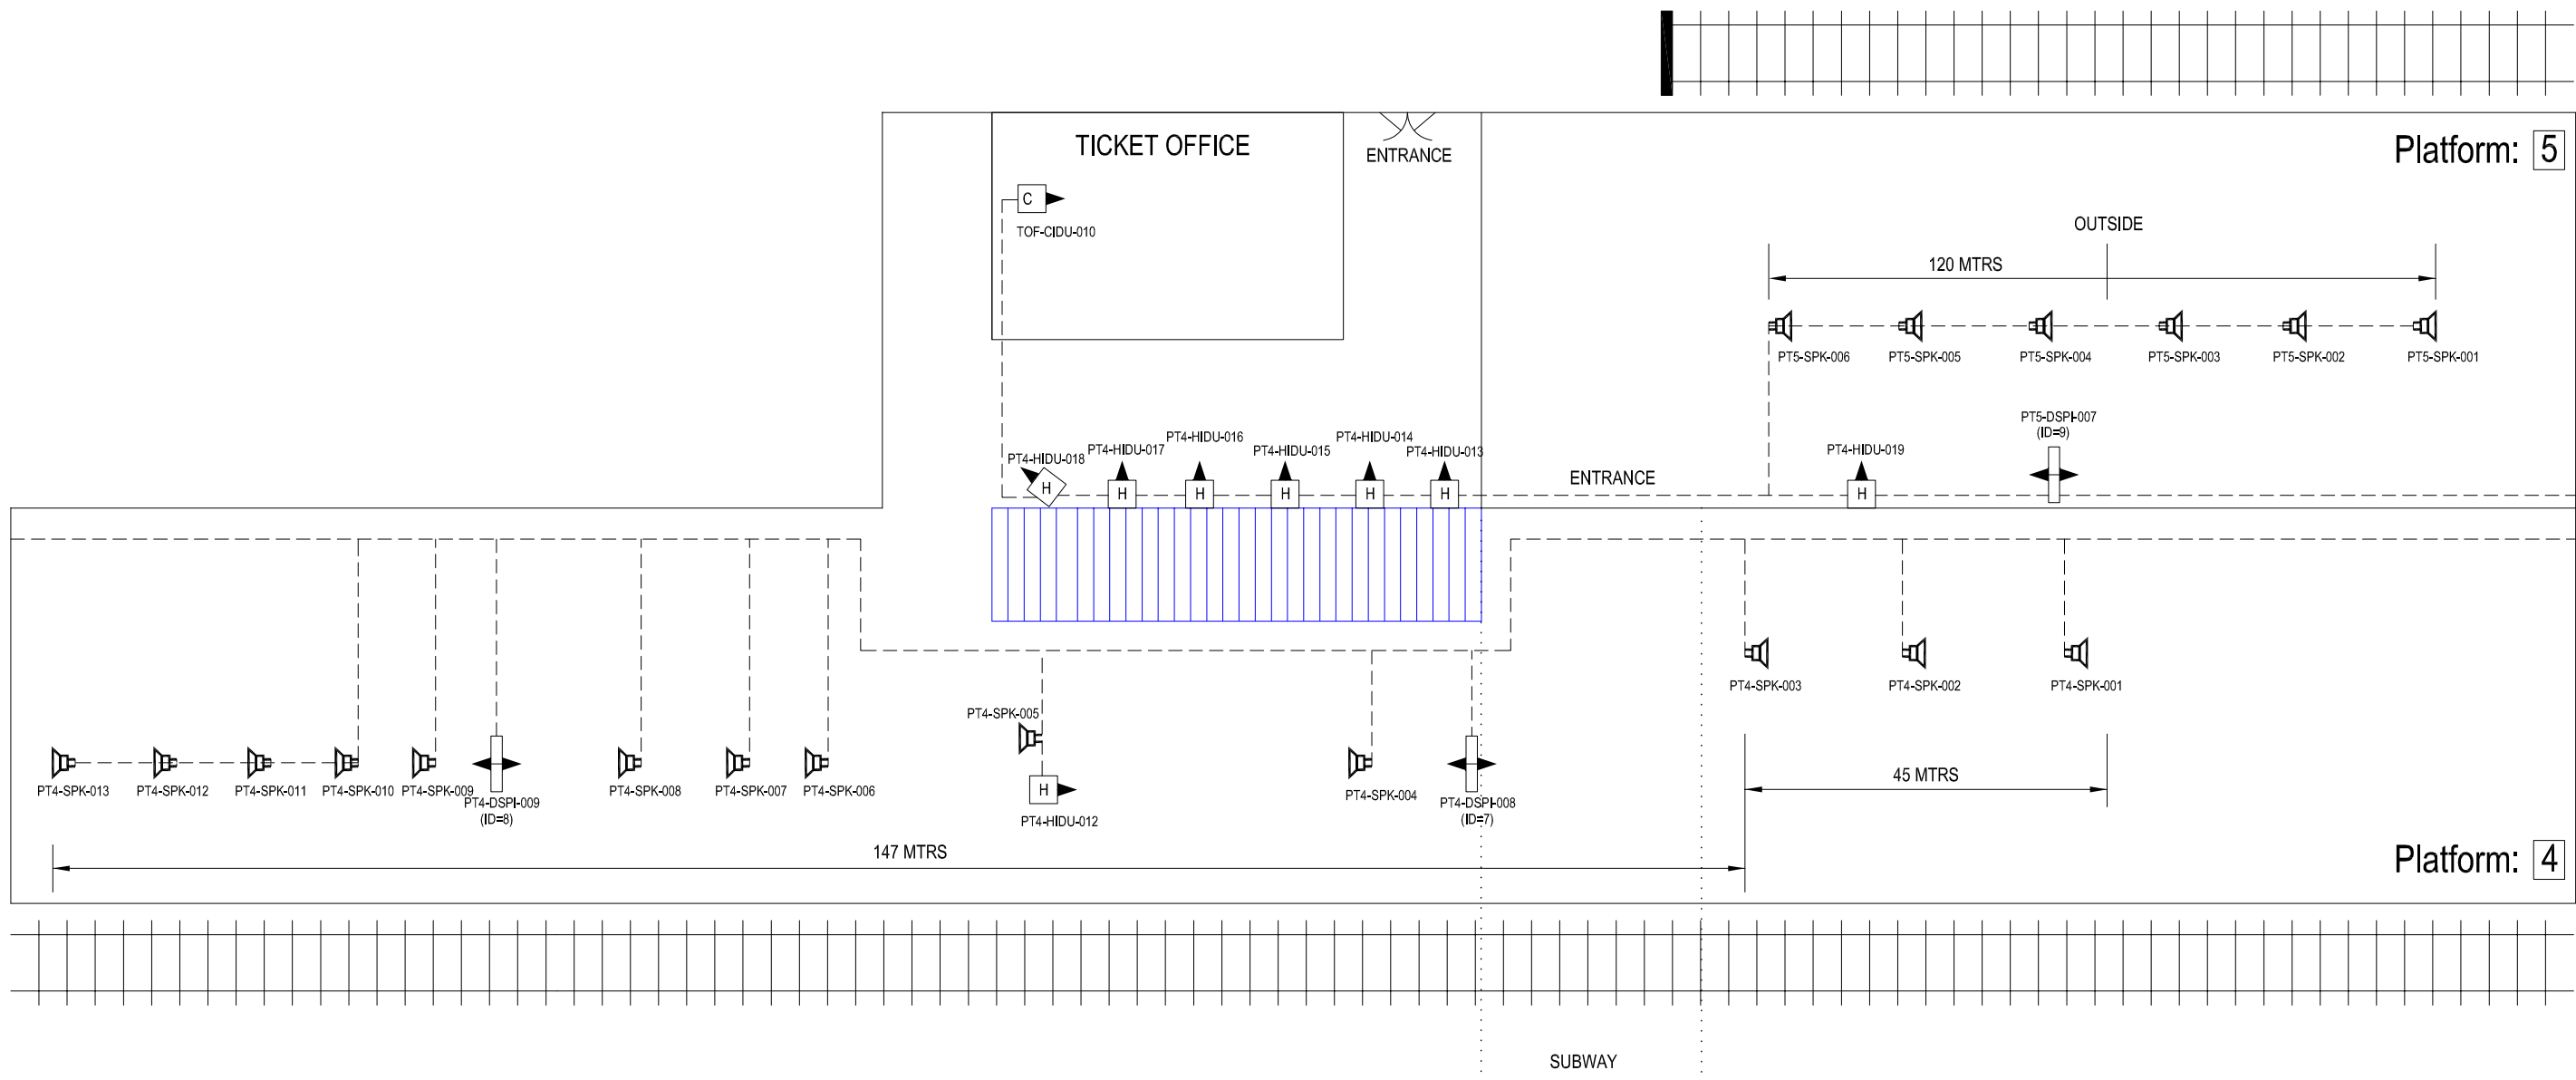

IF IN DOUBT ASK!

Date of Last Modification: 25 April 2003

This Drawing Supersedes Any Previous Drawings

CONSTRUCTION	NAME	SIGNATURE	DATE
DRAWN BY	J STEVENS		25-04-2003
CHECKED BY	T WONG		
APPD BY	A SMITH		
APPD BY			

AMEY DATEL Project Offices  
1st Floor, Platform 2/3  
Eastleigh Station  
Southampton Road  
Eastleigh  
Hants  
SO50 9FL

SITE/PROJECT	TITLE
SOUTH WEST TRAINS CIS PROJECT	BASINGSTOKE AS BUILT

FINISH

CAD Ref:	
CONTRACTOR'S Ref:	

COPYRIGHT © AMEY Rail  
All rights reserved. Neither this drawing or any of the information it contains may be copied or communicated to third parties without the written permission of the copyright holder

SCALE	DRG No.	ISSUE	SHEET
NTS	SM803-75520	C	3 of 3