



WAN	
CIRCUIT ID	KXIP 900433
IP ADDRESS	10.227.80.1

HP ISDN	
PLATFORM 1	01-202-759234
PLATFORM 2	01-202-759245

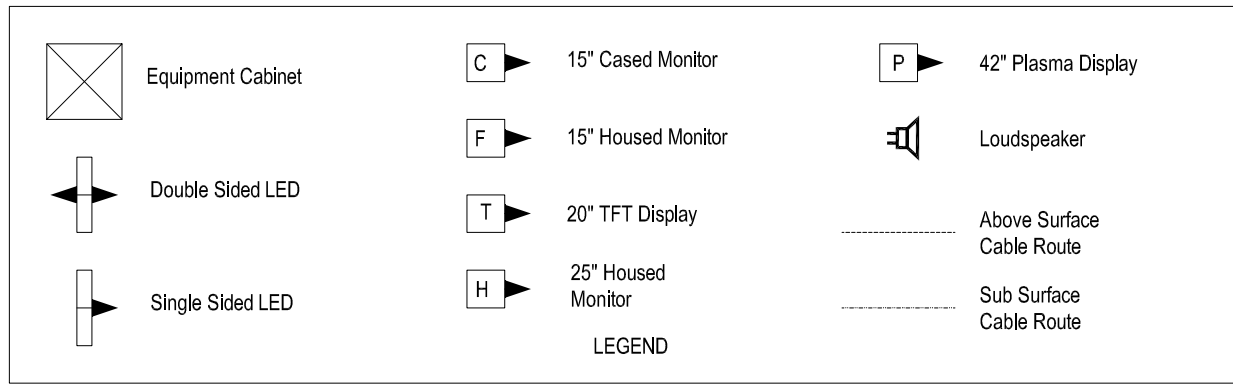


Equipment	Dist Board
CCT BRK 1	CIS RACK
CCT BRK 2	13 A TWIN
CCT BRK 3	HEATER
CCT BRK 4	FAN + STAT
CCT BRK 5	T/HALL CRT
CCT BRK 6	LED PT2
CCT BRK 7	LED PT1
CCT BRK 8	SPARE

All Equipment tags to be prefixed with "BSM-"

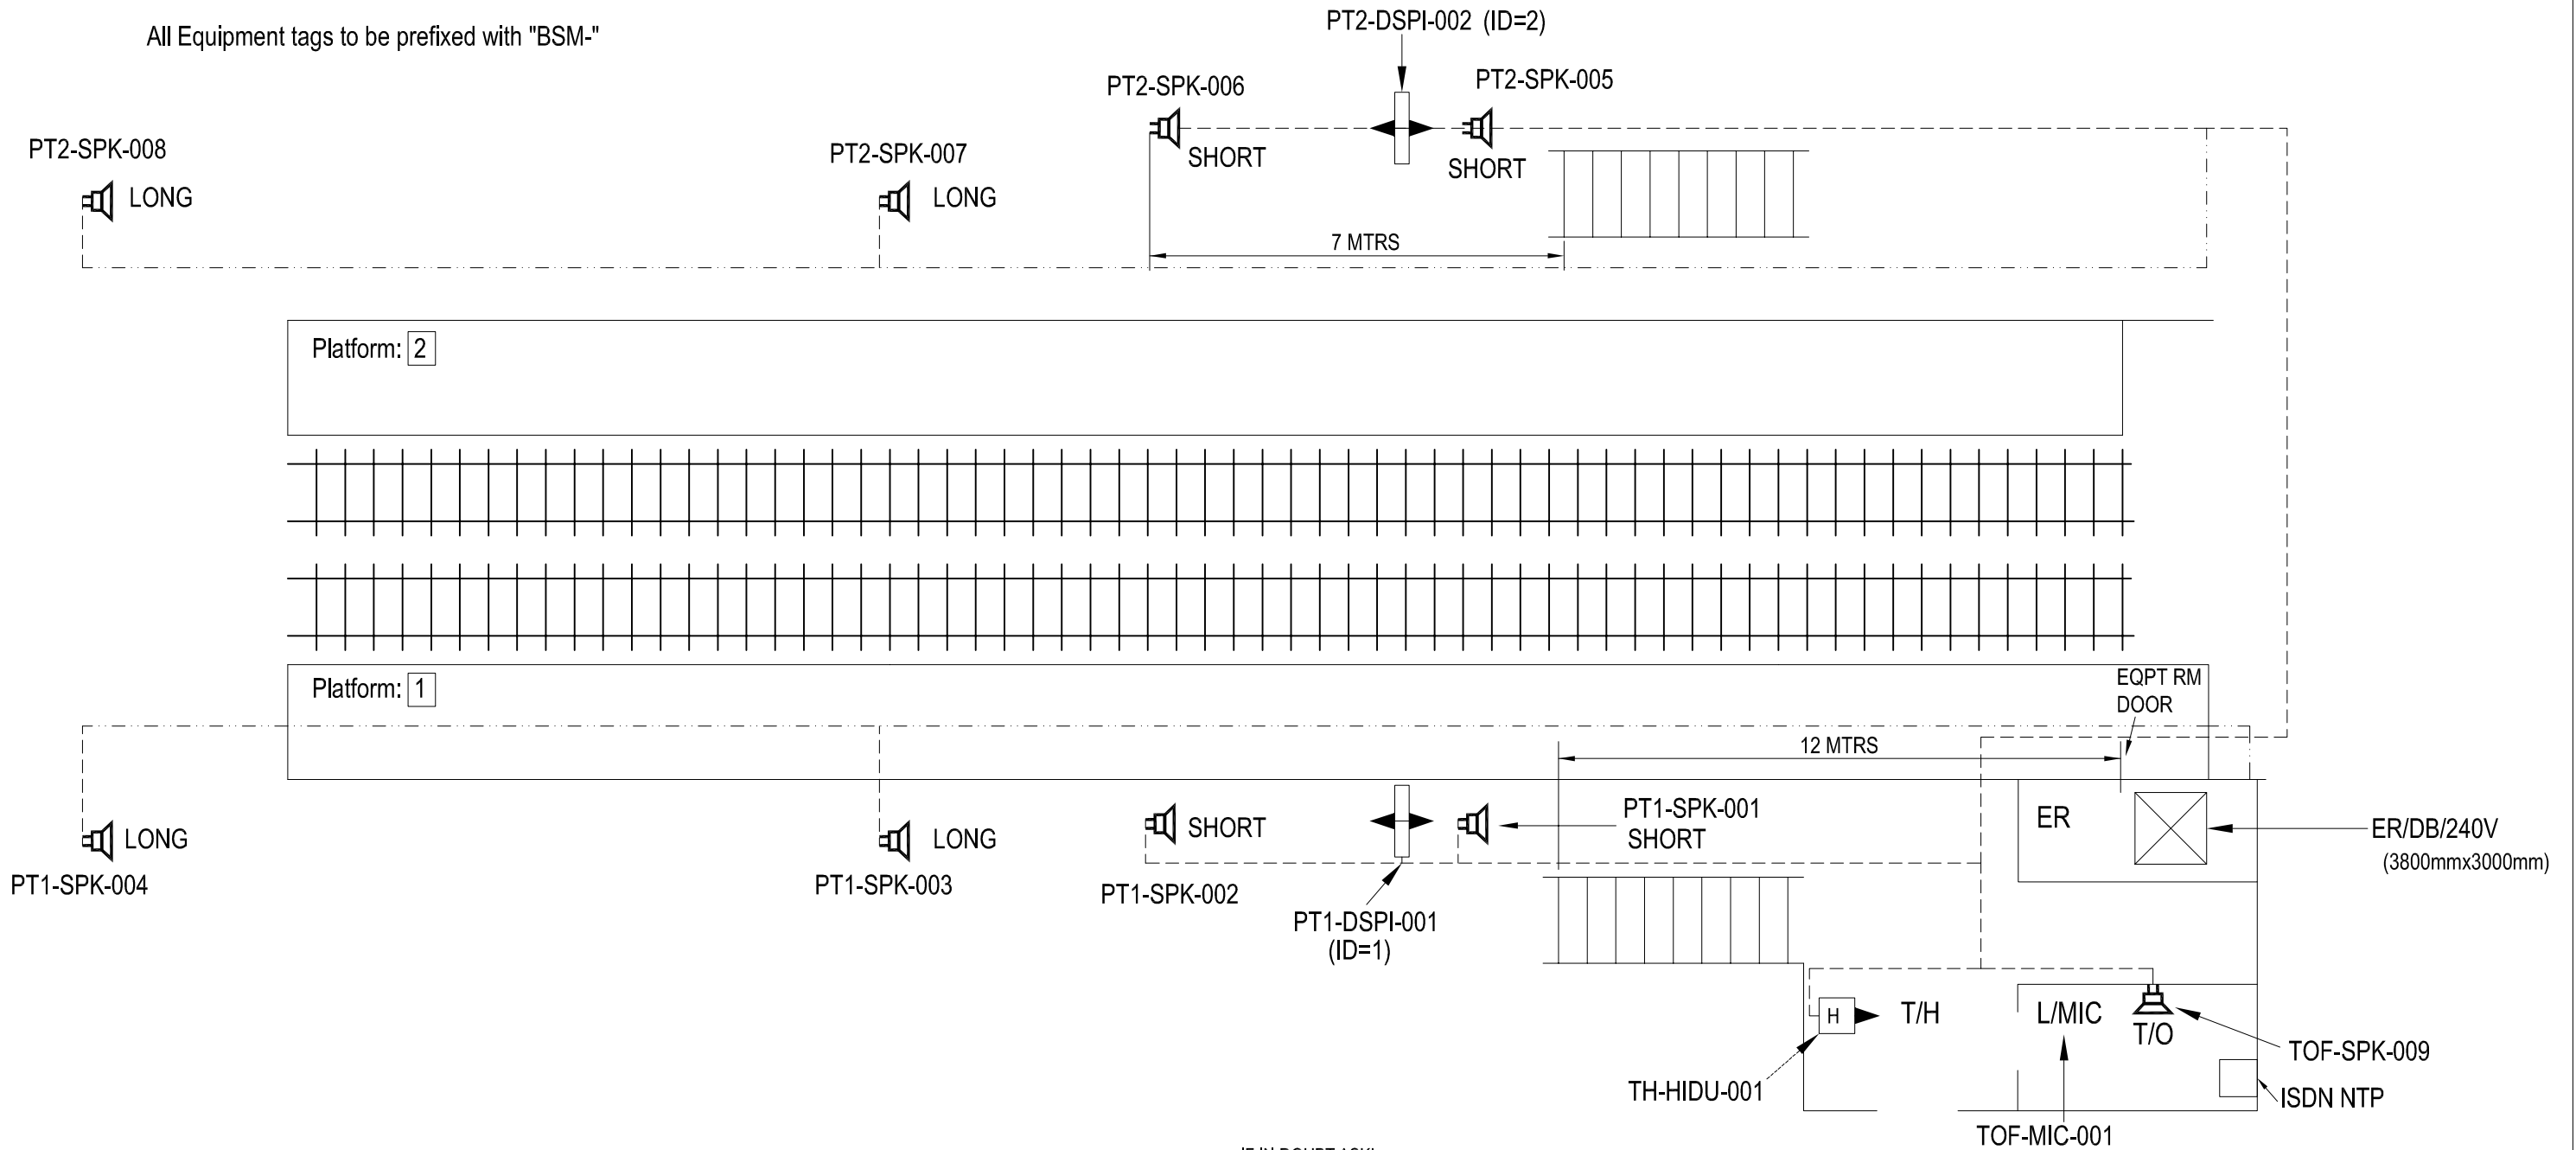

IF IN DOUBT ASK!

MATERIAL	CONSTRUCTION	NAME	SIGNATURE	DATE	 <p>AMEY DATEL Project Offices 1st Floor, Platform 2/3 Eastleigh Station Southampton Road Eastleigh Hants SO50 9FL</p>	SITE/PROJECT		
		D GADDU		31-01-2002		SOUTH WEST TRAINS CIS PROJECT		
						TITLE		
						BRANKSOME AS BUILT		
						SCALE	DRG No.	ISSUE
					NTS	SM803-75875	B	1 of 1

COPYRIGHT © AMEY Rail  
All rights reserved. Neither this drawing or any of the information it contains may be copied or communicated to third parties without the written permission of the copyright holder