


DRG No.

SM803-75884


| | |
|------------|-------------|
| WAN | |
| CIRCUIT ID | KXIP 200496 |
| IP ADDRESS | 10.227.78.1 |

| |
|----------------------|
| "PLATFORM 1 HP ISDN" |
| 02380 420123 |
| "PLATFORM 2 HP ISDN" |
| 02380 402124 |

All Equipment tags to be prefixed with "BUO-"

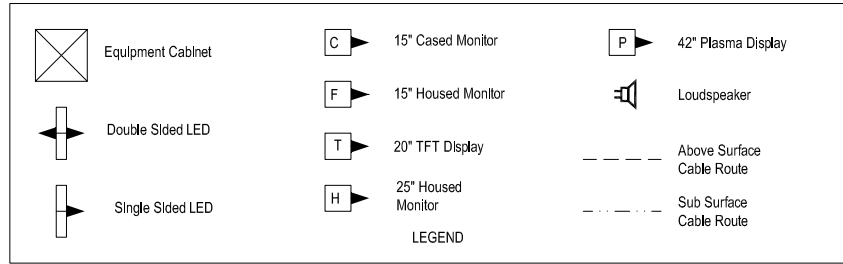


| Equipment | Dist Board |
|-----------|------------|
| CIS RACK | CCT NO. 1 |
| LED PT1 | CCT NO. 2 |
| LED PT2 | CCT NO.3 |
| SPARE | CCT NO. 4 |

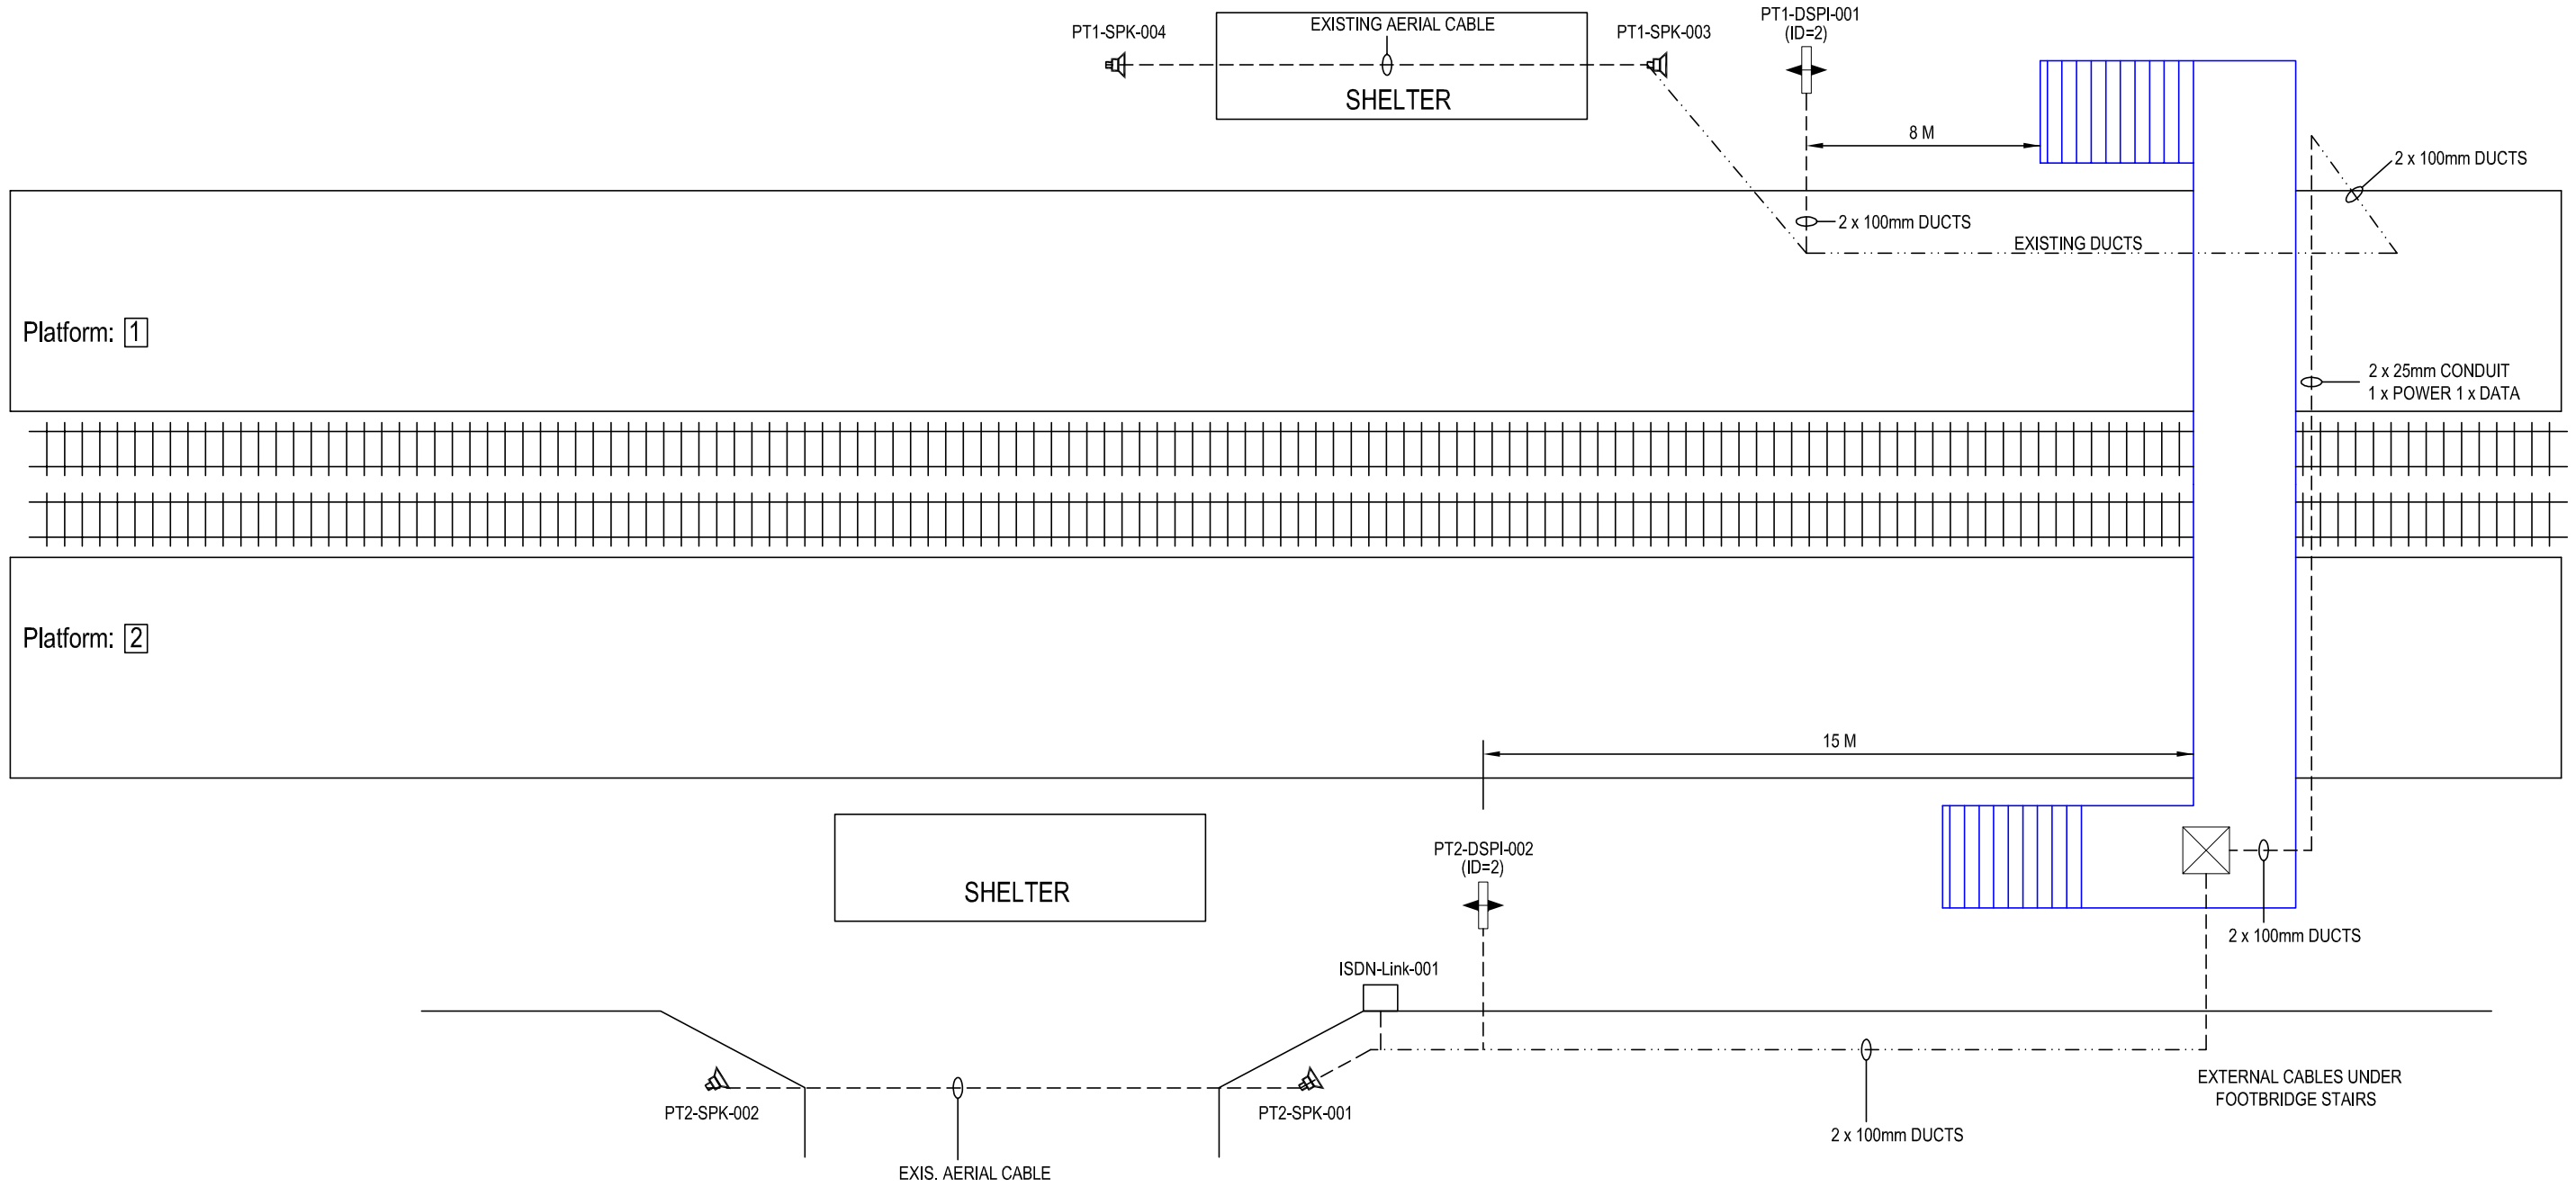

IF IN DOUBT ASK!

| | |
|----------|--------------|
| MATERIAL | CONSTRUCTION |
| FINISH | |

| | NAME | SIGNATURE | DATE |
|-------------------|---------|-----------|------------|
| DRAWN BY | D GADDU | | 28-03-2002 |
| CHECKED BY | T WONG | | |
| APPD BY | A SMITH | | |
| APPD BY | | | |
| CAD Ref: | | | |
| CONTRACTOR'S Ref: | | | |



AMEY DATEL Project
 Offices
 1st Floor, Platform
 2/3
 Eastleigh Station
 Southampton Road
 Eastleigh
 Hants
 SO50 9FL

COPYRIGHT © AMEY Rail
 All rights reserved. Neither this drawing or any of the information it contains may be copied or communicated to third parties without the written permission of the copyright holder

| | | | |
|--------------|-------------|-------------------------------|--------|
| SITE/PROJECT | | SOUTH WEST TRAINS CIS PROJECT | |
| TITLE | | BURSLEDON AS BUILT | |
| SCALE | DRG No. | ISSUE | SHEET |
| NTS | SM803-75884 | B | 1 of 1 |