


DRG No. SM803-75682


WAN	
CIRCUIT ID	KXIP 100374
IP ADDRESS	10.227.104.1

"PLATFORM 1 HP ISDN"	01276-685041
"PLATFORM 2 HP ISDN"	01276-685042

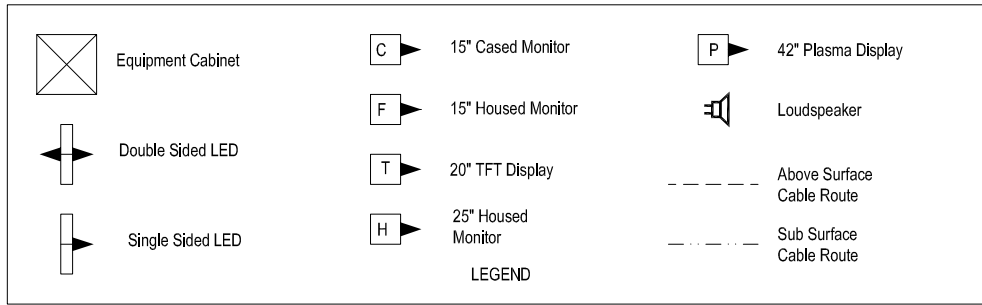

Equipment	Dist Board
RACK	EXISTING SPURS USED
LED 001	
IDU 001	

All Equipment tags to be prefixed with "CAM-"

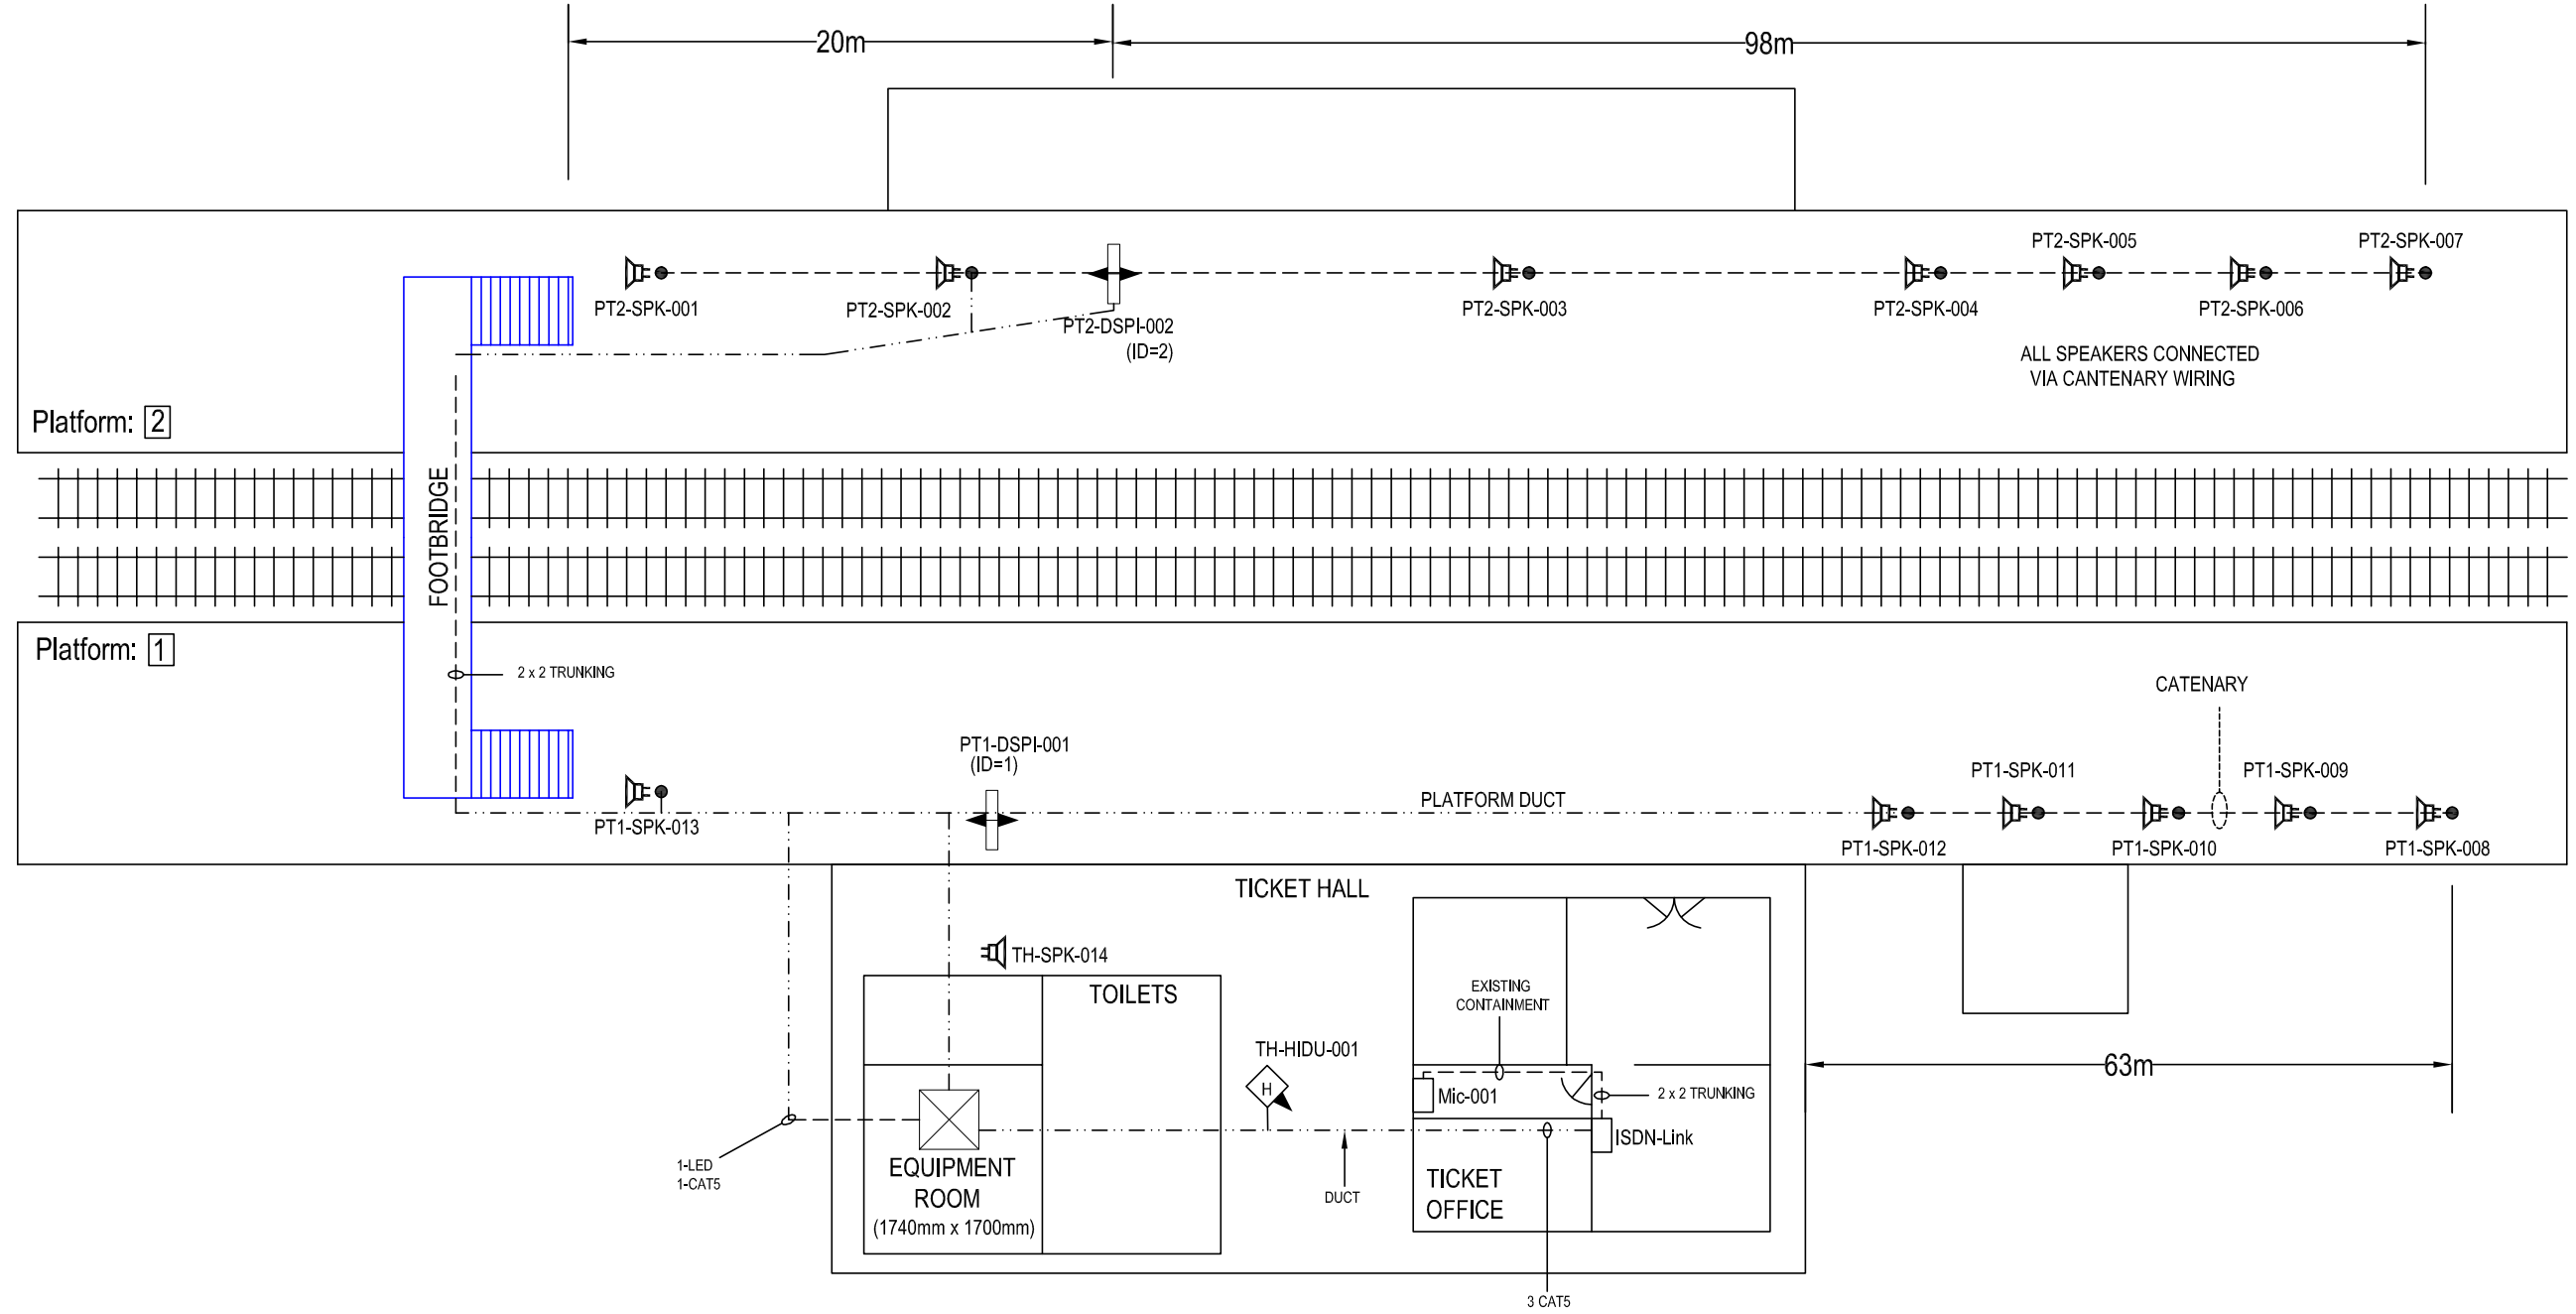

IF IN DOUBT ASK!

MATERIAL	CONSTRUCTION
FINISH	

NAME	SIGNATURE	DATE
DRAWN BY D GADDU		13-05-2002
CHECKED BY T WONG		
APPD BY A SMITH		
APPD BY		
CAD Ref:		
CONTRACTOR'S Ref:		

AMEY DATEL Project
 Offices
 1st Floor, Platform
 2/3
 Eastleigh Station
 Southampton Road
 Eastleigh
 Hants
 SO50 9FL

amey

COPYRIGHT © AMEY Rail
 All rights reserved. Neither this drawing or any of the information it contains may be copied or communicated to third parties without the written permission of the copyright holder

SITE/PROJECT		SOUTH WEST TRAINS CIS PROJECT	
TITLE		CAMBERLEY AS BUILT	
SCALE	DRG No.	ISSUE	SHEET
NTS	SM803-75682	B	1 of 1