


SM803-75879


WAN	
CIRCUIT ID	KXIP 300407
IP ADDRESS	10.227.109.1

"PLATFORM 1 HP ISDN"
01-202-484135
"PLATFORM 2 HP ISDN"
01-202-484271

All Equipment tags to be prefixed with "CHR-"

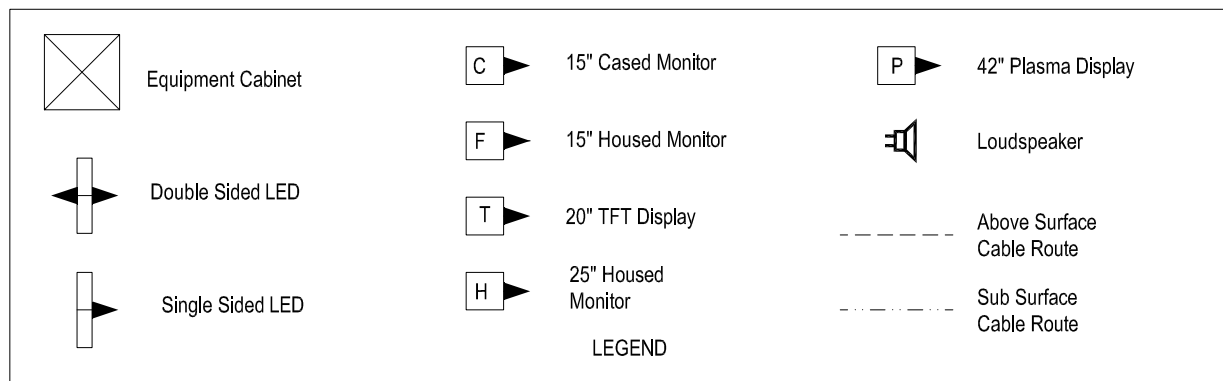

Equipment	Dist Board
CIS RACK	CCT NO 1
HEATER	CCT NO 2
13A TWIN	CCT NO 3
SPARE	CCT NO 4-9

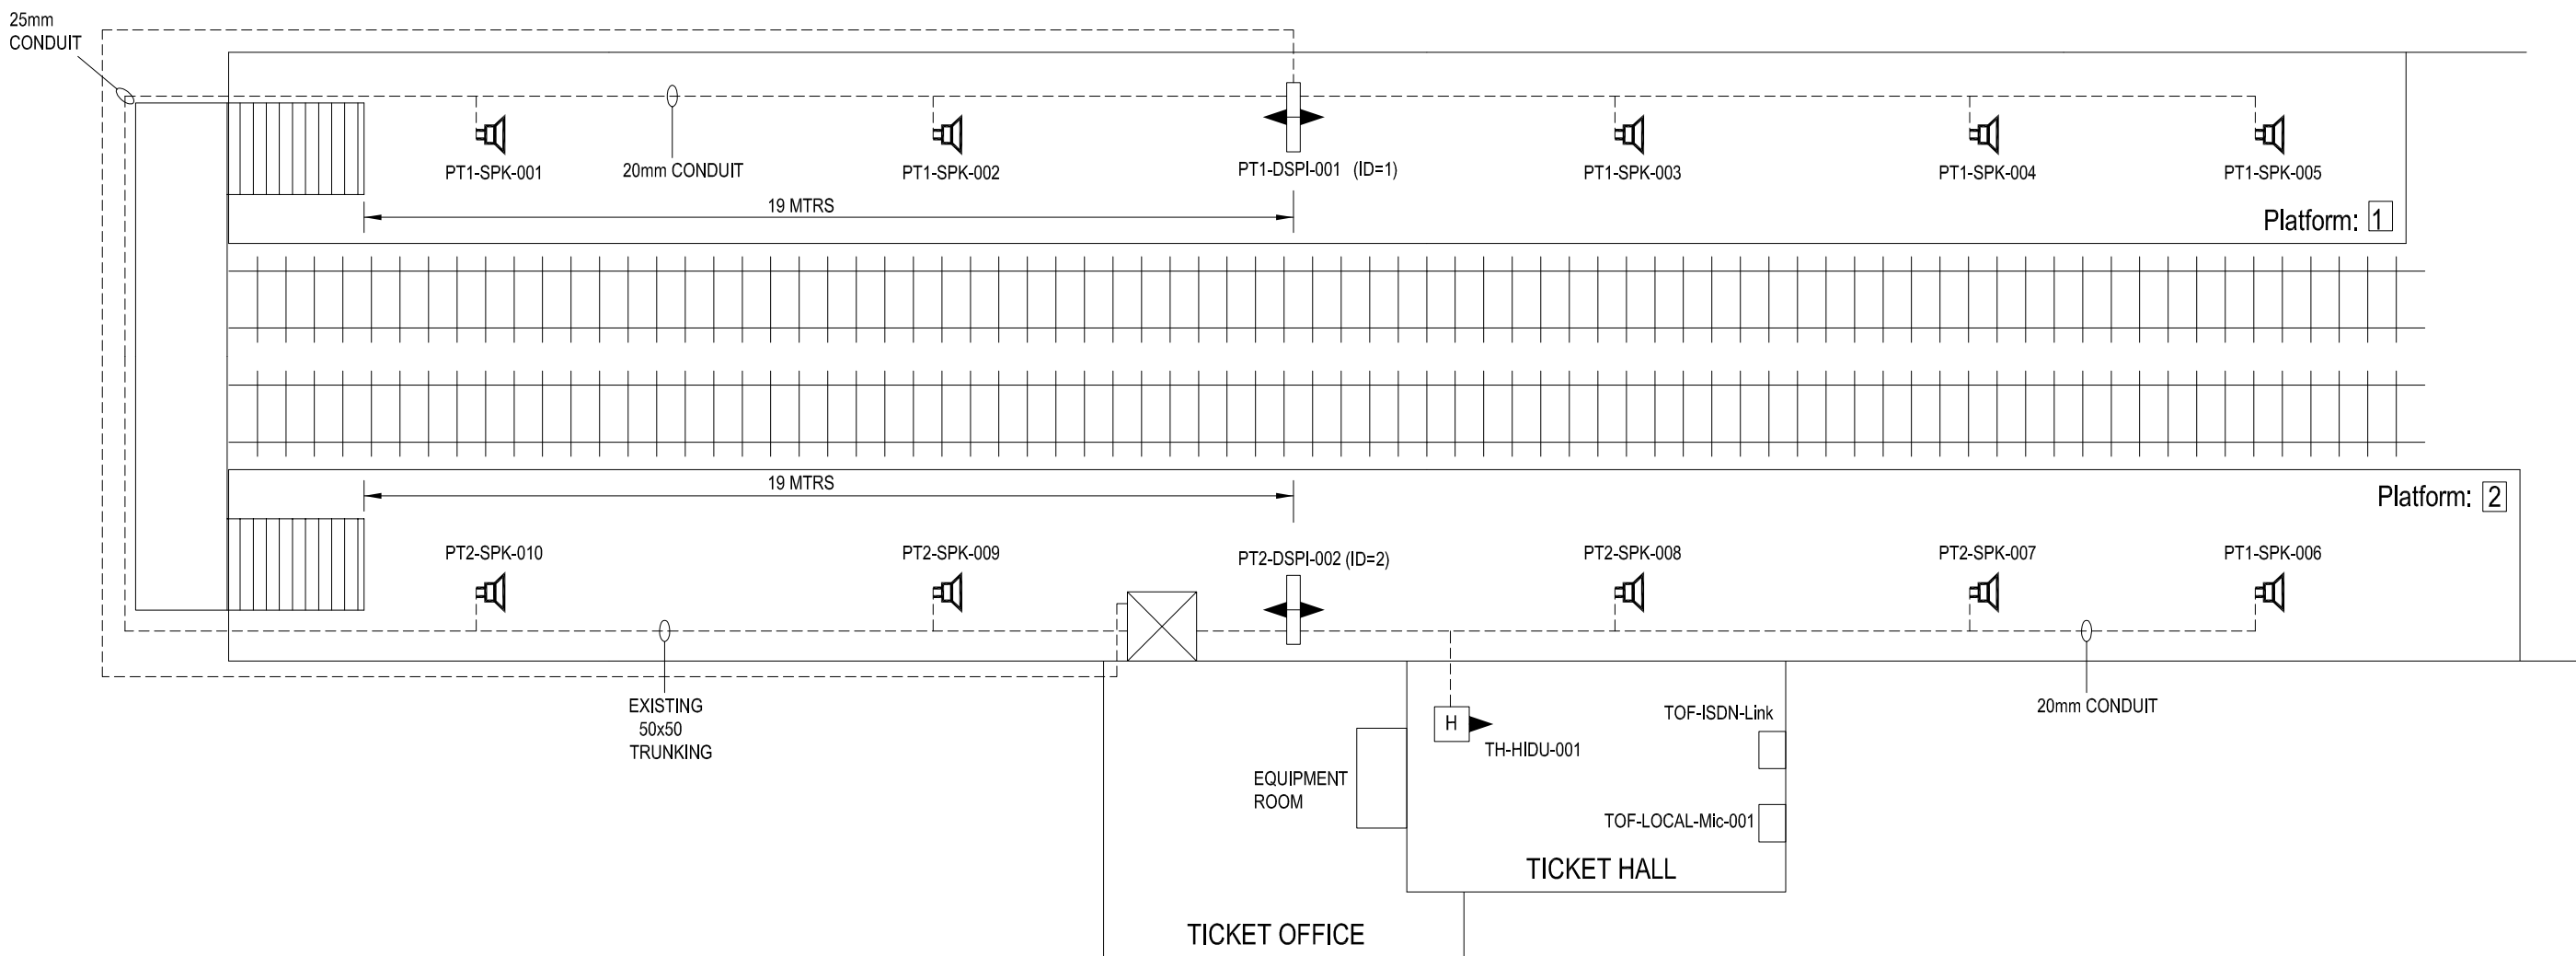

IF IN DOUBT ASK!

MATERIAL	CONSTRUCTION	NAME	SIGNATURE	DATE
		D GADDU		31-01-2002
FINISH				



AMEY DATEL Project
 Offices
 1st Floor, Platform
 2/3
 Eastleigh Station
 Southampton Road
 Eastleigh
 Hants
 SO50 9FL

SITE/PROJECT		SOUTH WEST TRAINS CIS PROJECT	
TITLE		CHRISTCHURCH AS BUILT	
SCALE	DRG No.	ISSUE	SHEET
NTS	SM803-75879	B	1 of 1

COPYRIGHT © AMEY Rail
 All rights reserved. Neither this drawing or any of the information it contains may be copied or communicated to third parties without the written permission of the copyright holder