



WAN	
CIRCUIT ID	KXIP100375
IP ADDRESS	10.227.105.1

"PLATFORM 1 HP ISDN"
01932-563788
"PLATFORM 2 HP ISDN"
01932-561834

All Equipment tags to be prefixed with "CHY-"

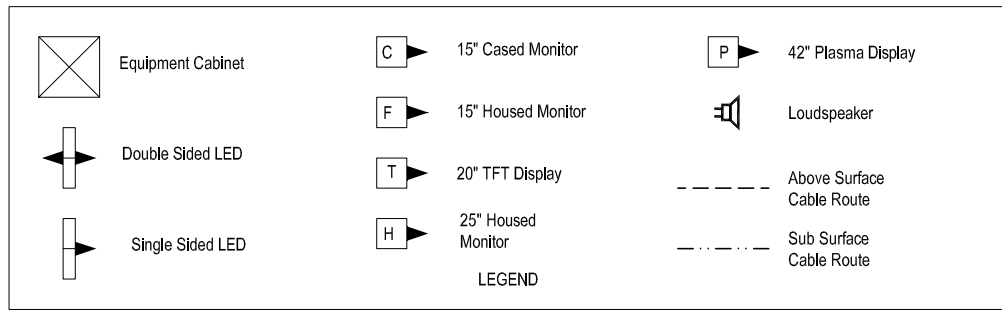

Equipment	Dist Board
CIS RACK	NEW BOARD
BH-FIDU-001	EXISTING
PT1-FIDU-002	18 WAY CRAB -12
PT1-DSPI-001	CPI-5
PT2-DSPI-002	EXISTING

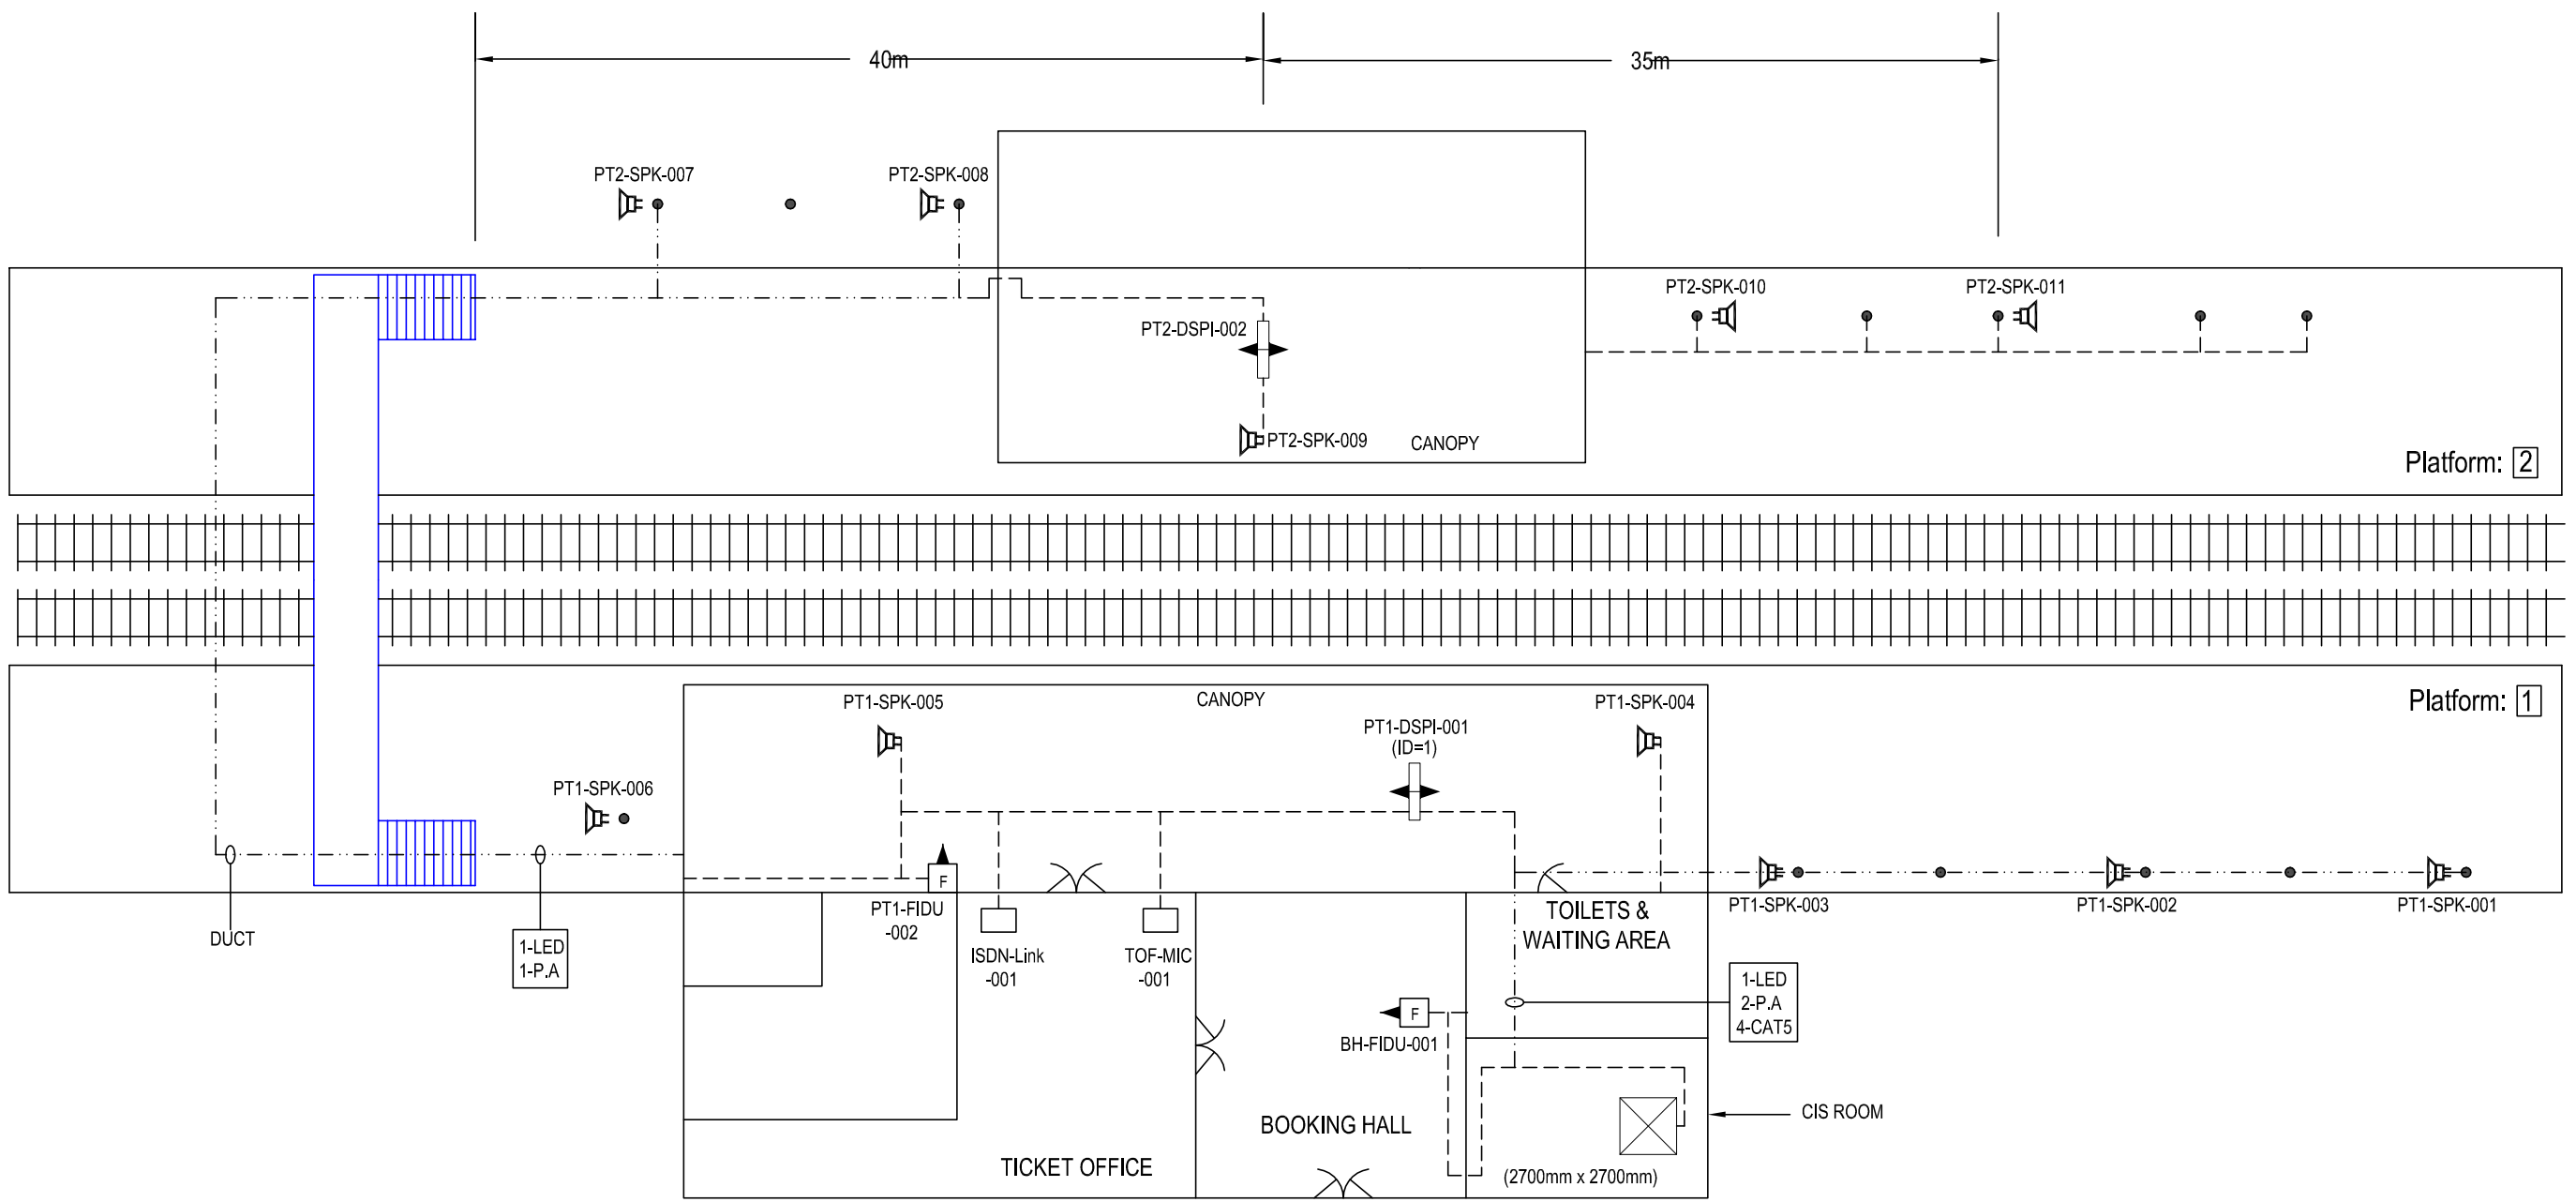

IF IN DOUBT ASK!

MATERIAL	CONSTRUCTION
FINISH	

NAME	SIGNATURE	DATE
D GADDU		13-05-2002
T WONG		
A SMITH		

CAD Ref:

CONTRACTOR'S Ref:

AMEY DATEL Project Offices
1st Floor, Platform 2/3
Eastleigh Station
Southampton Road
Eastleigh
Hants
SO50 9FL

COPYRIGHT © AMEY Rail
All rights reserved. Neither this drawing or any of the information it contains may be copied or communicated to third parties without the written permission of the copyright holder

SITE/PROJECT		SOUTH WEST TRAINS CIS PROJECT	
TITLE		CHERTSEY AS BUILT	
SCALE	DRG No.	ISSUE	SHEET
NTS	SM803-75553	B	1 of 1