


DRG No. SM803-7555


	WAN
CIRCUIT ID	KXIP300408
IP ADDRESS	10.227.110.1

"PLATFORM 1 HP ISDN"
01-202-660888
"PLATFORM 2 HP ISDN"
01-202-660968

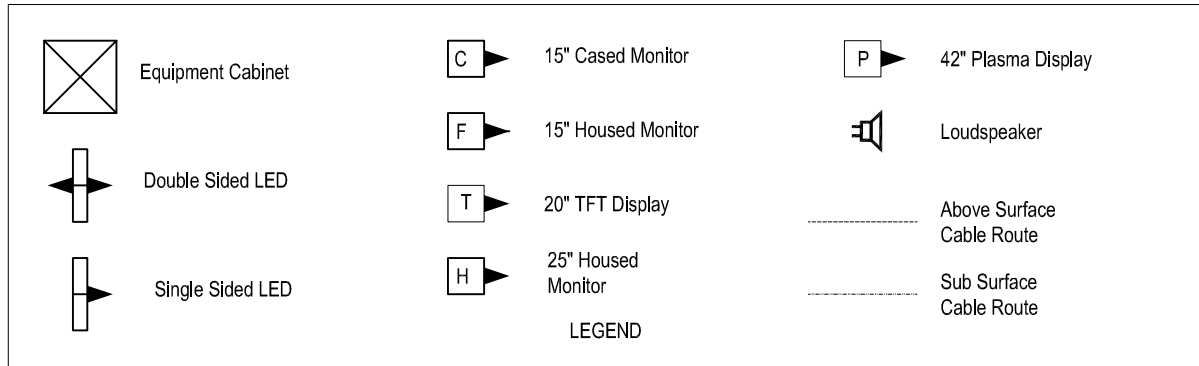

Equipment	Dist Board
EXISTING DB USED - NOT LABELED	

All Equipment tags to be prefixed with "CLA-"

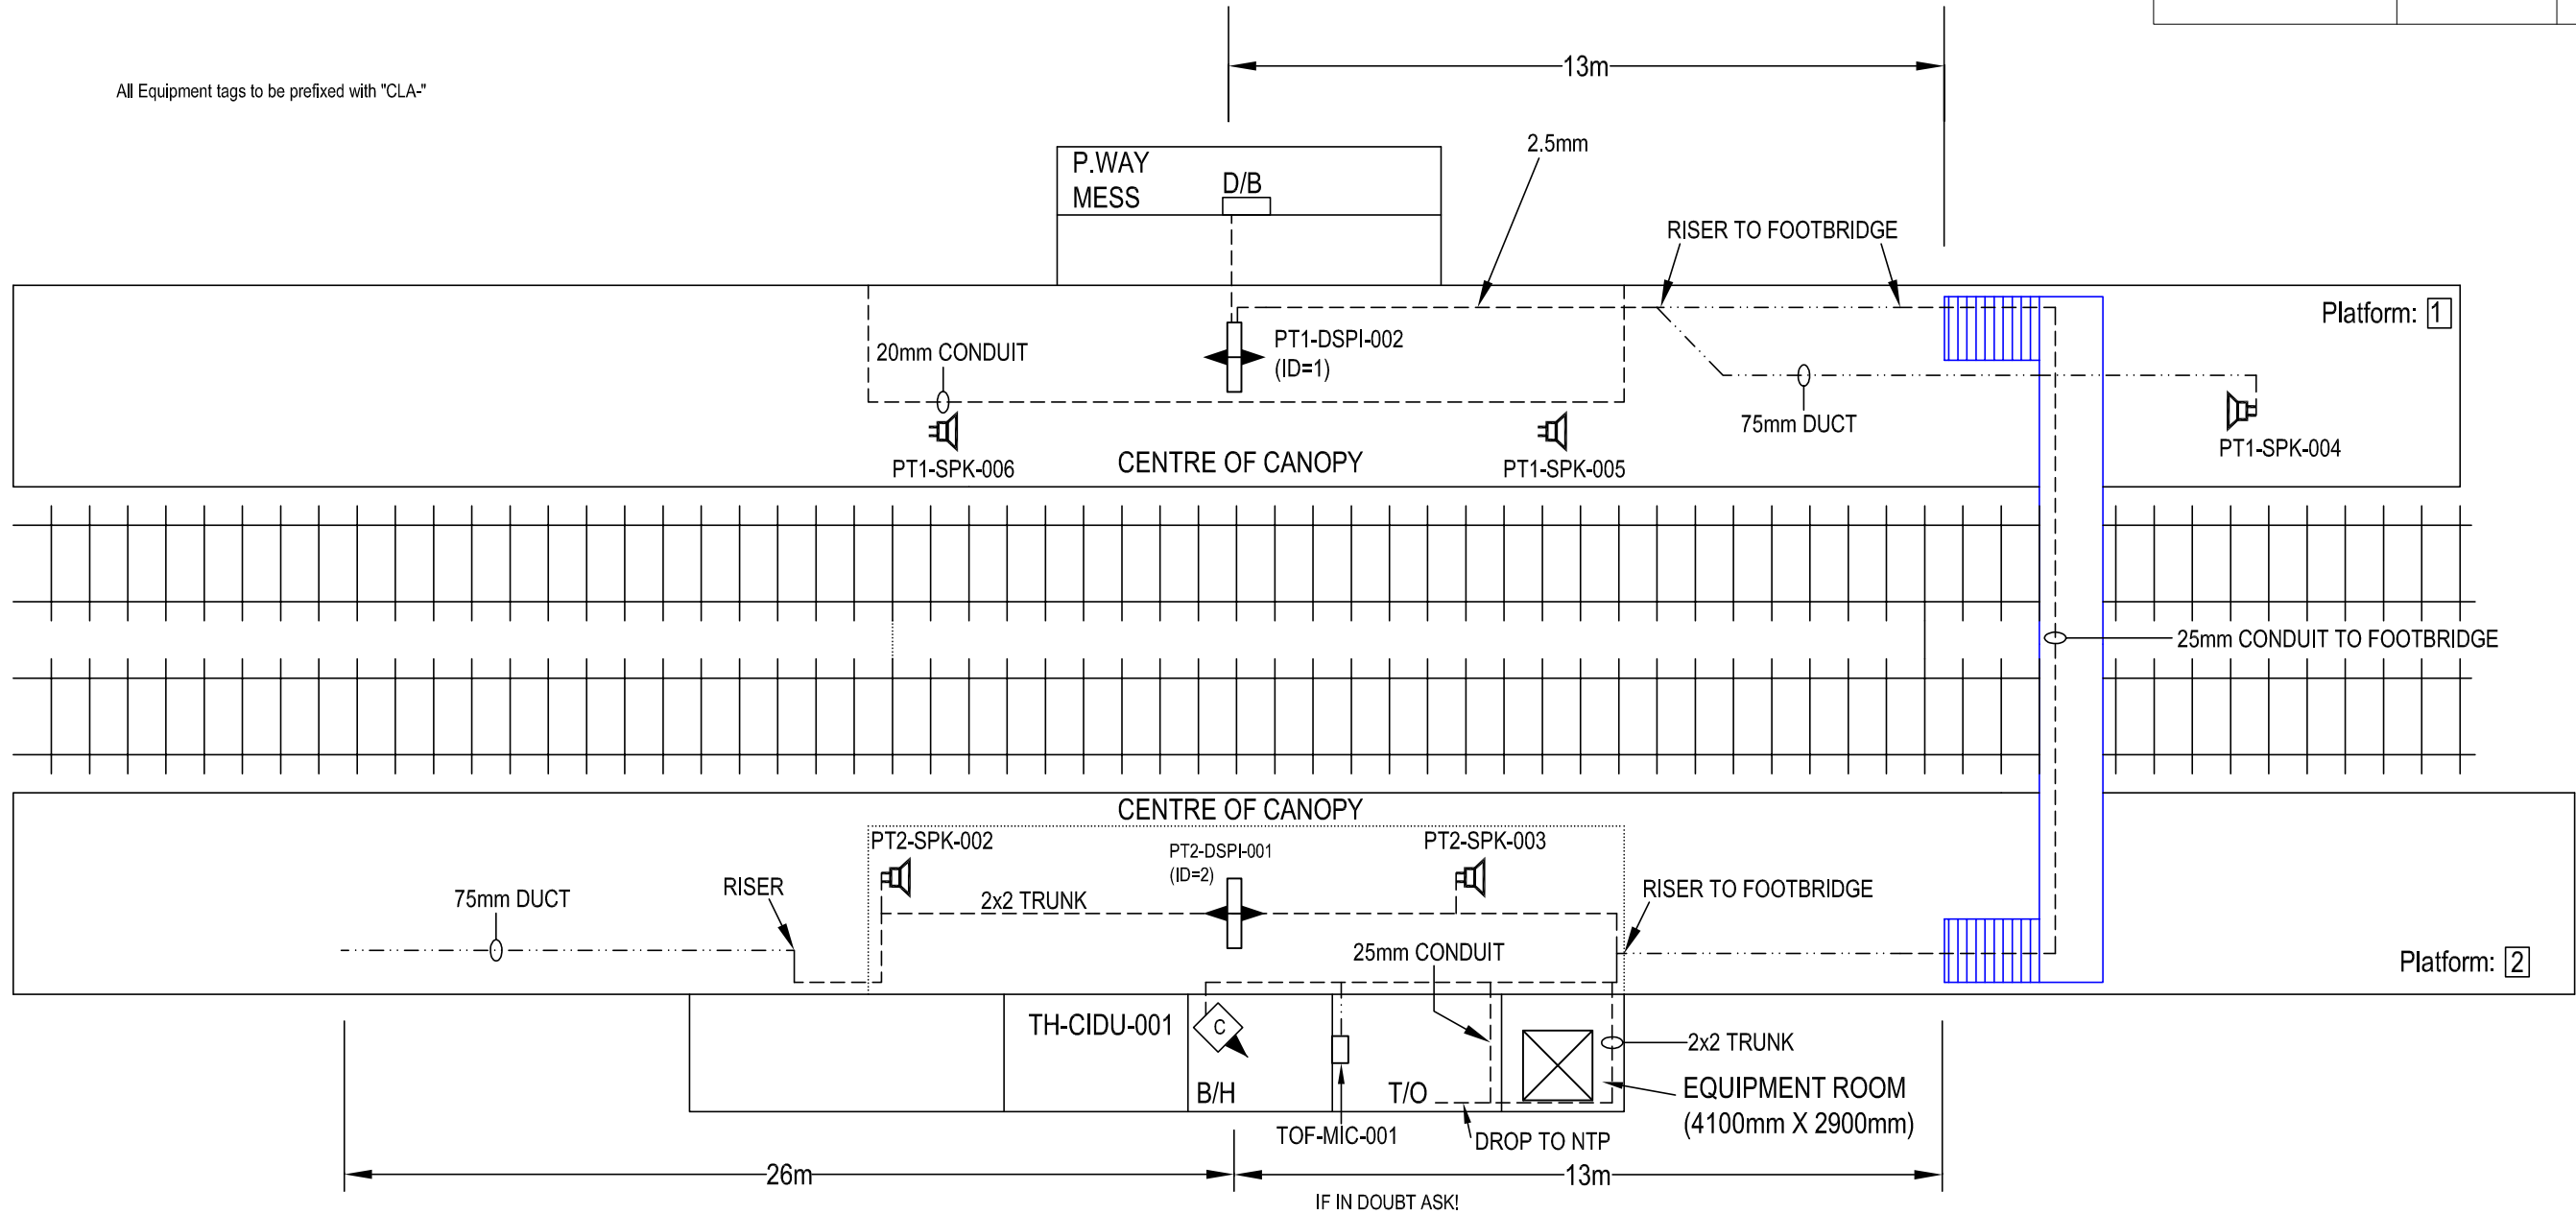

Date of Last Modification: 25 April 2003

This Drawing Supersedes Any Previous Drawings

CONSTRUCTION

	NAME	SIGNATURE	DATE
DRAWN BY	J STEVENS		25-04 -2003
CHECKED BY	T WONG		
APPD BY	A SMITH		
APPD BY			
CAD Ref:			
CONTRACTOR'S Ref:			



AMEY DATEL Project
 Offices
 1st Floor, Platform
 2/3
 Eastleigh Station
 Southampton Road
 Eastleigh
 Hants
 SO50 9FL

SITE/PROJECT

SOUTH WEST TRAINS CIS PROJECT

TITLE

CLANDON
 AS BUILT

SCALE
 NTS

DRG No.

SM803-75555

ISSUE
 C

SHEET
 1 of 1

COPYRIGHT © AMEY Rail
 All rights reserved. Neither this drawing or any of the information it contains may be copied or communicated to third parties without the written permission of the copyright holder