


DRG No.

SM803-75556


WAN	
CIRCUIT ID	KXIP300409
IP ADDRESS	10.227.111.1


"PLATFORM 1 HP ISDN"
01-372-464063
"PLATFORM 2 HP ISDN"
01-327-462404

All Equipment tags to be prefixed with "CLG-"

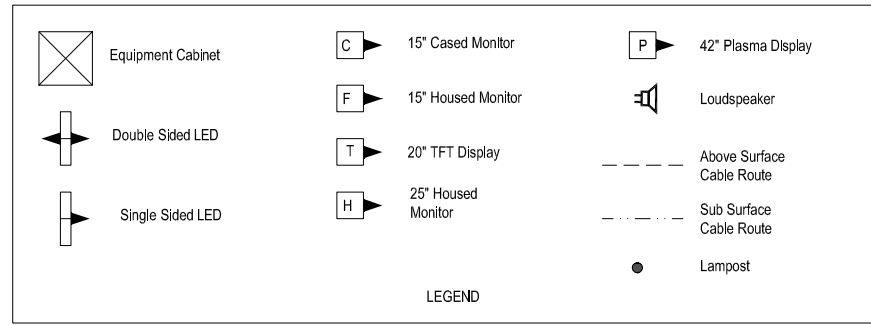

Equipment	Dist Board
TH-FIDU-001	GP1 CCT 11
CIS RACK	GP1 CCT 8
PT1-DSP1-001	GP1
PT2-DSP1-002	GP1

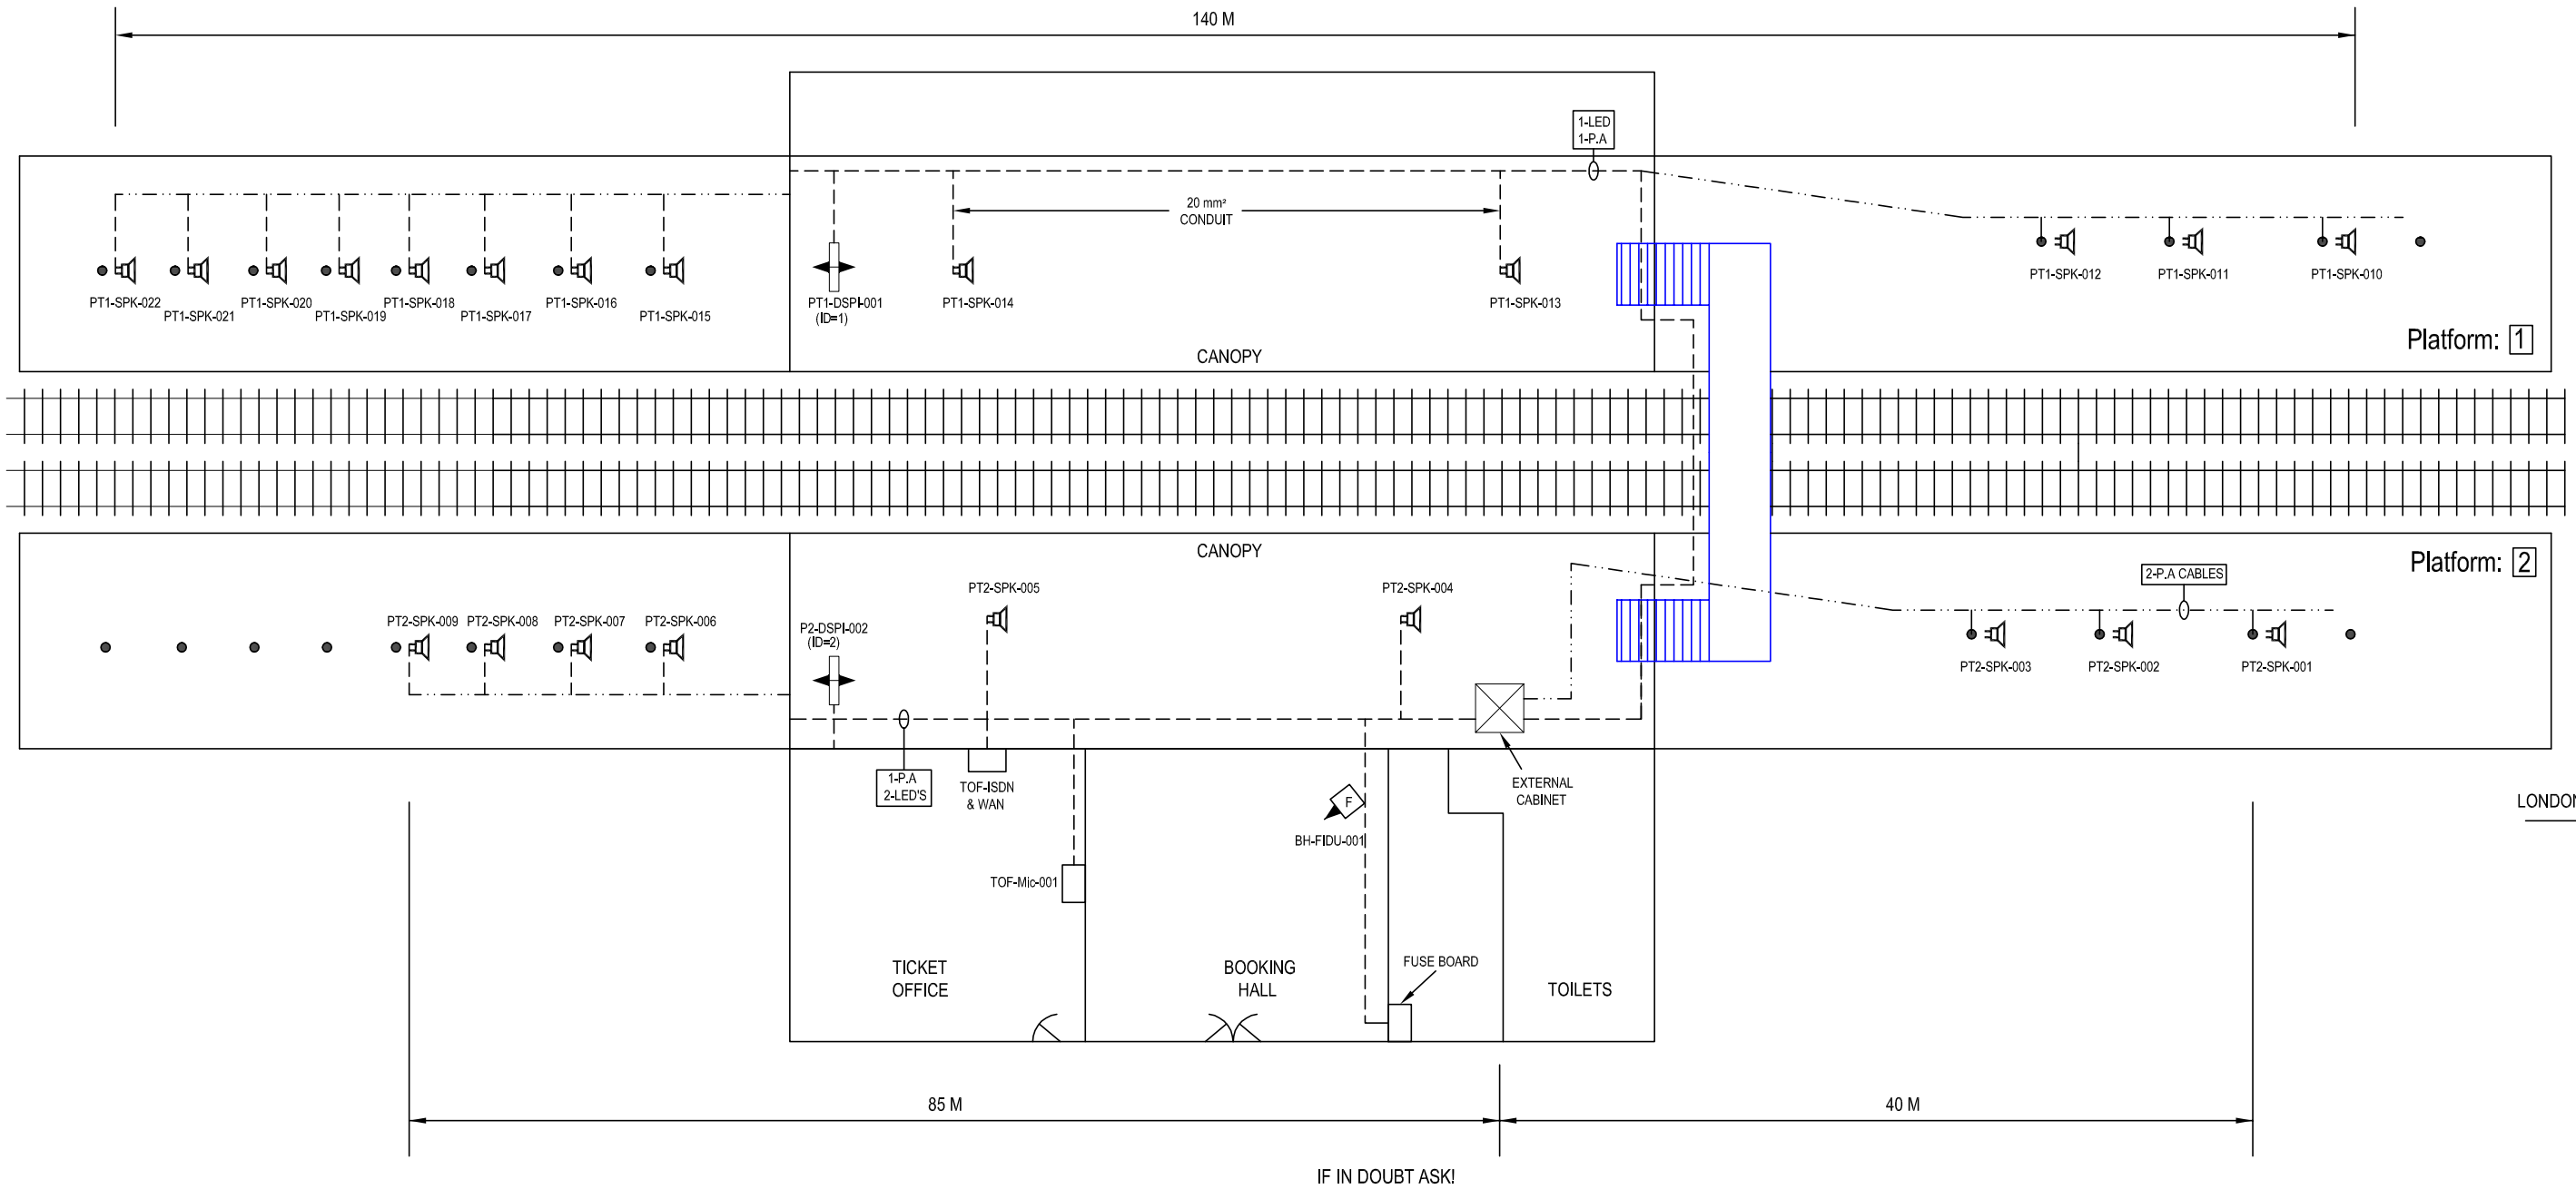

MATERIAL	CONSTRUCTION	NAME	SIGNATURE	DATE	 <p>AMEY DATEL Project Offices 1st Floor, Platform 2/3 Eastleigh Station Southampton Road Eastleigh Hants SO50 9FL</p>	SITE/PROJECT		
		DRAWN BY	D GADDU	14-05-2002		SOUTH WEST TRAINS CIS PROJECT		
FINISH	CONSTRUCTION	CHECKED BY	T WONG		<p>COPYRIGHT © AMEY Rail All rights reserved. Neither this drawing or any of the information it contains may be copied or communicated to third parties without the written permission of the copyright holder</p>	TITLE		
		APPD BY	A SMITH			CLAYGATE AS BUILT		
		CAD Ref:			SCALE	DRG No.	ISSUE	SHEET
		CONTRACTOR'S Ref:			NTS	SM803-75556	B	1 of 1