



WAN	
CIRCUIT ID	KXIP400464
IP ADDRESS	10.227.106.1


"PLATFORM 1 HP ISDN"
01-590-681824
"PLATFORM 2 HP ISDN"
01-590-681851

All Equipment tags to be prefixed with "CSN-"

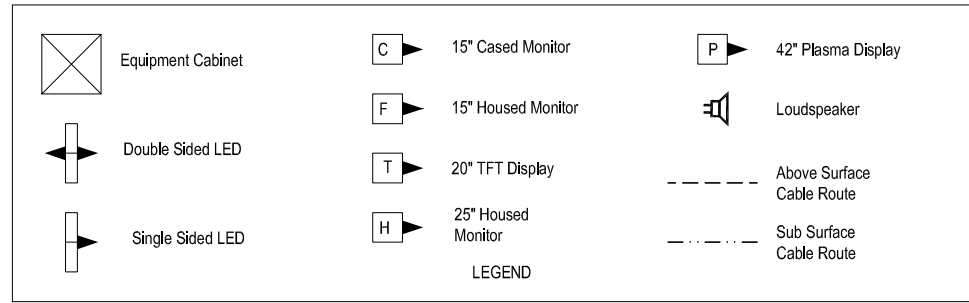

Equipment	Dist Board	
CIS RACK	CIS DB CCT1	16A
PT1-DSPI-001	CIS DB CCT2	16A
PT2-DSPI-002	CIS DB CCT3	16A
TOF-CIDU-001	GP1 CCT3 RCD	20mA

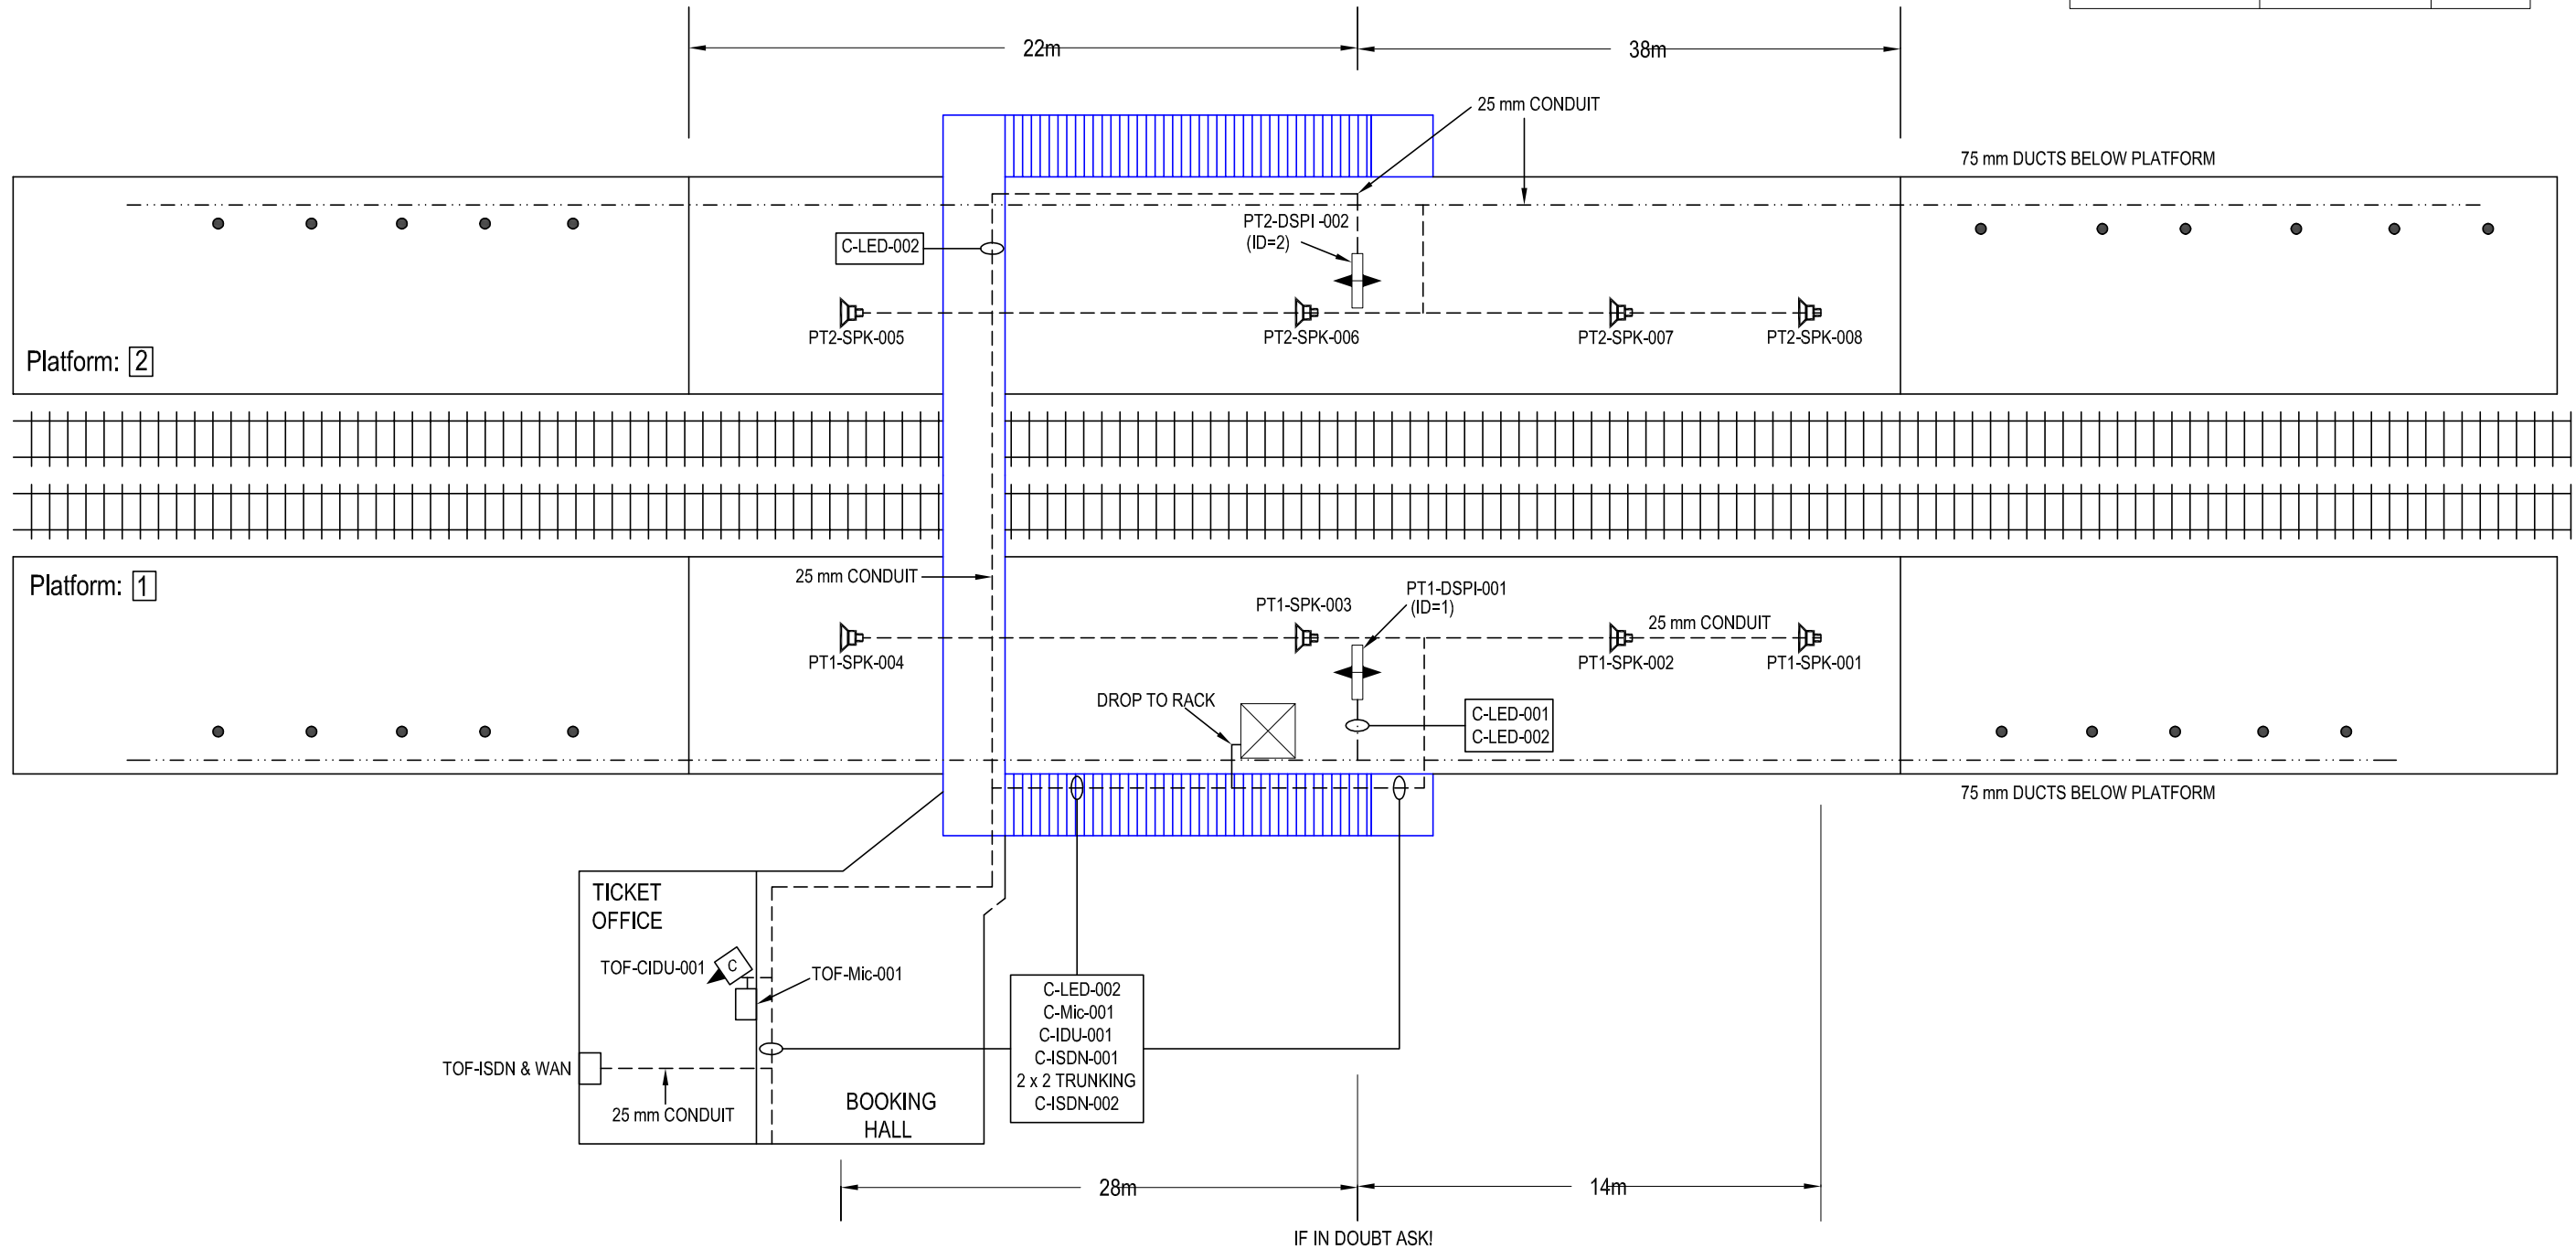

MATERIAL	CONSTRUCTION	NAME	SIGNATURE	DATE	 AMEY DATEL Project Offices 1st Floor, Platform 2/3 Eastleigh Station Southampton Road Eastleigh Hants SO50 9FL	SITE/PROJECT			
		DRAWN BY	D GADDU	17-05-2002		SOUTH WEST TRAINS CIS PROJECT			
FINISH	CONSTRUCTION	CHECKED BY	T WONG		COPYRIGHT © AMEY Rail All rights reserved. Neither this drawing or any of the information it contains may be copied or communicated to third parties without the written permission of the copyright holder	TITLE			
		APPD BY	A SMITH			CHESSINGTON NORTH AS BUILT			
		CAD Ref:				SCALE	DRG No.	ISSUE	SHEET
		CONTRACTOR'S Ref:				NTS	SM803-75582	B	1 of 1