


SM803-75554



WAN	
CIRCUIT ID	KXIP600384
IP ADDRESS	10.227.107.1

"PLATFORM 1 HP ISDN"
020-83915239

All Equipment tags to be prefixed with "CSS-"

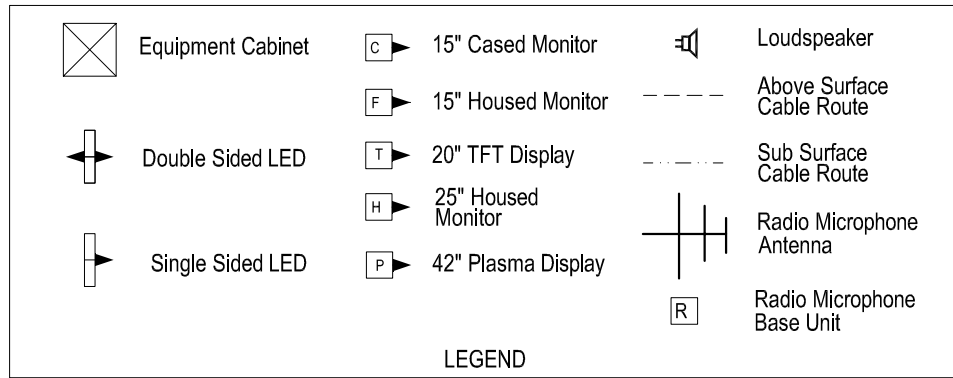

Equipment	Dist Board	
CIS RACK	GP1	CCT 11
PT1-DSPI-001	GP1	CCT 10
TH-SSPI-001	GP1	CCT 10

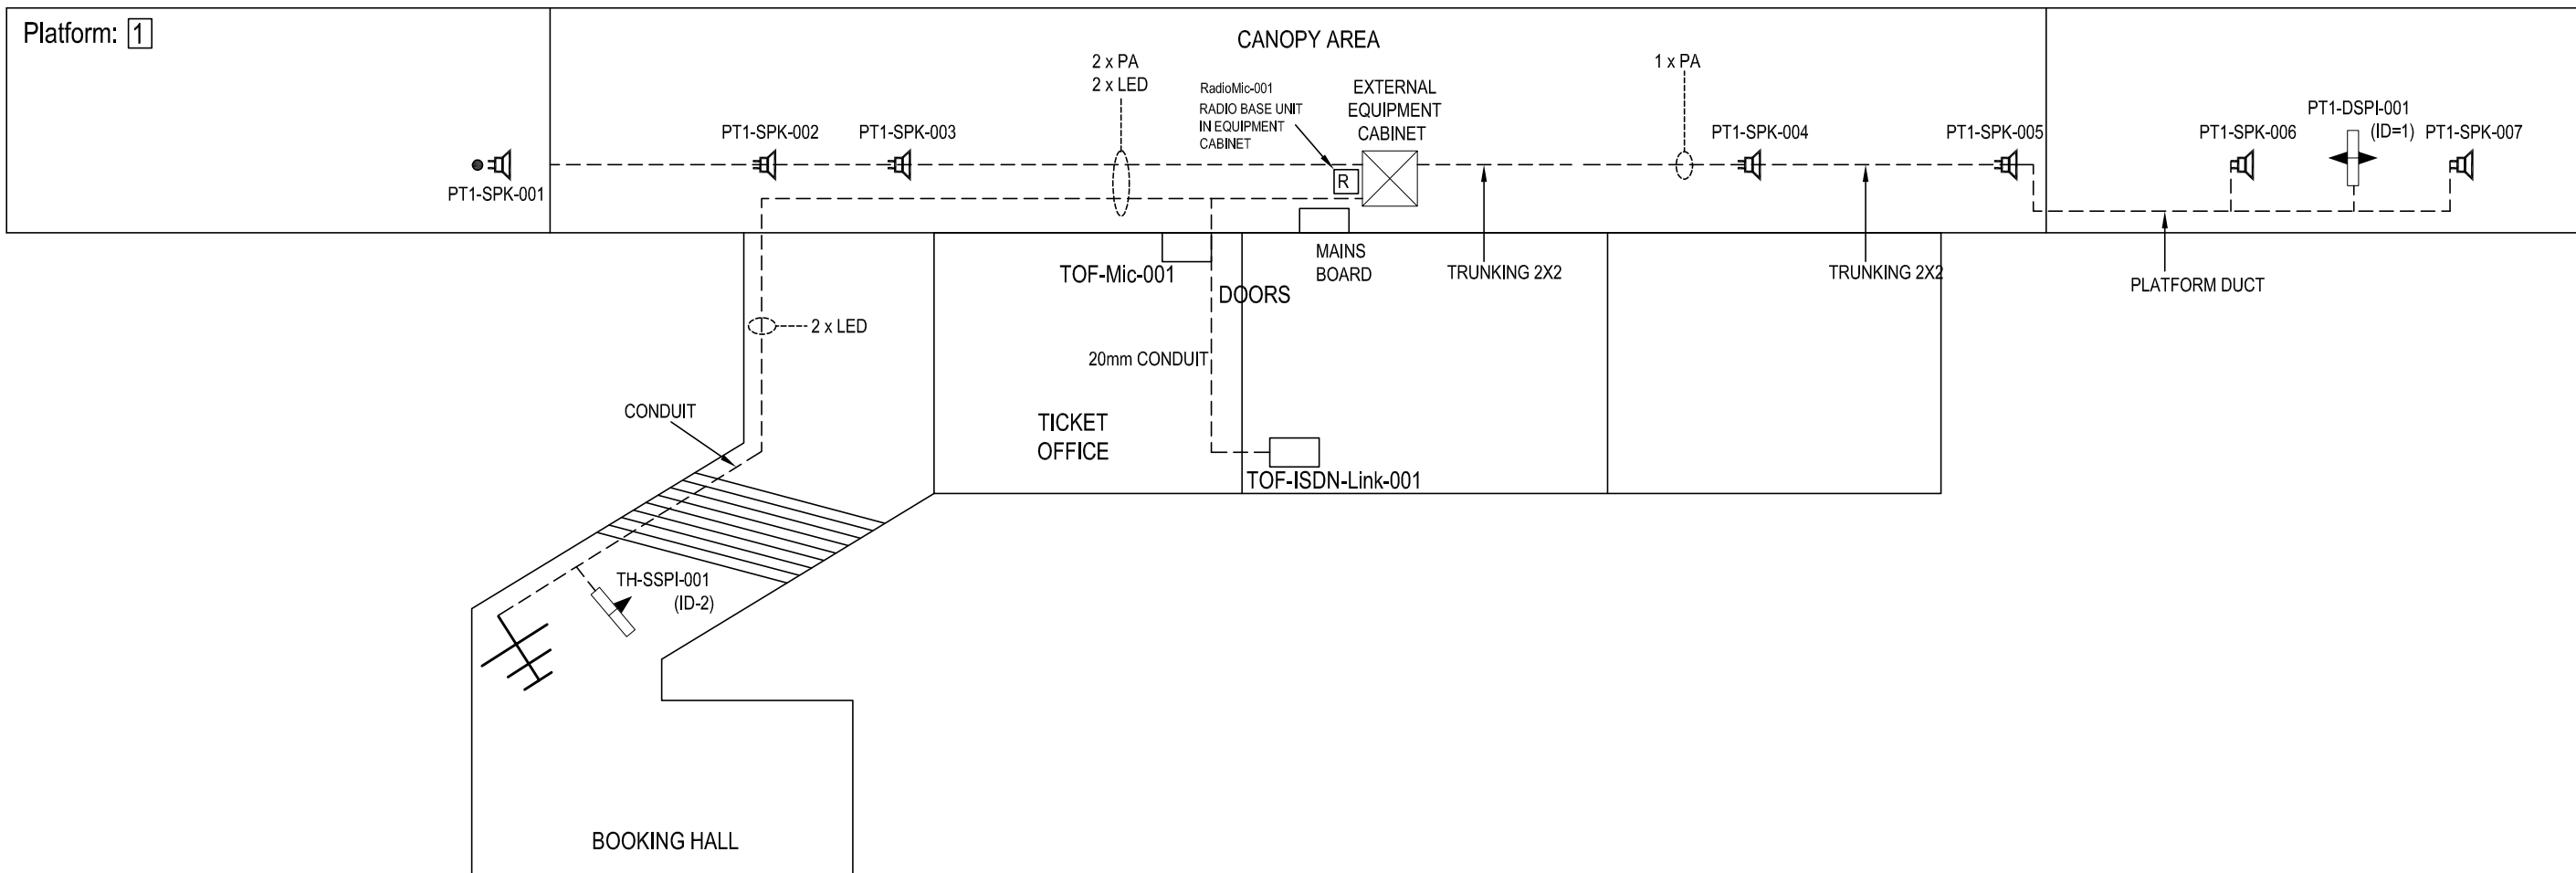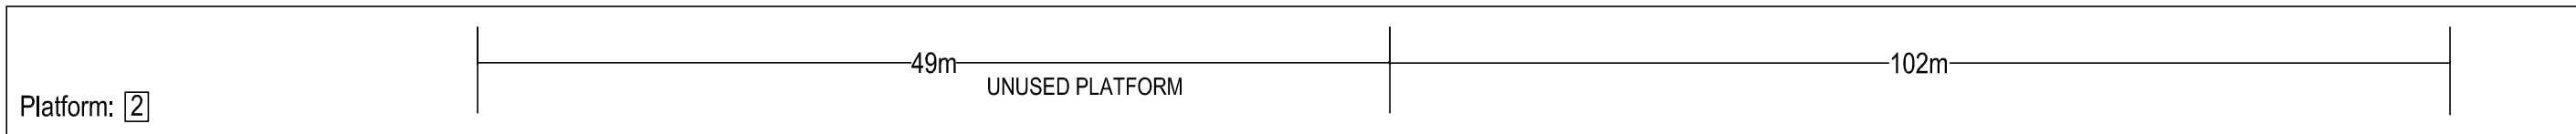

IF IN DOUBT ASK!

MATERIAL	CONSTRUCTION	DRAWN BY	D GADDU	SIGNATURE		AMEY DATEL Project Offices 1st Floor, Platform 2/3 Eastleigh Station Southampton Road Eastleigh Hants SO50 9FL	SITE/PROJECT		SOUTH WEST TRAINS CIS PROJECT	
		CHECKED BY	T WONG	DATE	01-04-2002		TITLE	CHESSINGTON SOUTH AS BUILT		
FINISH	CONSTRUCTION	APPD BY	A SMITH				SCALE	DRG No.	ISSUE	SHEET
		CAD Ref:					NTS	SM803-75554	B	1 of 1
		CONTRACTOR'S Ref:					COPYRIGHT © AMEY Rail All rights reserved. Neither this drawing or any of the information it contains may be copied or communicated to third parties without the written permission of the copyright holder			