



WAN	
CIRCUIT ID	KXIP 300413
IP ADDRESS	10.227.137.1

"PLATFORM 1 HP ISDN"
01753-540059
"PLATFORM 1 HP ISDN"
01753-540068

All Equipment tags to be prefixed with "DAT-"

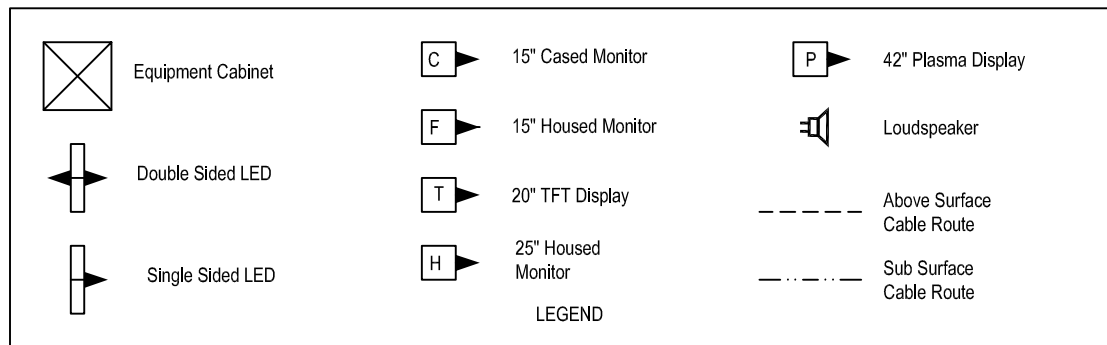

Equipment	Dist Board
SKT	1
CIS	2
HEAT	3
VENT	4
BOOKING HALL MONITOR	5
LED PT1	6
DSPI-001	
PT1 DISTRIBUTION BOARD	

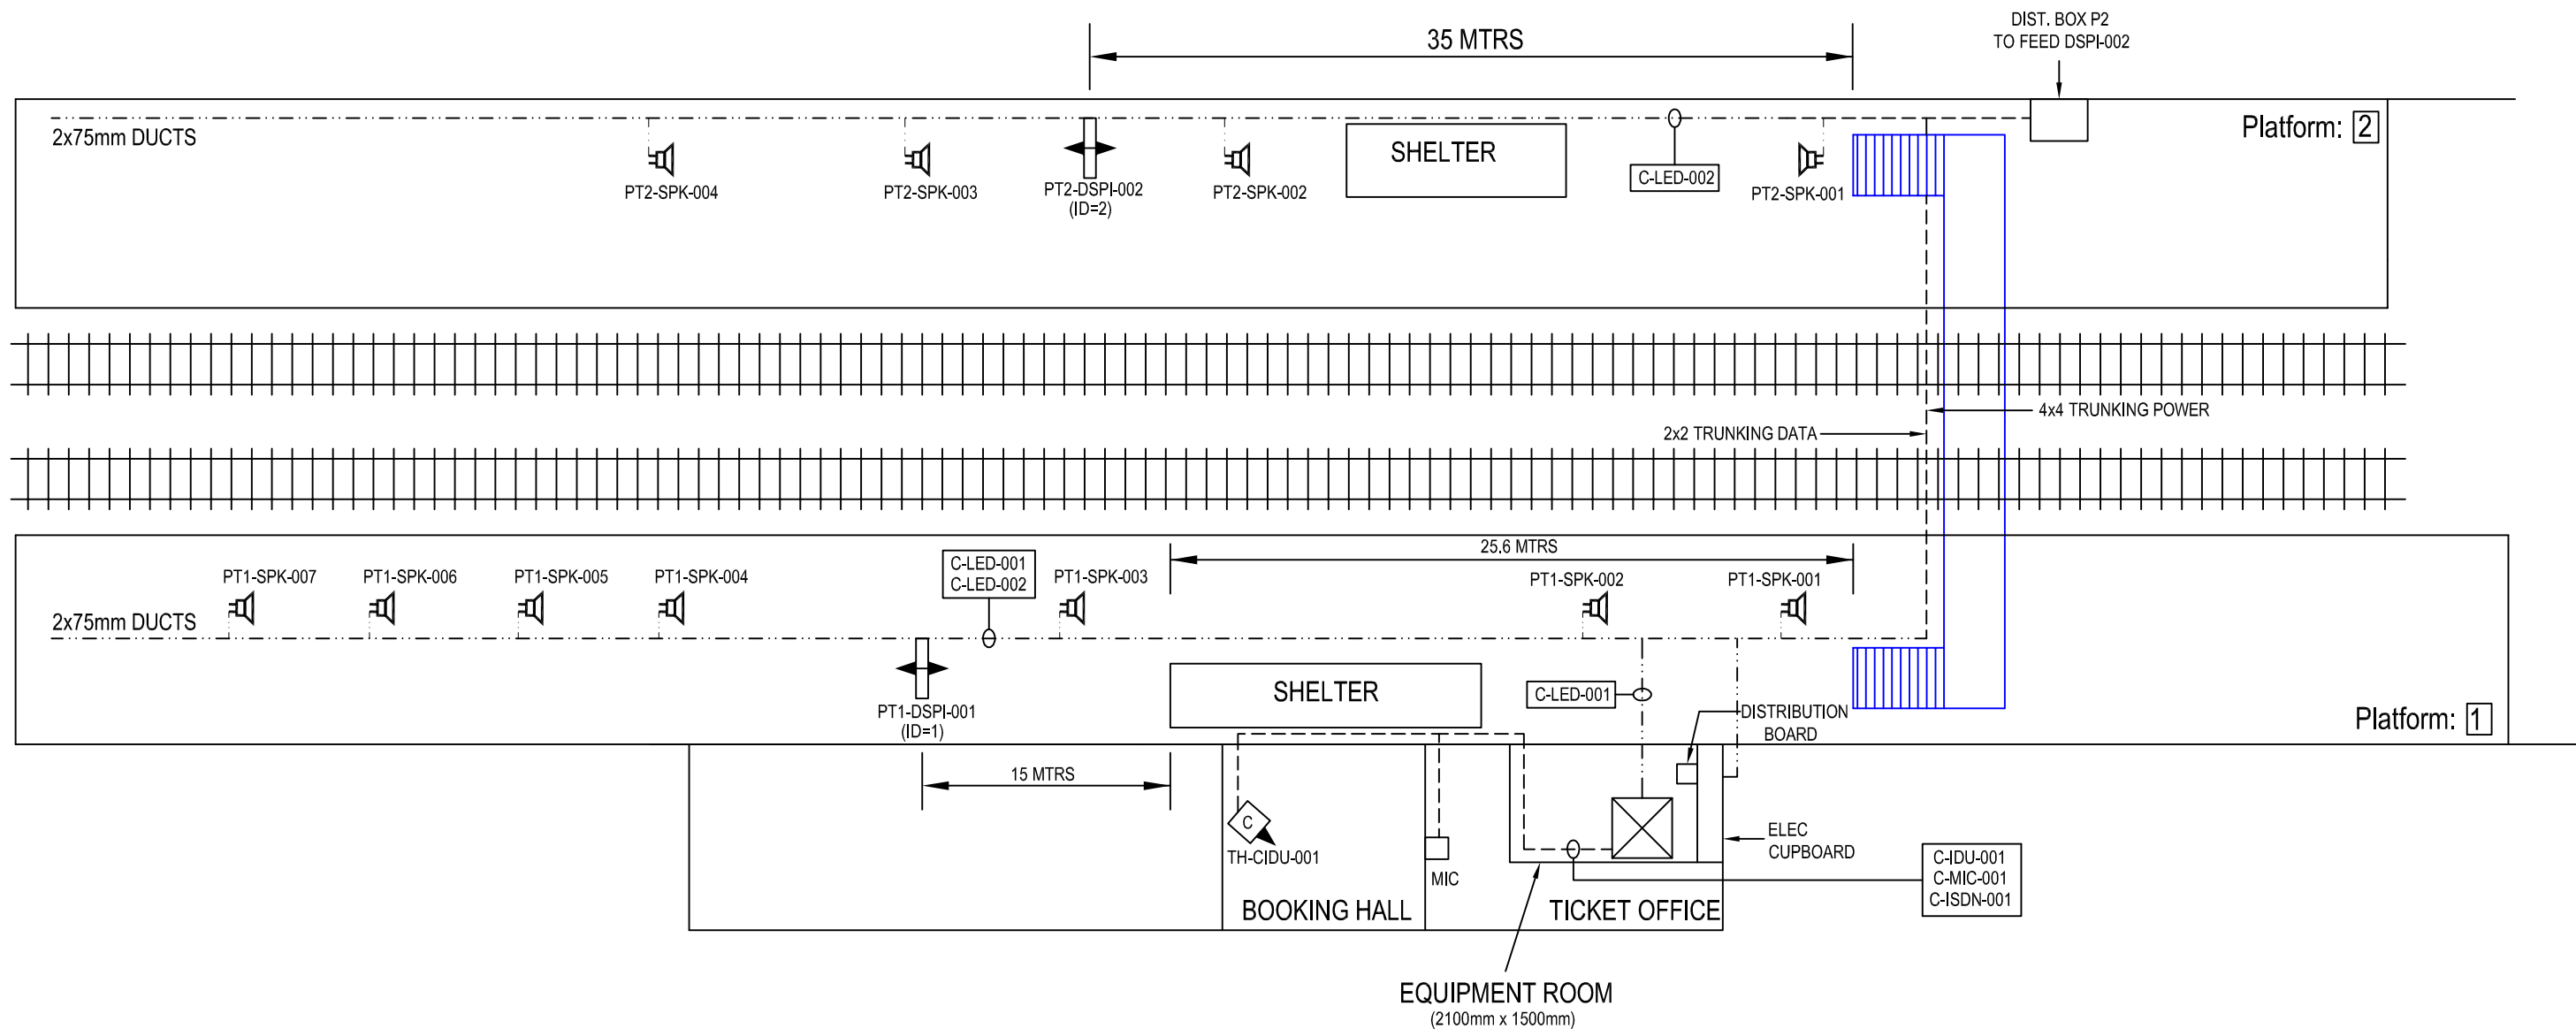

IF IN DOUBT ASK!

MATERIAL	CONSTRUCTION	DRAWN BY	D GADDU	SIGNATURE		<p>AMEY DATEL Project Offices 1st Floor, Platform 2/3 Eastleigh Station Southampton Road Eastleigh Hants SO50 9FL</p>	SITE/PROJECT		SOUTH WEST TRAINS CIS PROJECT	
		CHECKED BY	T WONG				TITLE	DATCHET AS BUILT		
FINISH		APPD BY	A SMITH			<p>COPYRIGHT © AMEY Rail All rights reserved. Neither this drawing or any of the information it contains may be copied or communicated to third parties without the written permission of the copyright holder</p>	SCALE	DRG No.	ISSUE	SHEET
		CONTRACTOR'S Ref:					NTS	SM803-75668	B	1 of 1