



WAN	
CIRCUIT ID	KXIP 300414
IP ADDRESS	10.227.138.1

"PLATFORM 1 HP ISDN"
01-305-264982
"PLATFORM 2 HP ISDN"
01-305-264083

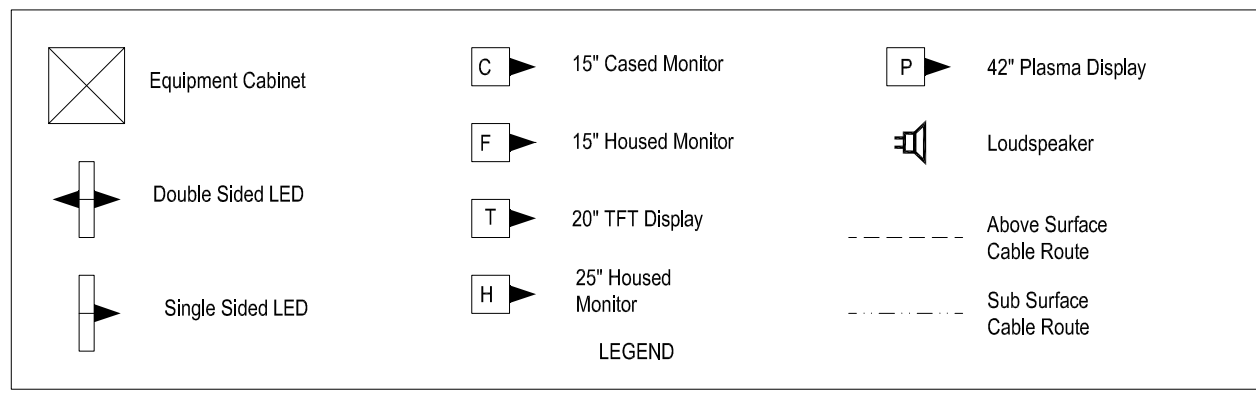

Equipment	Dist Board
EXISTING CCT BK 5	DIST BRD NO.2 CIS RACK

All Equipment tags to be prefixed with "DCH-"

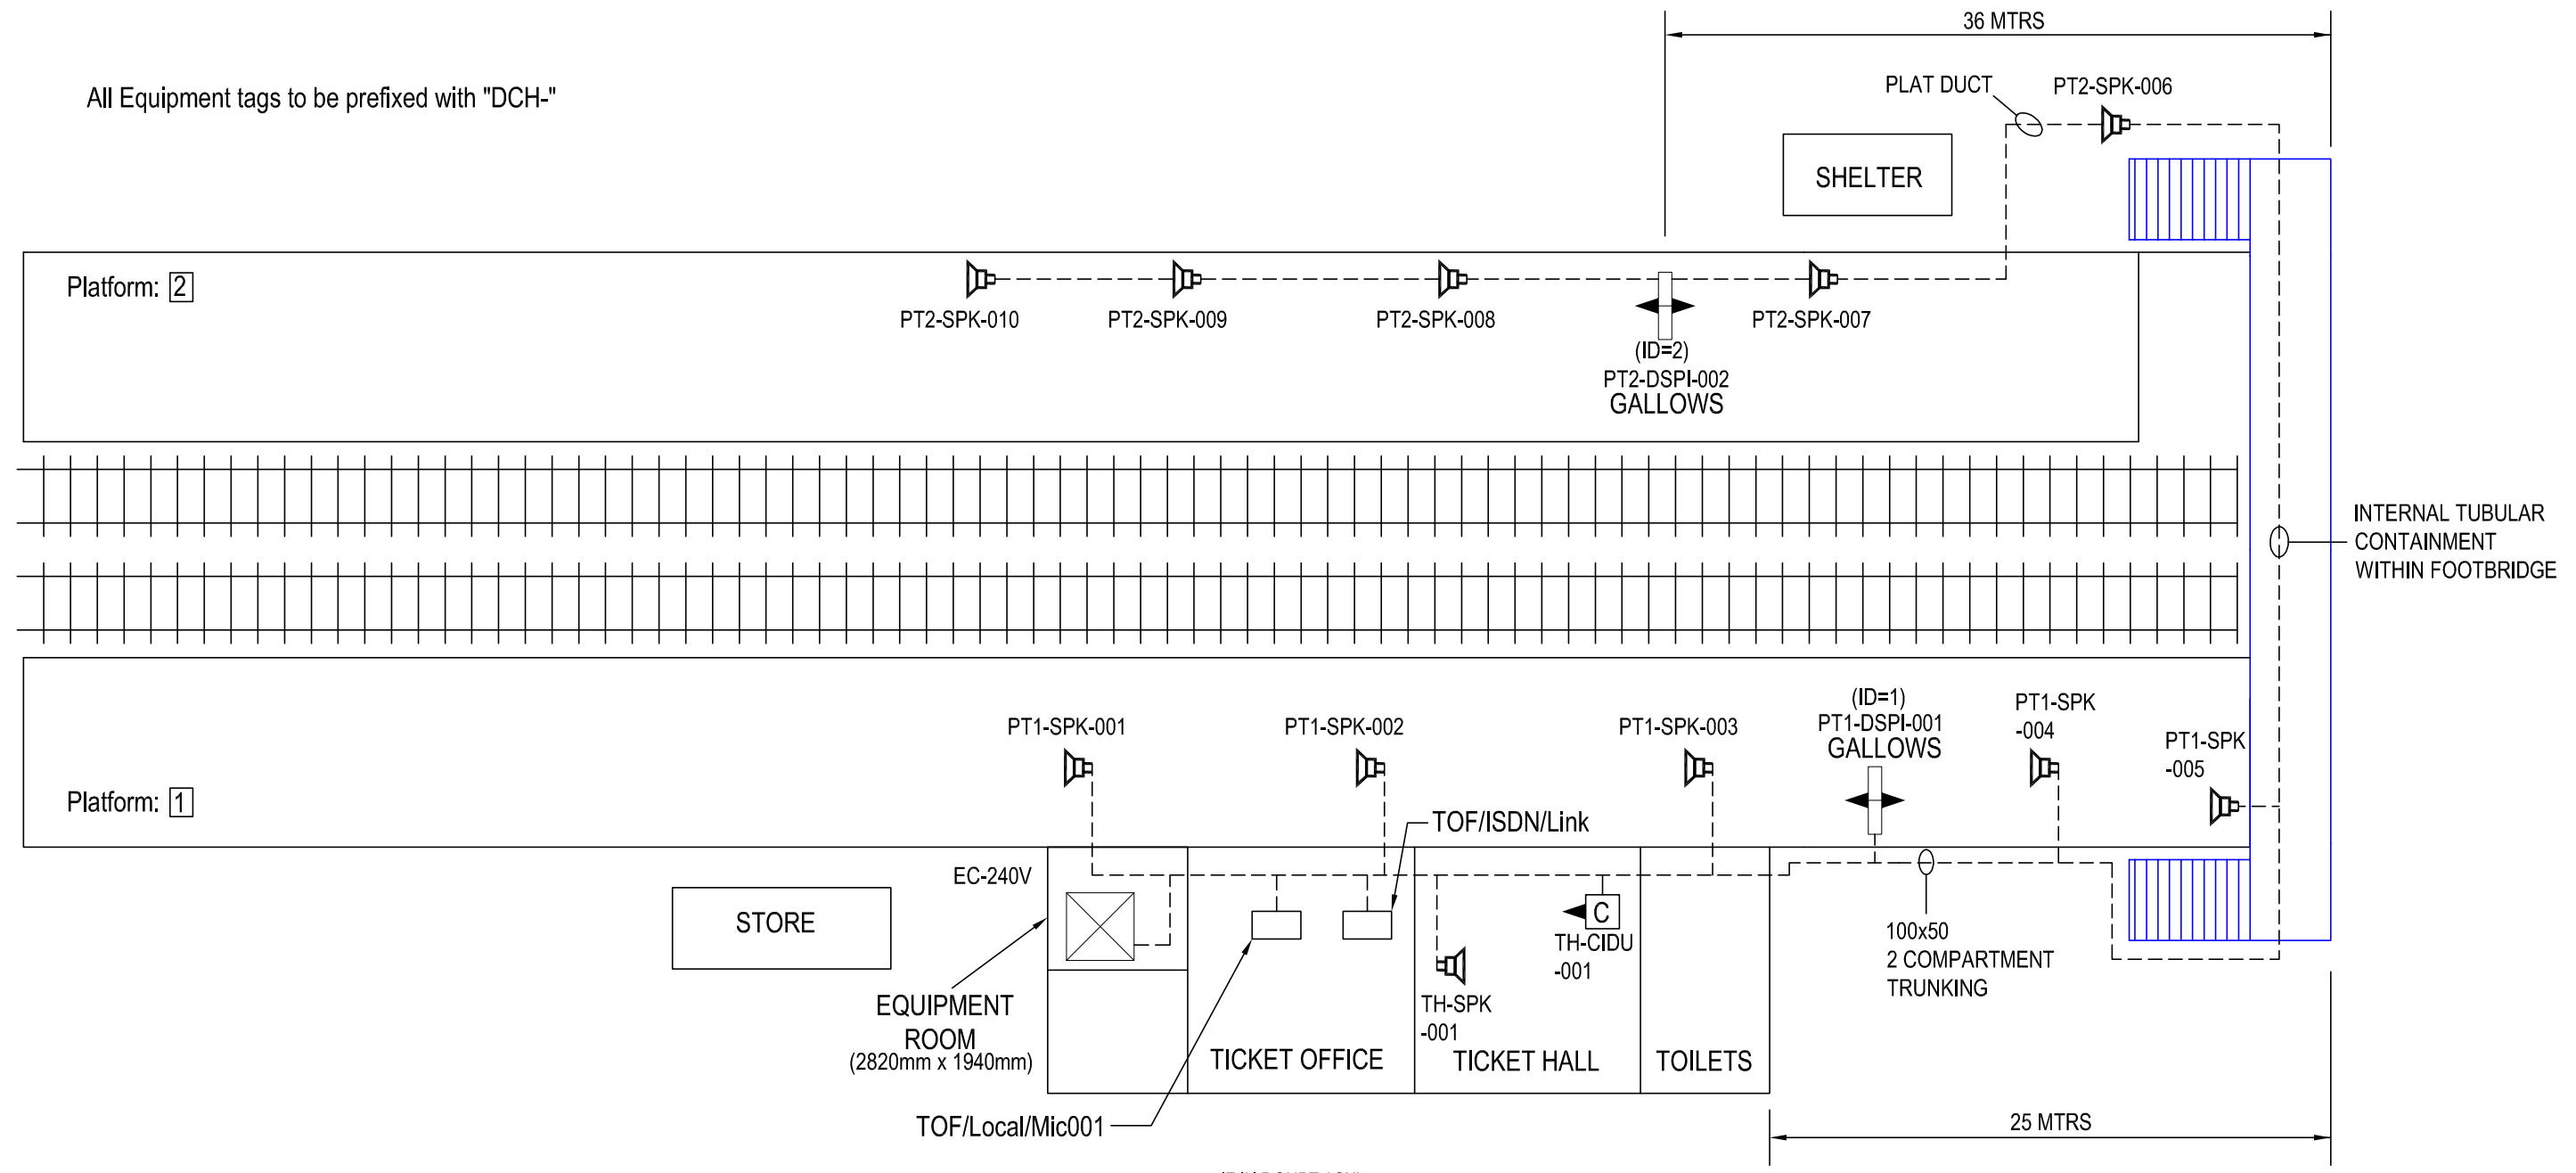

MATERIAL	CONSTRUCTION	NAME	SIGNATURE	DATE	<p>AMEY DATEL Project Offices 1st Floor, Platform 2/3 Eastleigh Station Southampton Road Eastleigh Hants SO50 9FL</p>	SITE/PROJECT		
		DRAWN BY		22-01-2002		SOUTH WEST TRAINS CIS PROJECT		
FINISH		CHECKED BY			<p>Copyright © AMEY Rail All rights reserved. Neither this drawing or any of the information it contains may be copied or communicated to third parties without the written permission of the copyright holder</p>	TITLE		
		APPD BY				DORCHESTER SOUTH AS BUILT		
		CAD Ref:			SCALE	DRG No.	ISSUE	SHEET
		CONTRACTOR'S Ref:			NTS	SM803-75961	B	1 of 1