



WAN	
CIRCUIT ID	KXIP300416
IP ADDRESS	10.227.120.1

"PLATFORM 1 HP ISDN"
020-88701308
"PLATFORM 2 HP ISDN"
020-8870-9271

All Equipment tags to be prefixed with "EAD-"

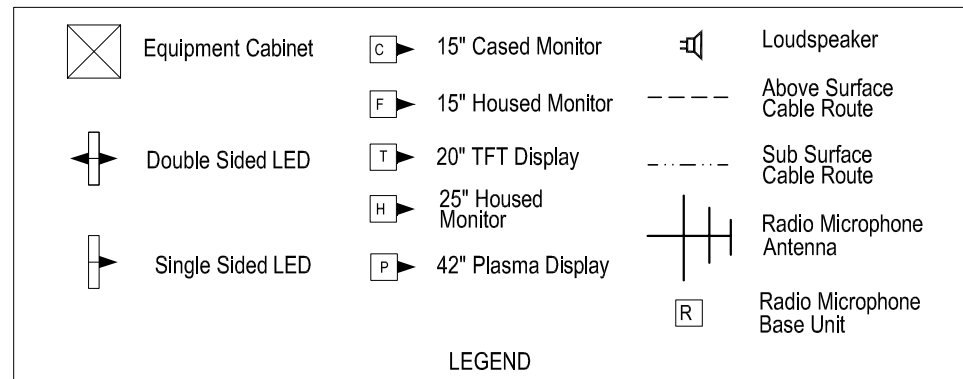

Equipment	Dist Board
TOF-CIDU-001	EXISTING SPUR
TH-HIDU-001	EXISTING SPUR
PT1-DSPI-001	MAIN DB AT BOTTOM OF PT2/3 STAIRS
PT2-DSPI-002	
PT2-DSPI-003	
PT3-DSPI-004	DP2 IN S.O.

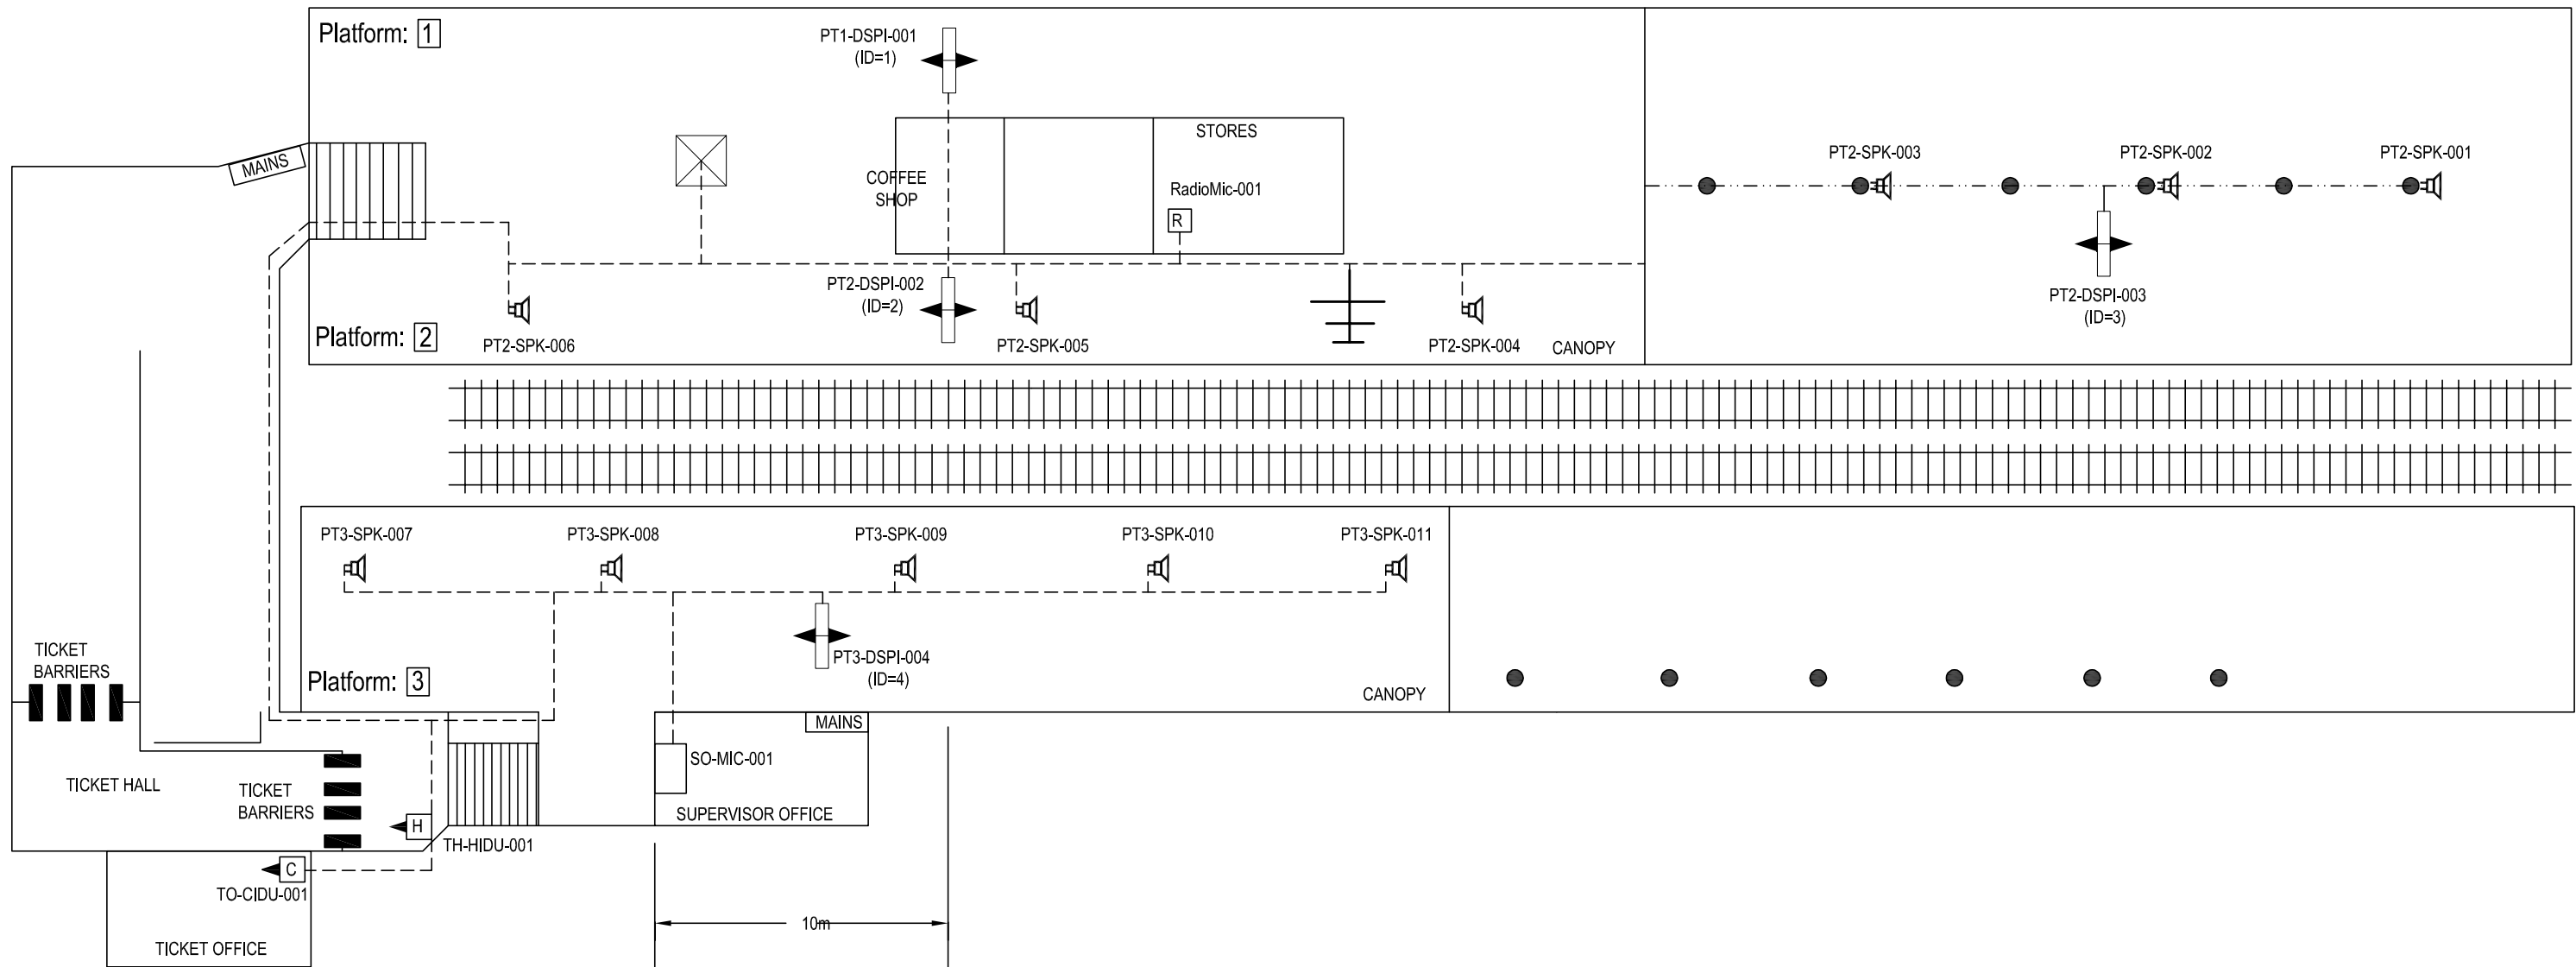

IF IN DOUBT ASK!

Date of Last Modification: 25 April 2003	CONSTRUCTION	<table border="1"> <thead> <tr> <th></th> <th>NAME</th> <th>SIGNATURE</th> <th>DATE</th> </tr> </thead> <tbody> <tr> <td>DRAWN BY</td> <td>J STEVENS</td> <td></td> <td>25-04-2003</td> </tr> <tr> <td>CHECKED BY</td> <td>T WONG</td> <td></td> <td></td> </tr> <tr> <td>APPD BY</td> <td>A SMITH</td> <td></td> <td></td> </tr> <tr> <td>APPD BY</td> <td></td> <td></td> <td></td> </tr> </tbody> </table>					NAME	SIGNATURE	DATE	DRAWN BY	J STEVENS		25-04-2003	CHECKED BY	T WONG			APPD BY	A SMITH			APPD BY				AMEY DATEL Project Offices 1st Floor, Platform 2/3 Eastleigh Station Southampton Road Eastleigh Hants SO50 9FL		SITE/PROJECT		SOUTH WEST TRAINS CIS PROJECT	
			NAME	SIGNATURE	DATE																										
DRAWN BY	J STEVENS		25-04-2003																												
CHECKED BY	T WONG																														
APPD BY	A SMITH																														
APPD BY																															
This Drawing Supersedes Any Previous Drawings	FINISH	CAD Ref: CONTRACTOR'S Ref:						TITLE		EARLSFIELD AS BUILT																					
		COPYRIGHT © AMEY Rail All rights reserved. Neither this drawing or any of the information it contains may be copied or communicated to third parties without the written permission of the copyright holder		SCALE	DRG No.	ISSUE	SHEET	NTS	SM803-75584	C	1 of 1																				