


DRG No. SM803-75694


WAN Details	
CIRCUIT ID	KXIP300415
IP ADDRESS	10.227.139.1

"PLATFORM 1 HP ISDN"
01-189-351057
"PLATFORM 2 HP ISDN"
01-189-351124

All Equipment tags to be prefixed with "EAR-"

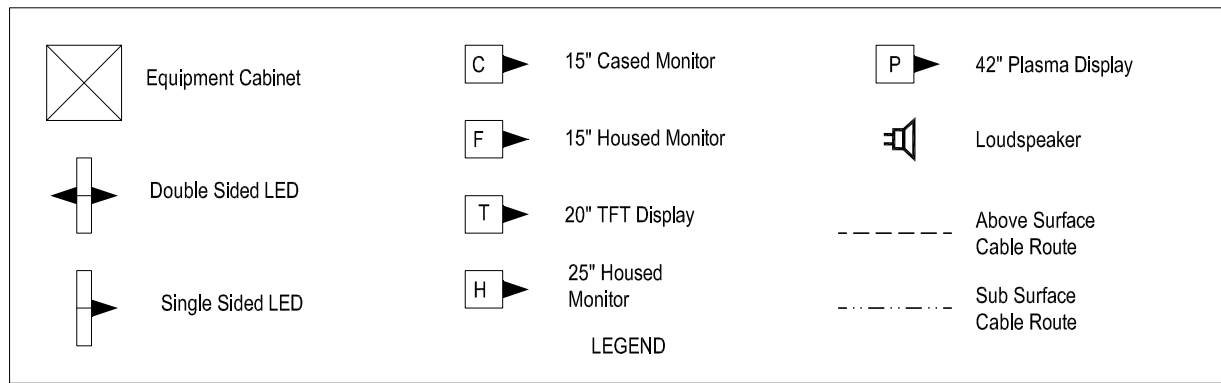

Equipment	Dist Board
PT1-DSPI-001	EXISTING
PT2-DSPI-002	EXISTING
TH-FDIU-001	EXISTING
CIS RACK	NEW BOARD

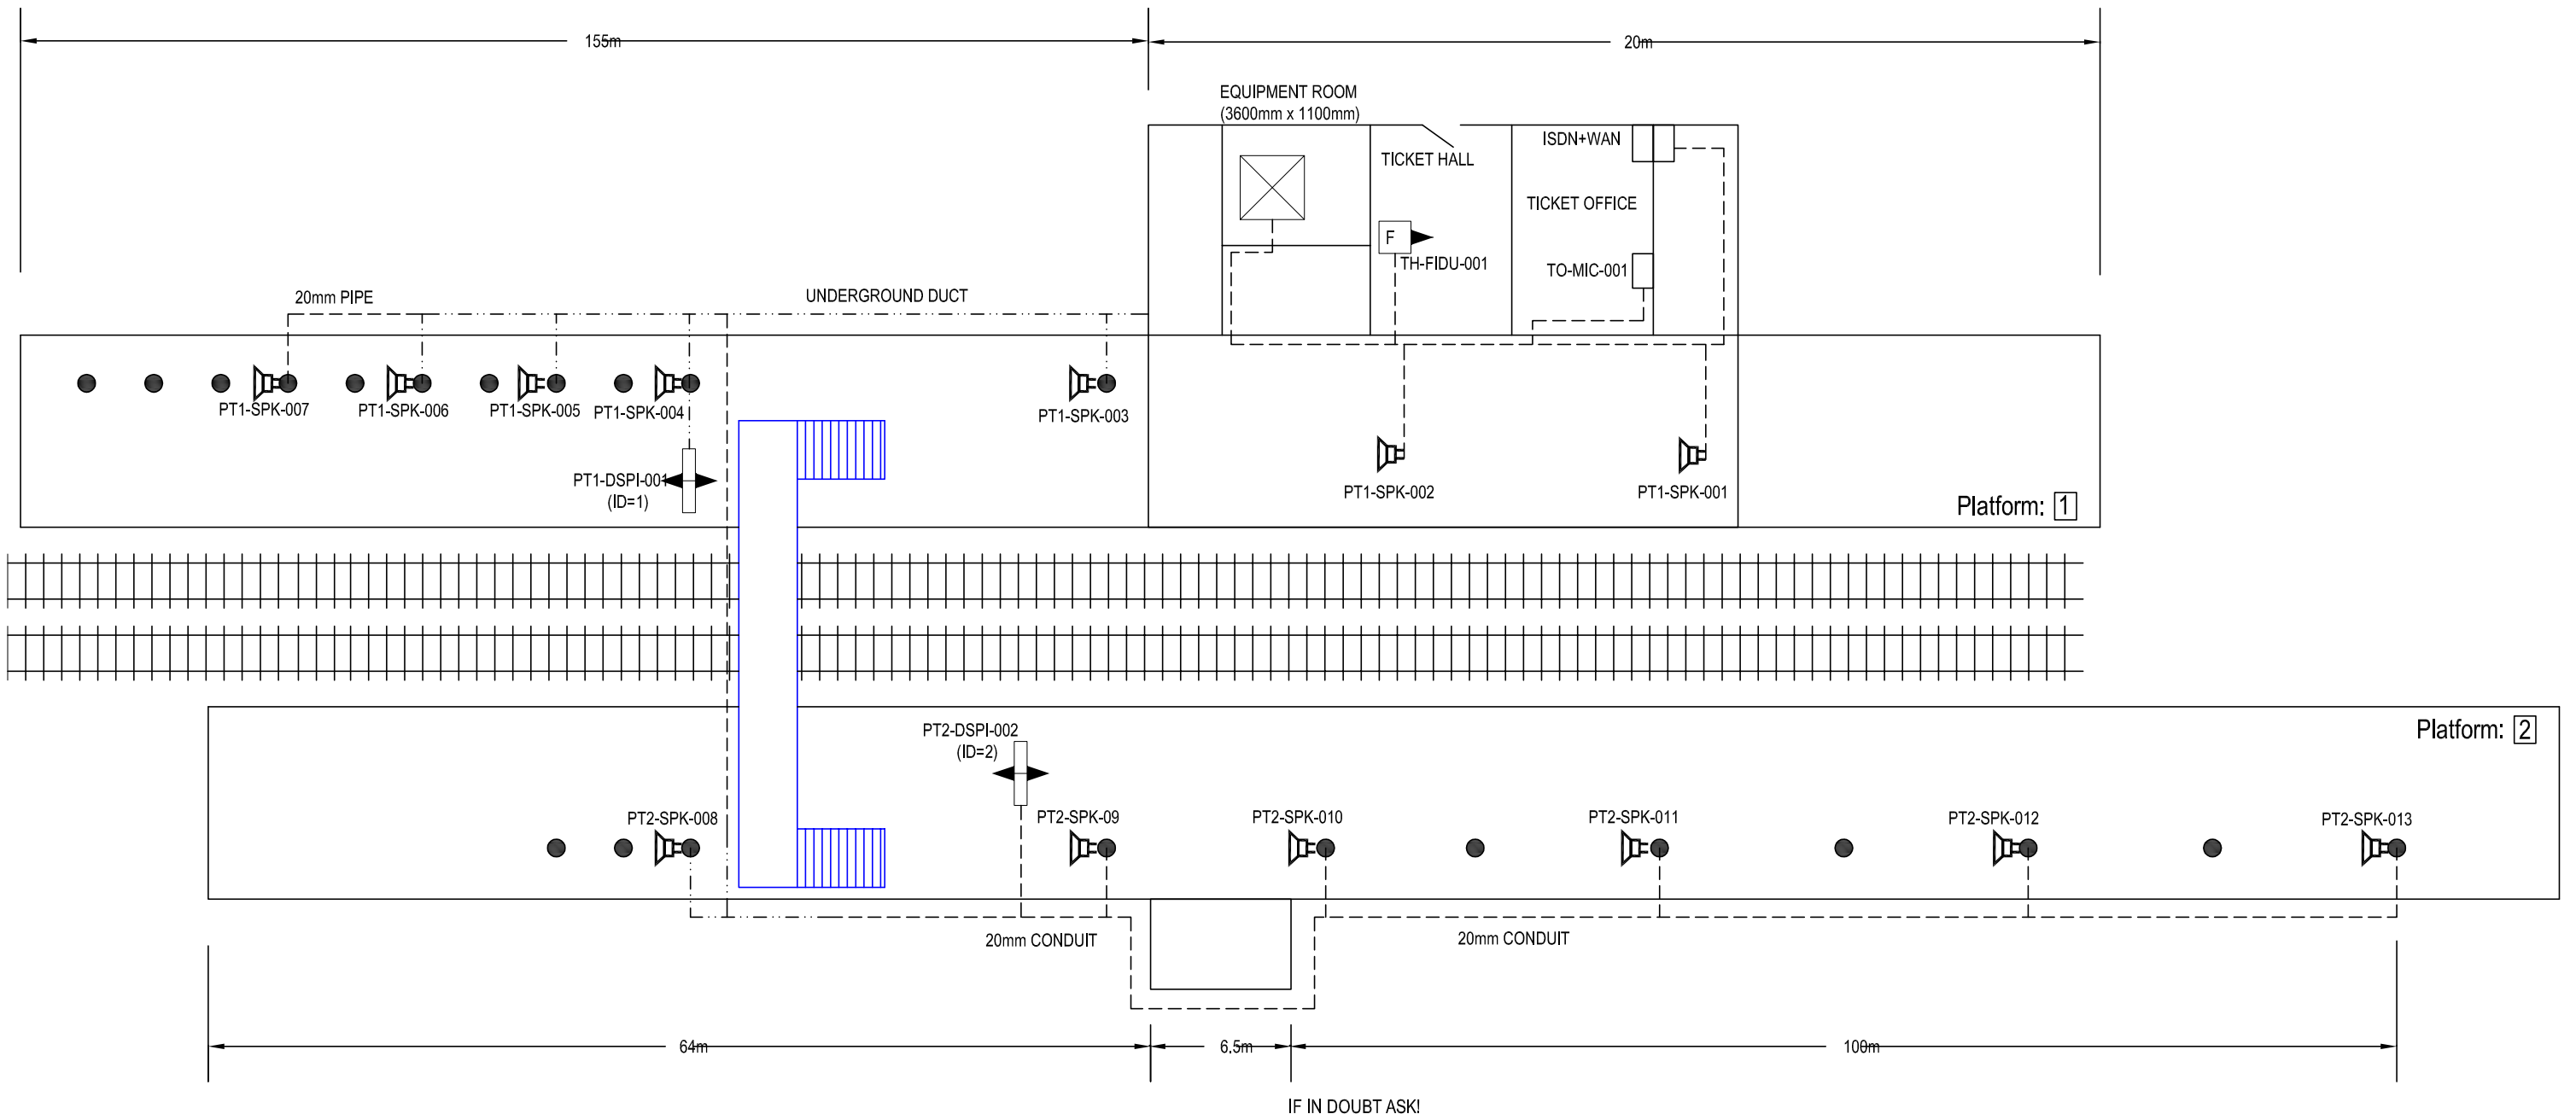

MATERIAL	CONSTRUCTION	NAME	SIGNATURE	DATE	AMEY DATEL Project Offices 1st Floor, Platform 2/3 Eastleigh Station Southampton Road Eastleigh Hants SO50 9FL	SITE/PROJECT
		A HATTON		03-07-2002		SOUTH WEST TRAINS CIS PROJECT
		T WONG				TITLE
		A SMITH				EARLEY AS BUILT
						SCALE
FINISH						DRG No. SM803-75694
						ISSUE B
						SHEET 1 of 1

COPYRIGHT © AMEY Rail
All rights reserved. Neither this drawing or any of the information it contains may be copied or communicated to third parties without the written permission of the copyright holder