



WAN	
CIRCUIT ID	KXIP 400450
IP ADDRESS	10.227.140.1

"PLATFORM 1 HP ISDN"
01-483-281027
"PLATFORM 2 HP ISDN"
01-483-281037

All Equipment tags to be prefixed with "EFF-"

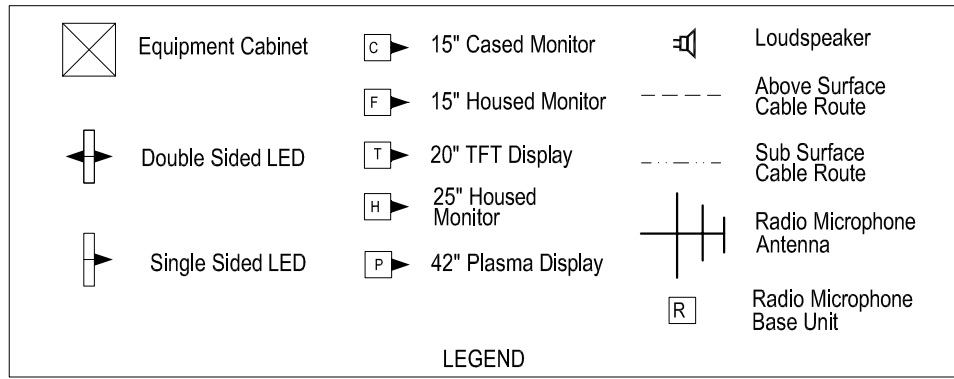

Equipment	Dist Board	MCB4
PT1-DSPI-001	D.B IN	
PT2-DSPI-002	WAITING RM	
TH-HIDU-001		
FBHIDU-002		
CHO-CIDU-001		

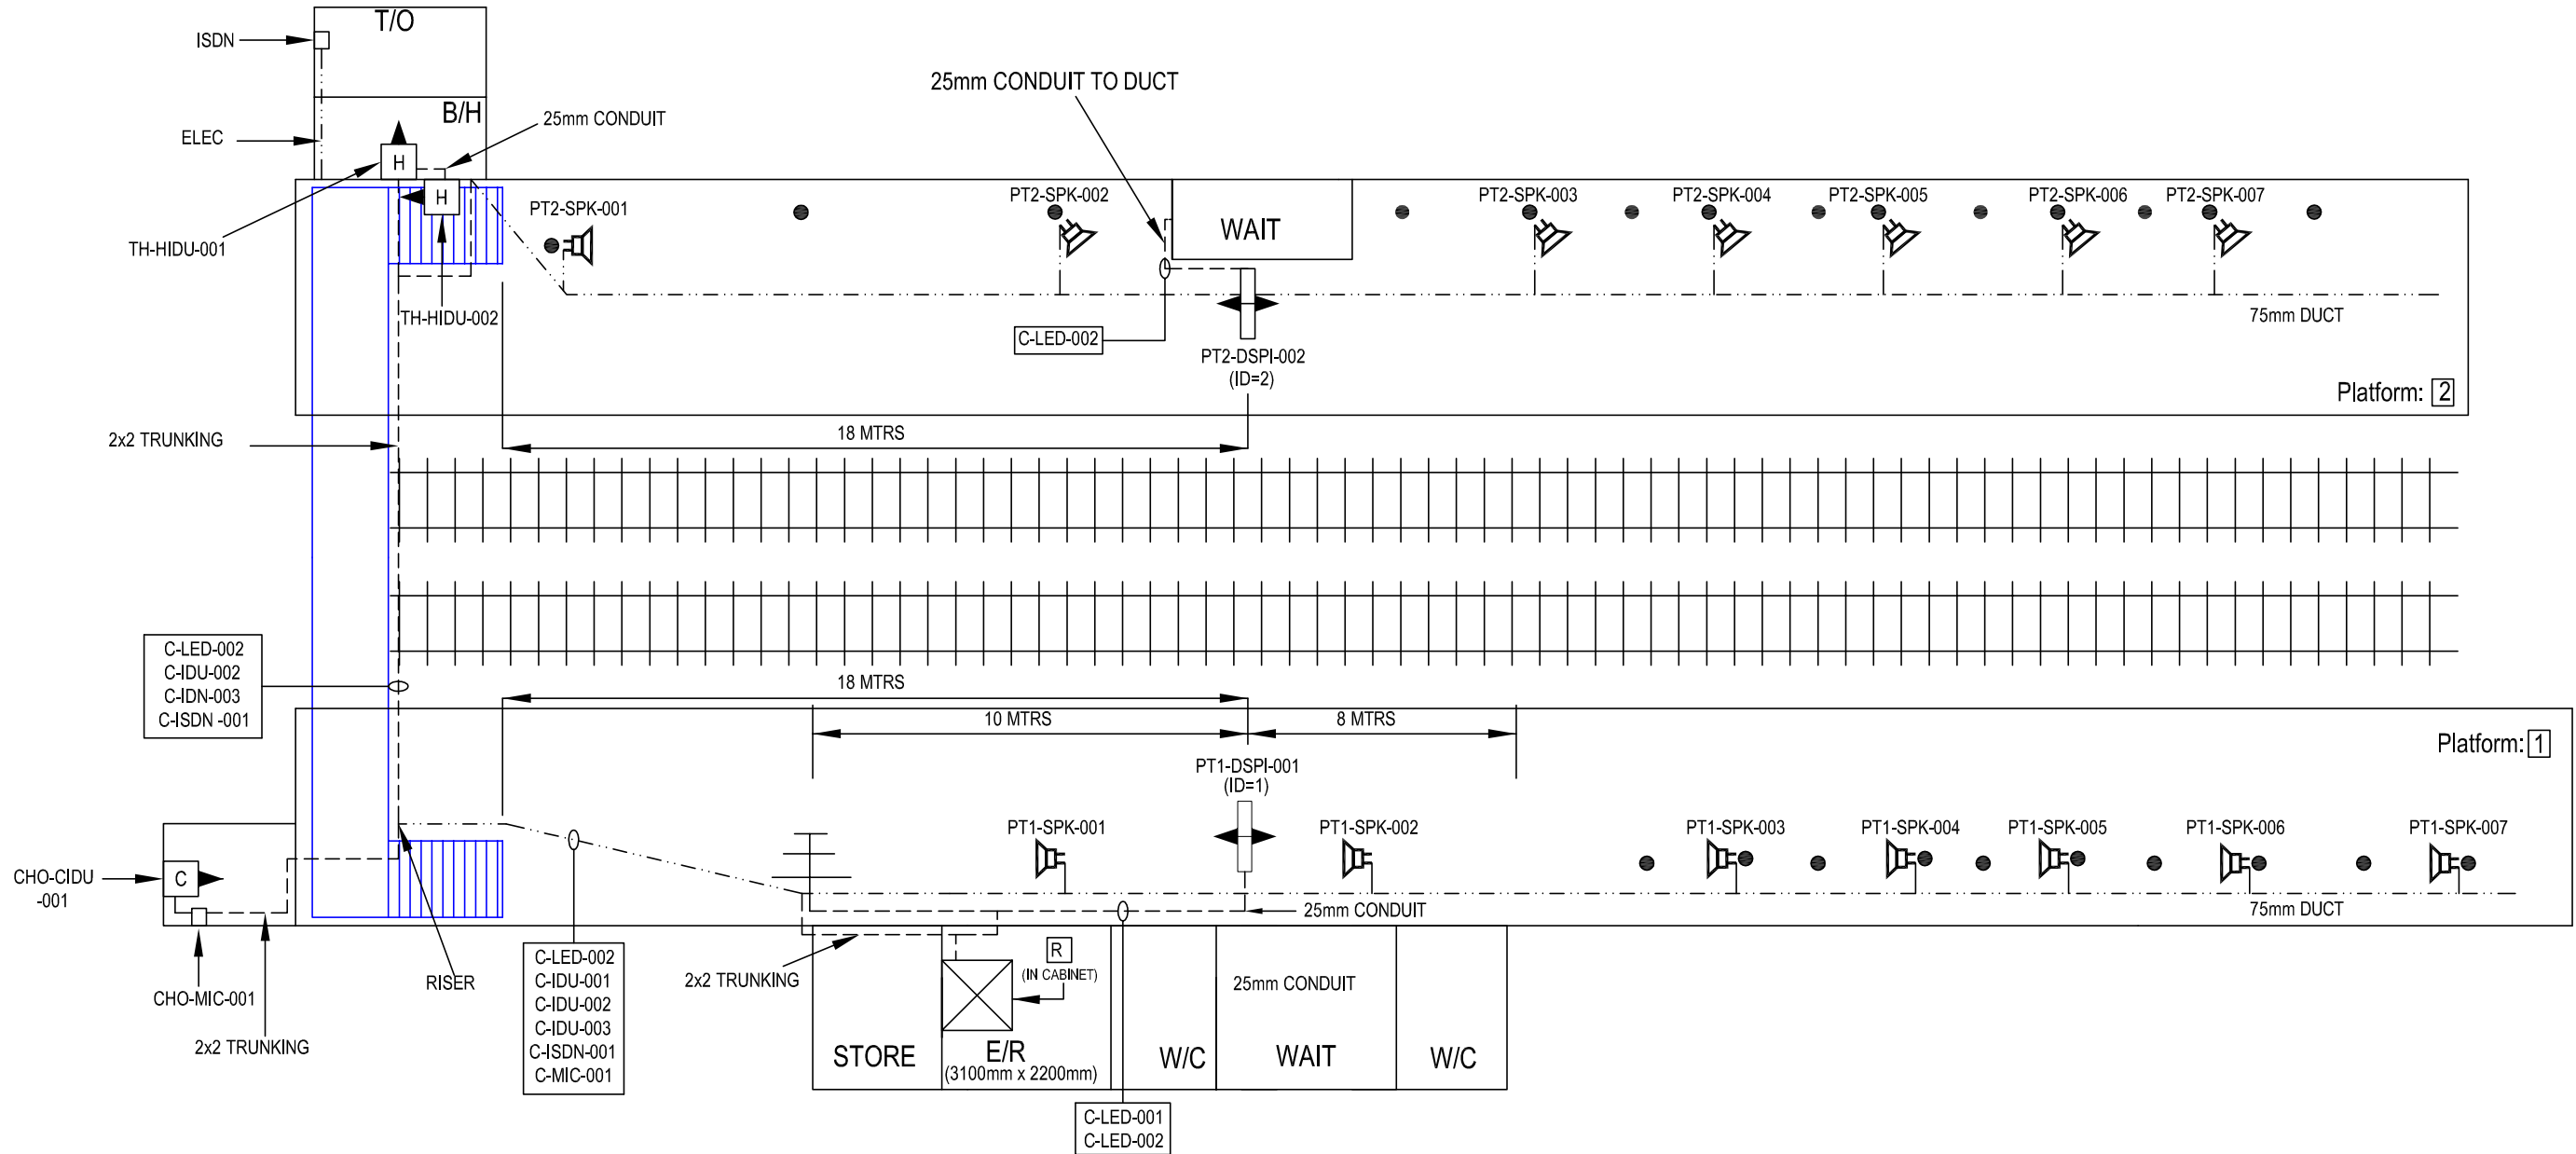

IF IN DOUBT ASK!

MATERIAL	CONSTRUCTION	DRAWN BY	D GADDU	SIGNATURE		AMEY DATEL Project Offices 1st Floor, Platform 2/3 Eastleigh Station Southampton Road Eastleigh Hants SO50 9FL	SITE/PROJECT		SOUTH WEST TRAINS CIS PROJECT	
		CHECKED BY	T WONG	DATE	22-02-2002		TITLE		EFFINGHAM JUNCTION AS BUILT	
FINISH		APPD BY	A SMITH				SCALE	DRG No.	ISSUE	SHEET
		CAD Ref:					NTS	SM803-75642	B	1 of 1
		CONTRACTOR'S Ref:				COPYRIGHT © AMEY Rail All rights reserved. Neither this drawing or any of the information it contains may be copied or communicated to third parties without the written permission of the copyright holder.				