



WAN	
CIRCUIT ID	KXIP 400451
IP ADDRESS	10.227.141.1

"PLATFORM 1 HP ISDN"
01-784-479844
"PLATFORM 2 HP ISDN"
01-784-479845

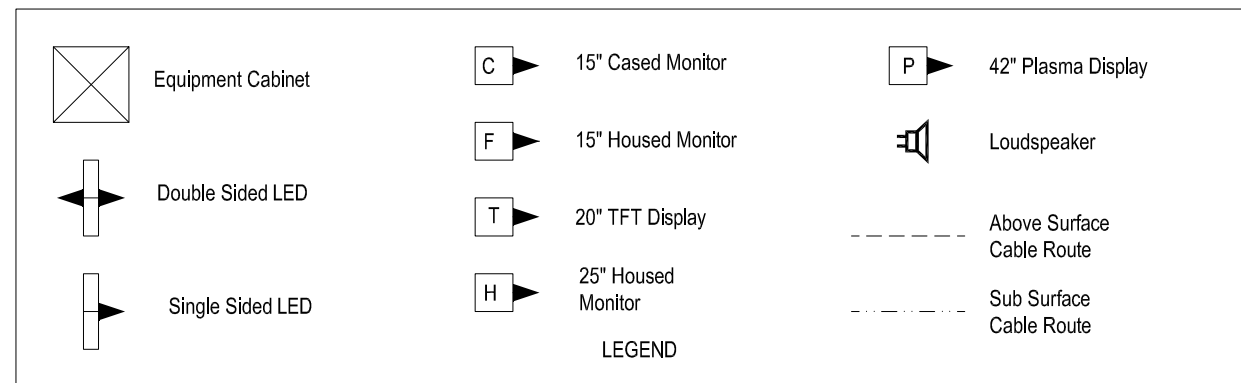

Equipment	Dist Board	
CIS RACK	IN EQUIP. ROOM	CCT 10
PT1-DSPI-001	GP 1	CCT 11
PT2-DSPI-002	GP 1	CCT 11
TH-FIDU-001	IN T.O.	CCT 1
PT1-FIDU-001	IN T.O.	CCT 1

All Equipment tags to be prefixed with "EGH-"

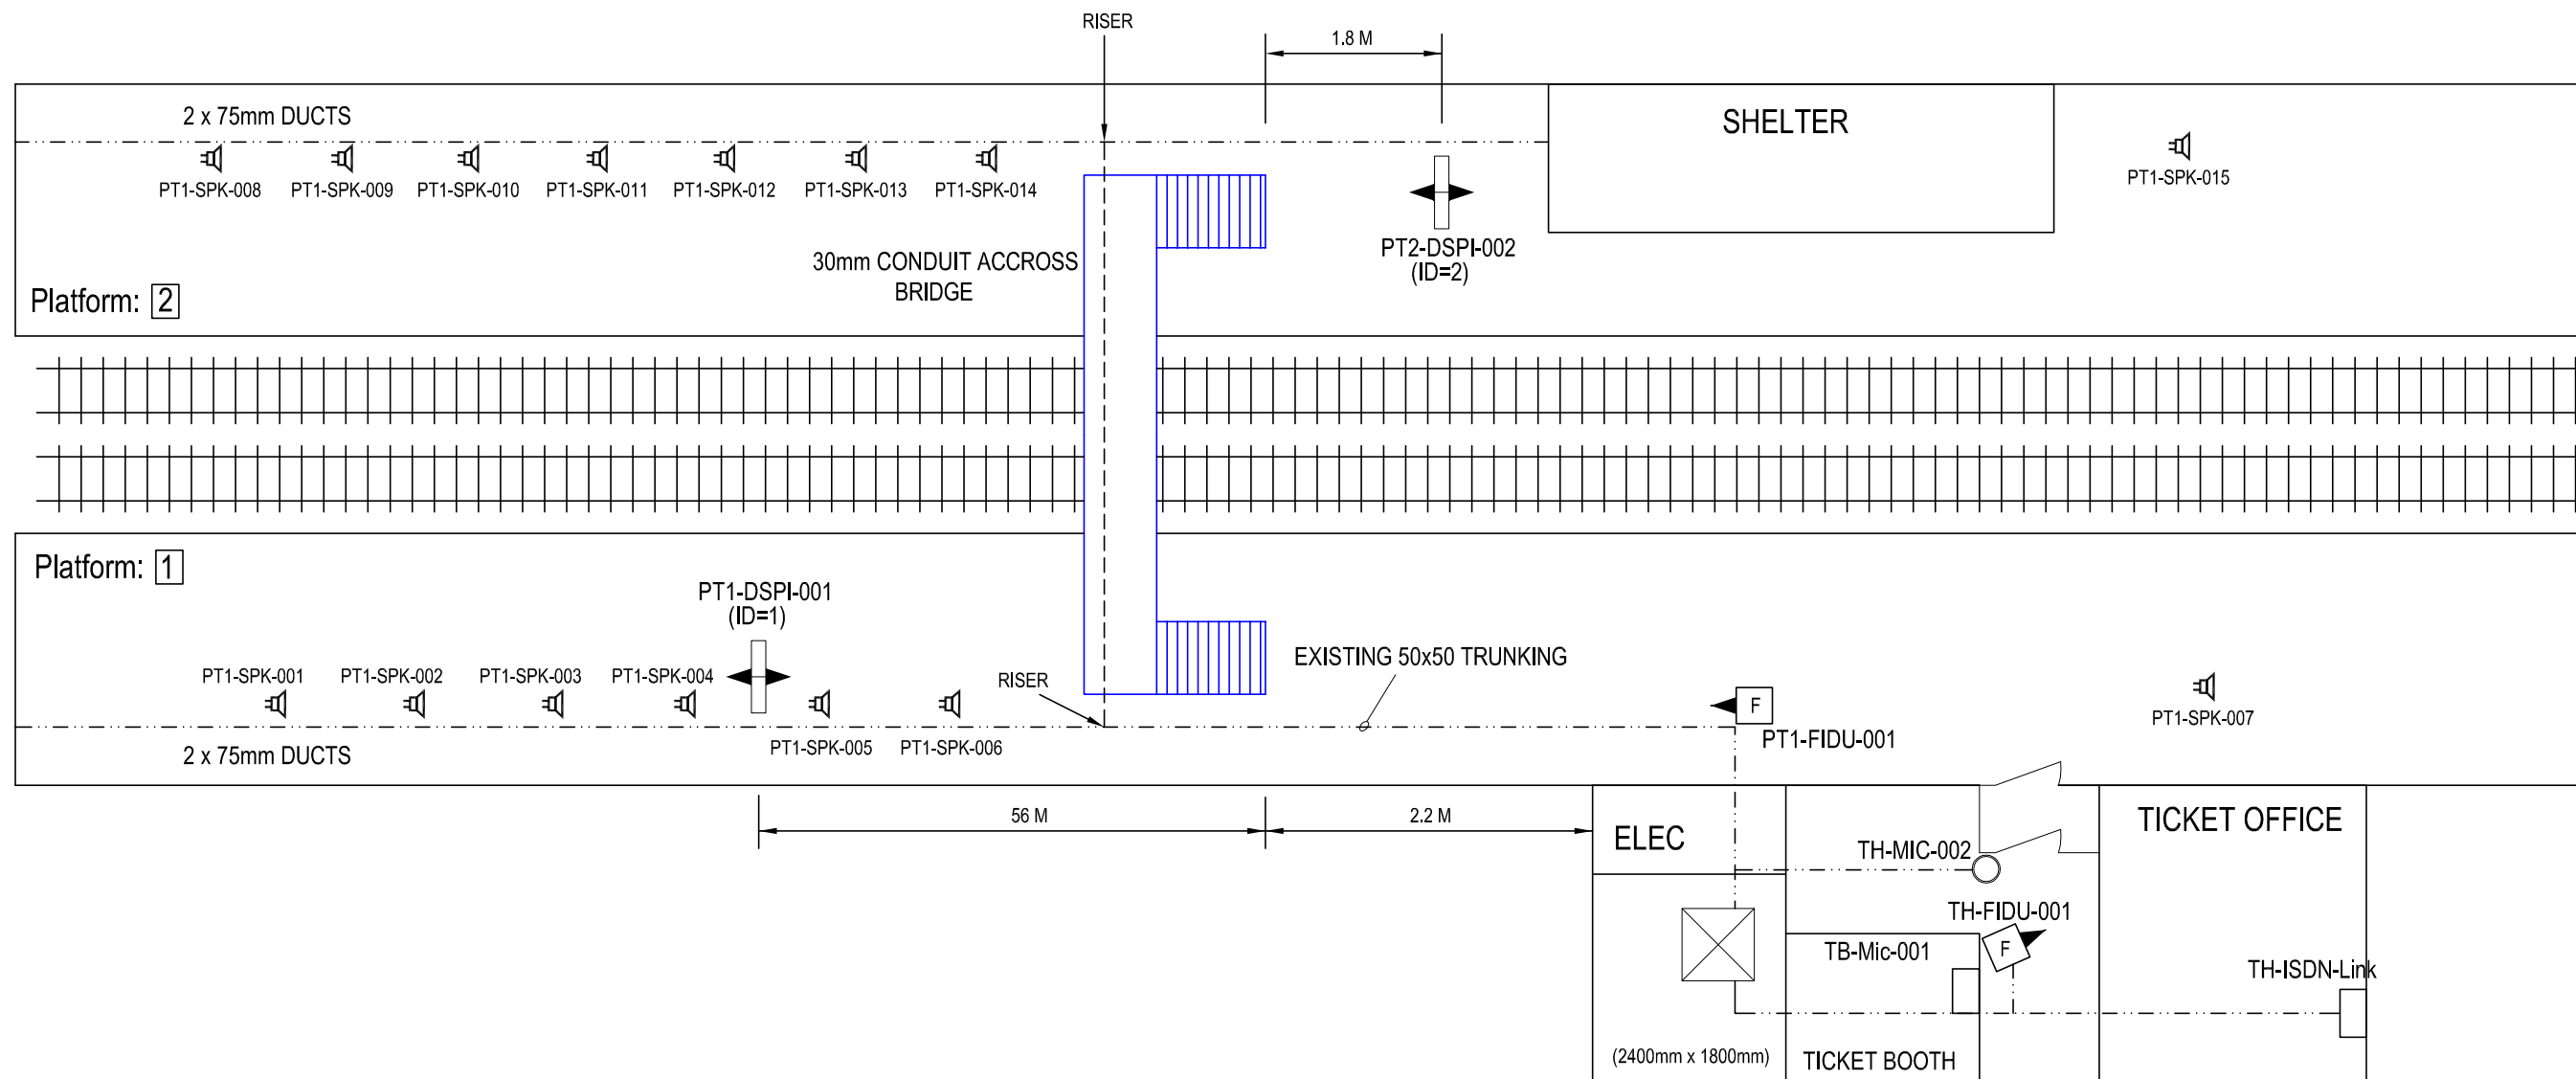

IF IN DOUBT ASK!

MATERIAL	CONSTRUCTION	<table border="1"> <thead> <tr> <th>NAME</th> <th>SIGNATURE</th> <th>DATE</th> </tr> </thead> <tbody> <tr> <td>D GADDU</td> <td></td> <td>30-03-2002</td> </tr> <tr> <td>T WONG</td> <td></td> <td></td> </tr> <tr> <td>A SMITH</td> <td></td> <td></td> </tr> </tbody> </table>	NAME	SIGNATURE	DATE	D GADDU		30-03-2002	T WONG			A SMITH			<p>AMEY DATEL Project Offices 1st Floor, Platform 2/3 Eastleigh Station Southampton Road Eastleigh Hants SO50 9FL</p>	SITE/PROJECT		SOUTH WEST TRAINS CIS PROJECT	
		NAME	SIGNATURE	DATE															
D GADDU		30-03-2002																	
T WONG																			
A SMITH																			
FINISH				TITLE		EGHAM AS BUILT													
		CAD Ref:	COPYRIGHT © AMEY Rail All rights reserved. Neither this drawing or any of the information it contains may be copied or communicated to third parties without the written permission of the copyright holder		SCALE	DRG No.	ISSUE	SHEET											
		CONTRACTOR'S Ref:			NTS	SM803-75669	C	1 of 1											