


SM803-75558


WAN	
CIRCUIT ID	02083-986761
IP ADDRESS	02083-986761

"PLATFORM 1 HP ISDN"
02083-986761
"PLATFORM 2 HP ISDN"
02083-986794

All Equipment tags to be prefixed with "ESH-"

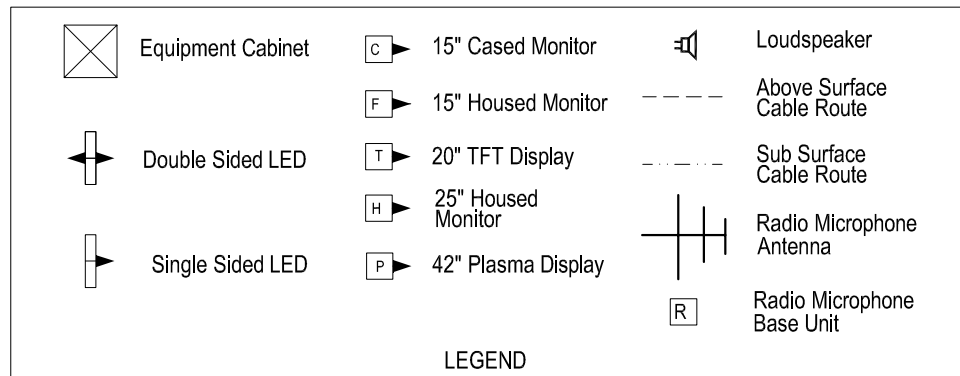

Equipment	Dist Board	
CIS RACK	BOARD IN ROOM	
PT1-DSPI-001	LP1	CCT 4
PT1-DSPI-002	LP1	CCT 3
PT4-DSPI-003	LP1	CCT 3
TOF-CIDU-001	LP2	
BH-CIDU-002	LP2	
BH-CIDU-003	LP2	

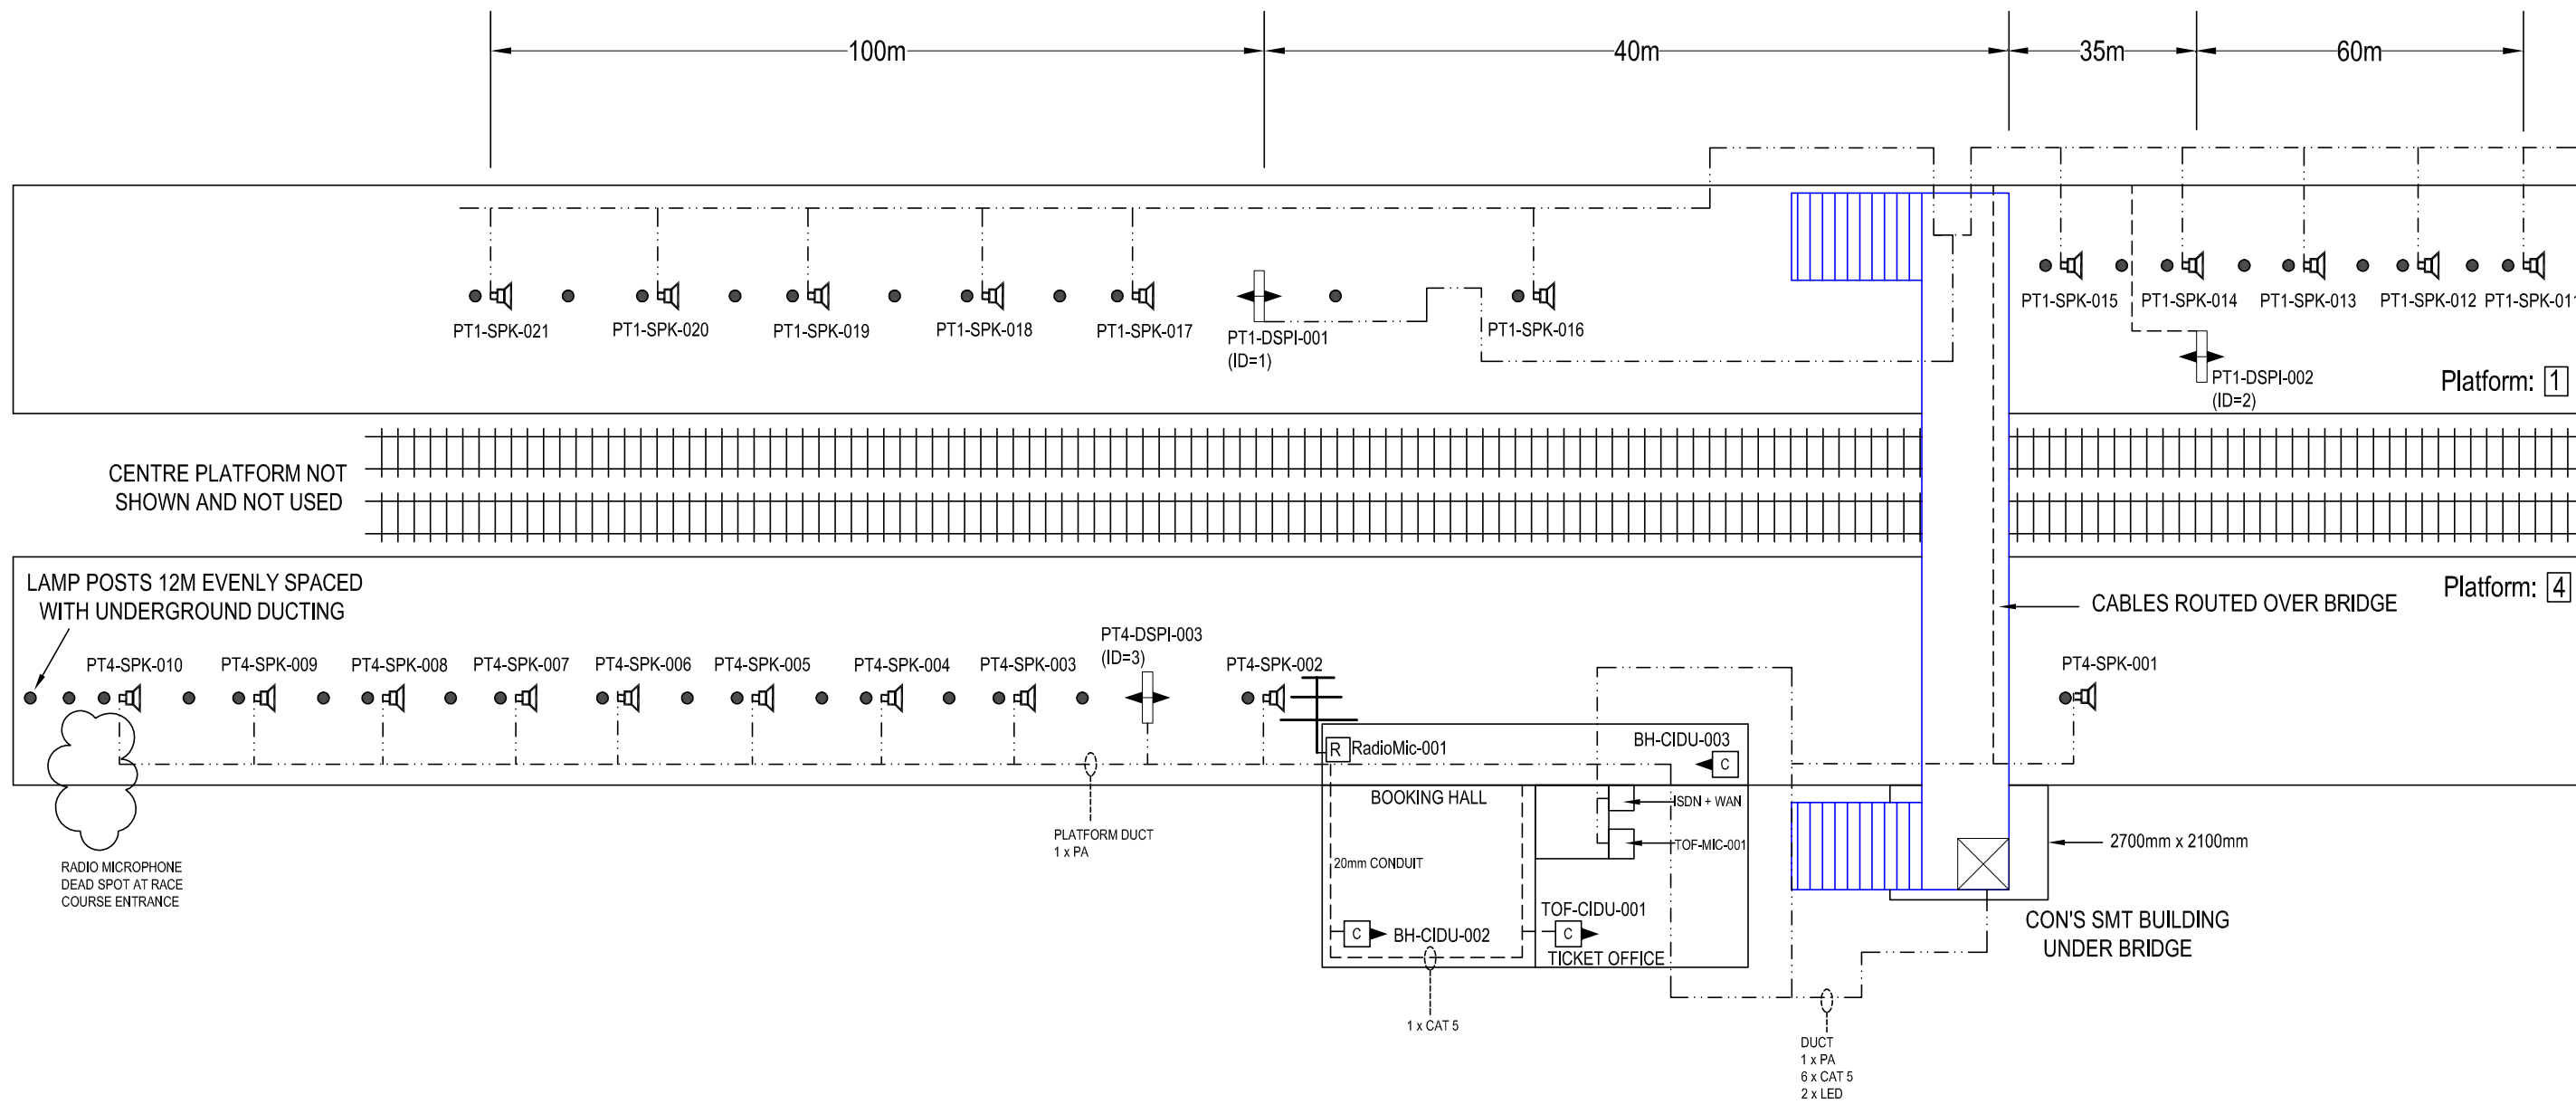

IF IN DOUBT ASK!

MATERIAL	CONSTRUCTION	<table border="1"> <thead> <tr> <th>NAME</th> <th>SIGNATURE</th> <th>DATE</th> </tr> </thead> <tbody> <tr> <td>D GADDU</td> <td></td> <td>30-03-2002</td> </tr> <tr> <td>T WONG</td> <td></td> <td></td> </tr> <tr> <td>A SMITH</td> <td></td> <td></td> </tr> </tbody> </table>	NAME	SIGNATURE	DATE	D GADDU		30-03-2002	T WONG			A SMITH			<p>AMEY DATEL Project Offices 1st Floor, Platform 2/3 Eastleigh Station Southampton Road Eastleigh Hants SO50 9FL</p>	SITE/PROJECT		SOUTH WEST TRAINS CIS PROJECT	
		NAME	SIGNATURE	DATE															
D GADDU		30-03-2002																	
T WONG																			
A SMITH																			
FINISH				TITLE		ESHER AS BUILT													
		CAD Ref:		SCALE		NTS	DRG No.	SM803-75558	ISSUE	B	SHEET	1 of 1							
		CONTRACTOR'S Ref:																	

COPYRIGHT © AMEY Rail
All rights reserved. Neither this drawing or any of the information it contains may be copied or communicated to third parties without the written permission of the copyright holder