





WAN	
CIRCUIT ID	KXIP300417
IP ADDRESS	10.227.100.1

"PLATFORM 1 HP ISDN"
02380-611492
"PLATFORM 2 HP ISDN"
02380-611493

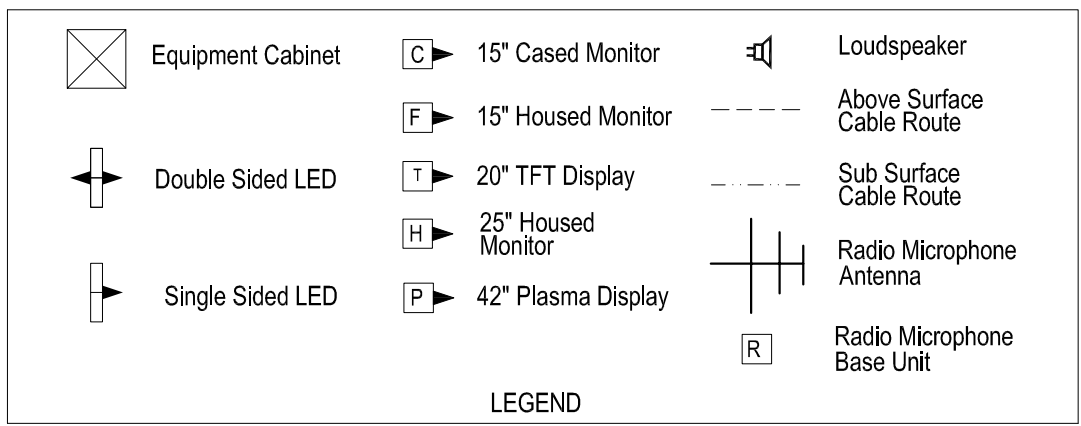

Equipment	Dist Board
CIS RACK	CCT 2
PT2-FIDU-001	CCT 3
ALL OTHERS USE EXISTING SPURS	

All Equipment Tags to be prefixed "ESL-"

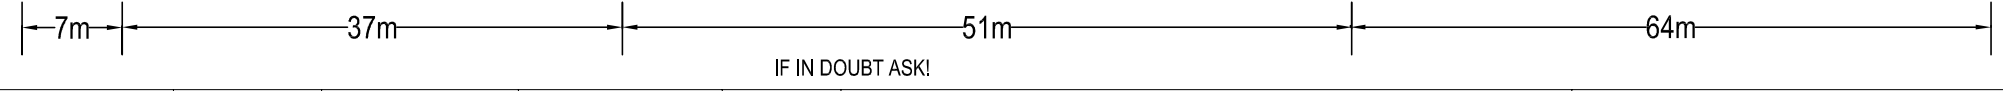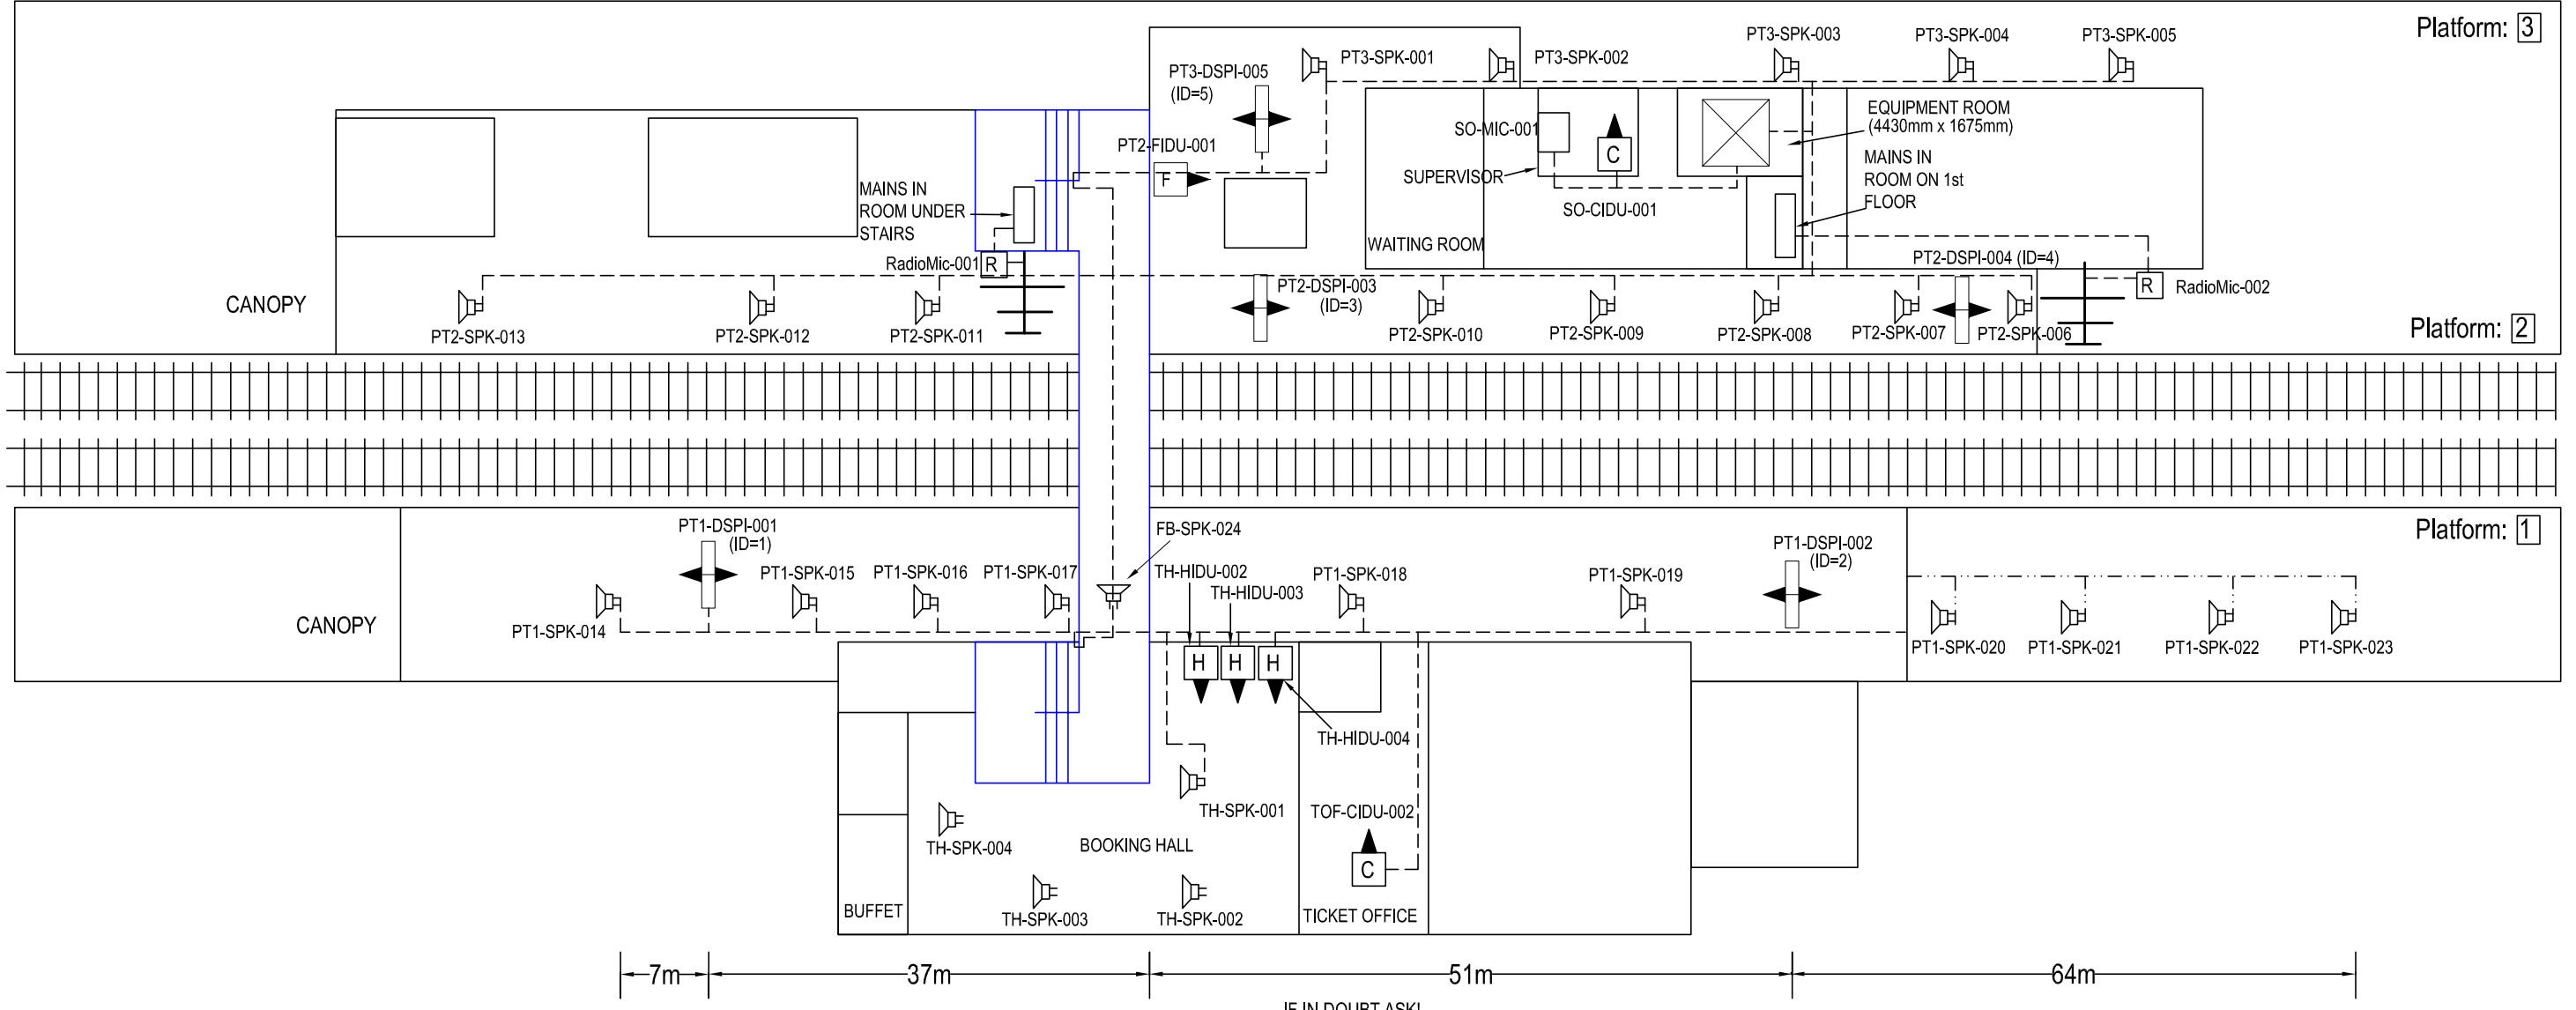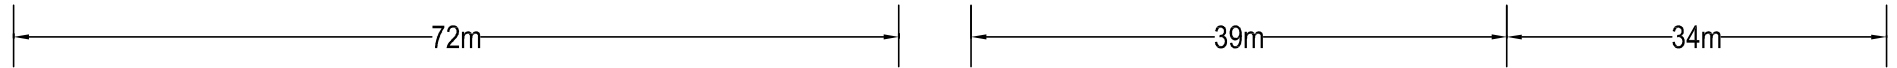

IF IN DOUBT ASK!

MATERIAL	CONSTRUCTION	NAME	SIGNATURE	DATE	AMEY DATEL Project Offices 1st Floor, Platform 2/3 Eastleigh Station Southampton Road Eastleigh Hants SO50 9FL	SITE/PROJECT			
		DRAWN BY	A HATTON	09-05-2002		SOUTH WEST TRAINS CIS PROJECT			
FINISH	CONSTRUCTION	CHECKED BY	T WONG		amey	TITLE			
		APPD BY	A SMITH			EASTLEIGH AS BUILT			
		CAD Ref:			COPYRIGHT © AMEY Rail All rights reserved. Neither this drawing or any of the information it contains may be copied or communicated to third parties without the written permission of the copyright holder	SCALE	DRG No.	ISSUE	SHEET
		CONTRACTOR'S Ref:				NTS	SM803-75899	B	1 of 1