


SM803-75586


WAN	
CIRCUIT ID	KXIP400453
IP ADDRESS	10.227.143.1

"PLATFORM 1 HP ISDN"
020-8786-7885
"PLATFORM 2 HP ISDN"
020-8786-7974

All Equipment tags to be prefixed with "EWW-"

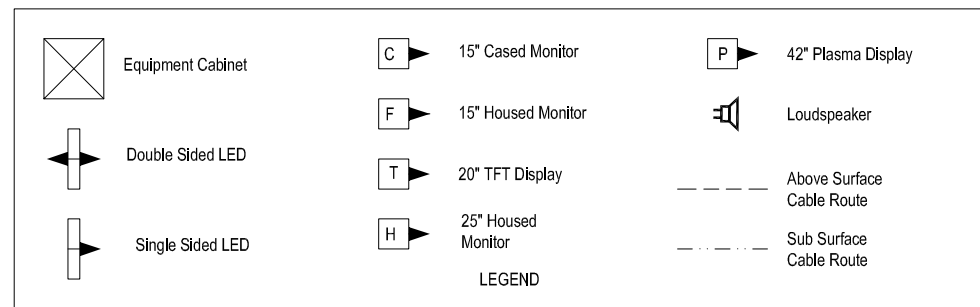

Equipment	Dist Board	
EXISTING		
SPURS USED		

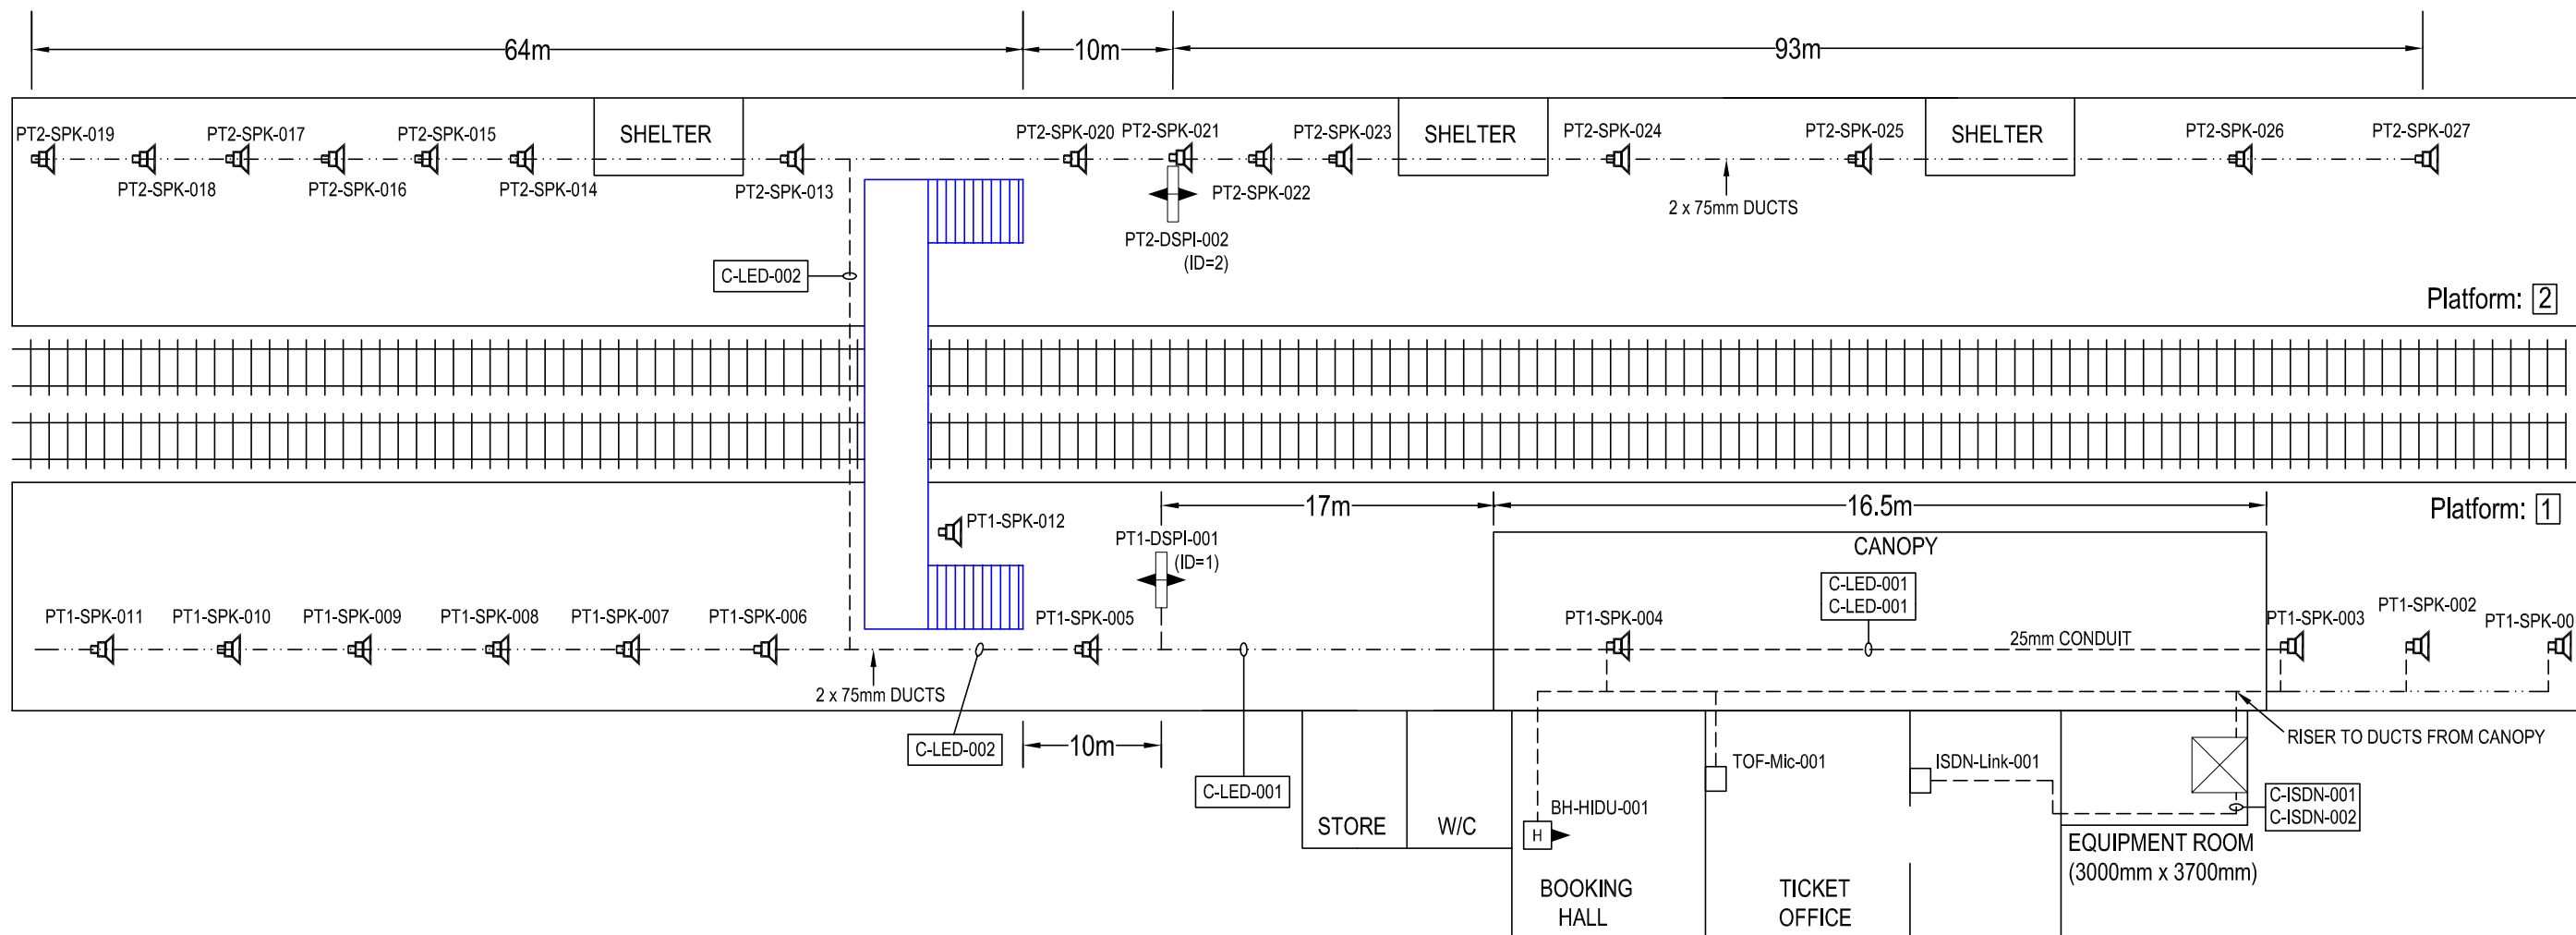

IF IN DOUBT ASK!

MATERIAL	CONSTRUCTION	<table border="1"> <tr> <th>NAME</th> <th>SIGNATURE</th> <th>DATE</th> </tr> <tr> <td>D GADDU</td> <td>D GADDU</td> <td>27-03-2002</td> </tr> <tr> <td>T WONG</td> <td>T WONG</td> <td>15-05-2002</td> </tr> <tr> <td>A SMITH</td> <td></td> <td></td> </tr> </table>	NAME	SIGNATURE	DATE	D GADDU	D GADDU	27-03-2002	T WONG	T WONG	15-05-2002	A SMITH			<p>AMEY DATEL Project Offices 1st Floor, Platform 2/3 Eastleigh Station Southampton Road Eastleigh Hants SO50 9FL</p>	SITE/PROJECT		SOUTH WEST TRAINS CIS PROJECT	
		NAME	SIGNATURE	DATE															
D GADDU	D GADDU	27-03-2002																	
T WONG	T WONG	15-05-2002																	
A SMITH																			
FINISH				TITLE		EWELL WEST AS BUILT													
		CAD Ref:		<p>COPYRIGHT © AMEY Rail All rights reserved. Neither this drawing or any of the information it contains may be copied or communicated to third parties without the written permission of the copyright holder</p>	SCALE	DRG No.	ISSUE	SHEET											
		CONTRACTOR'S Ref:			NTS	SM803-75884	C	1 of 1											