



WAN	
CIRCUIT ID	KXIP700560
IP ADDRESS	10.227.5.1

"PLATFORM 1 HP ISDN"
020-8587-0430
"PLATFORM 2 HP ISDN"
020-8587-0531

All Equipment tags to be prefixed with "FEL-"

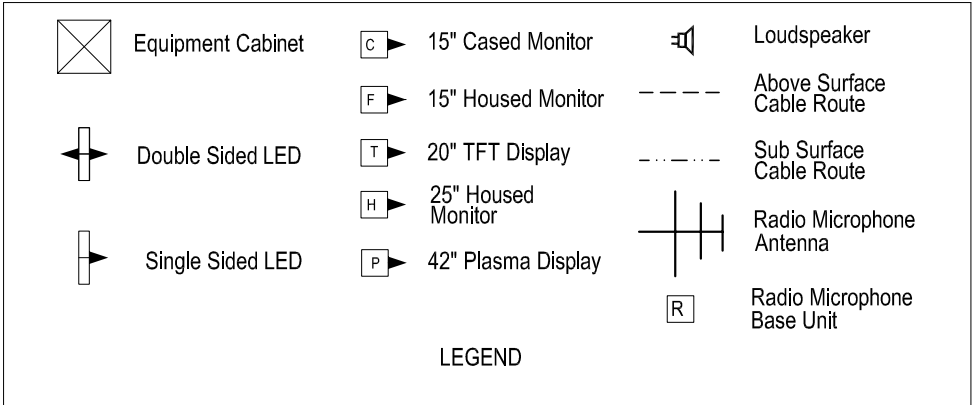

Equipment	Dist Board
CIS RACK	NEW BOARD
ALL OTHERS EXISTING SPURS USED	

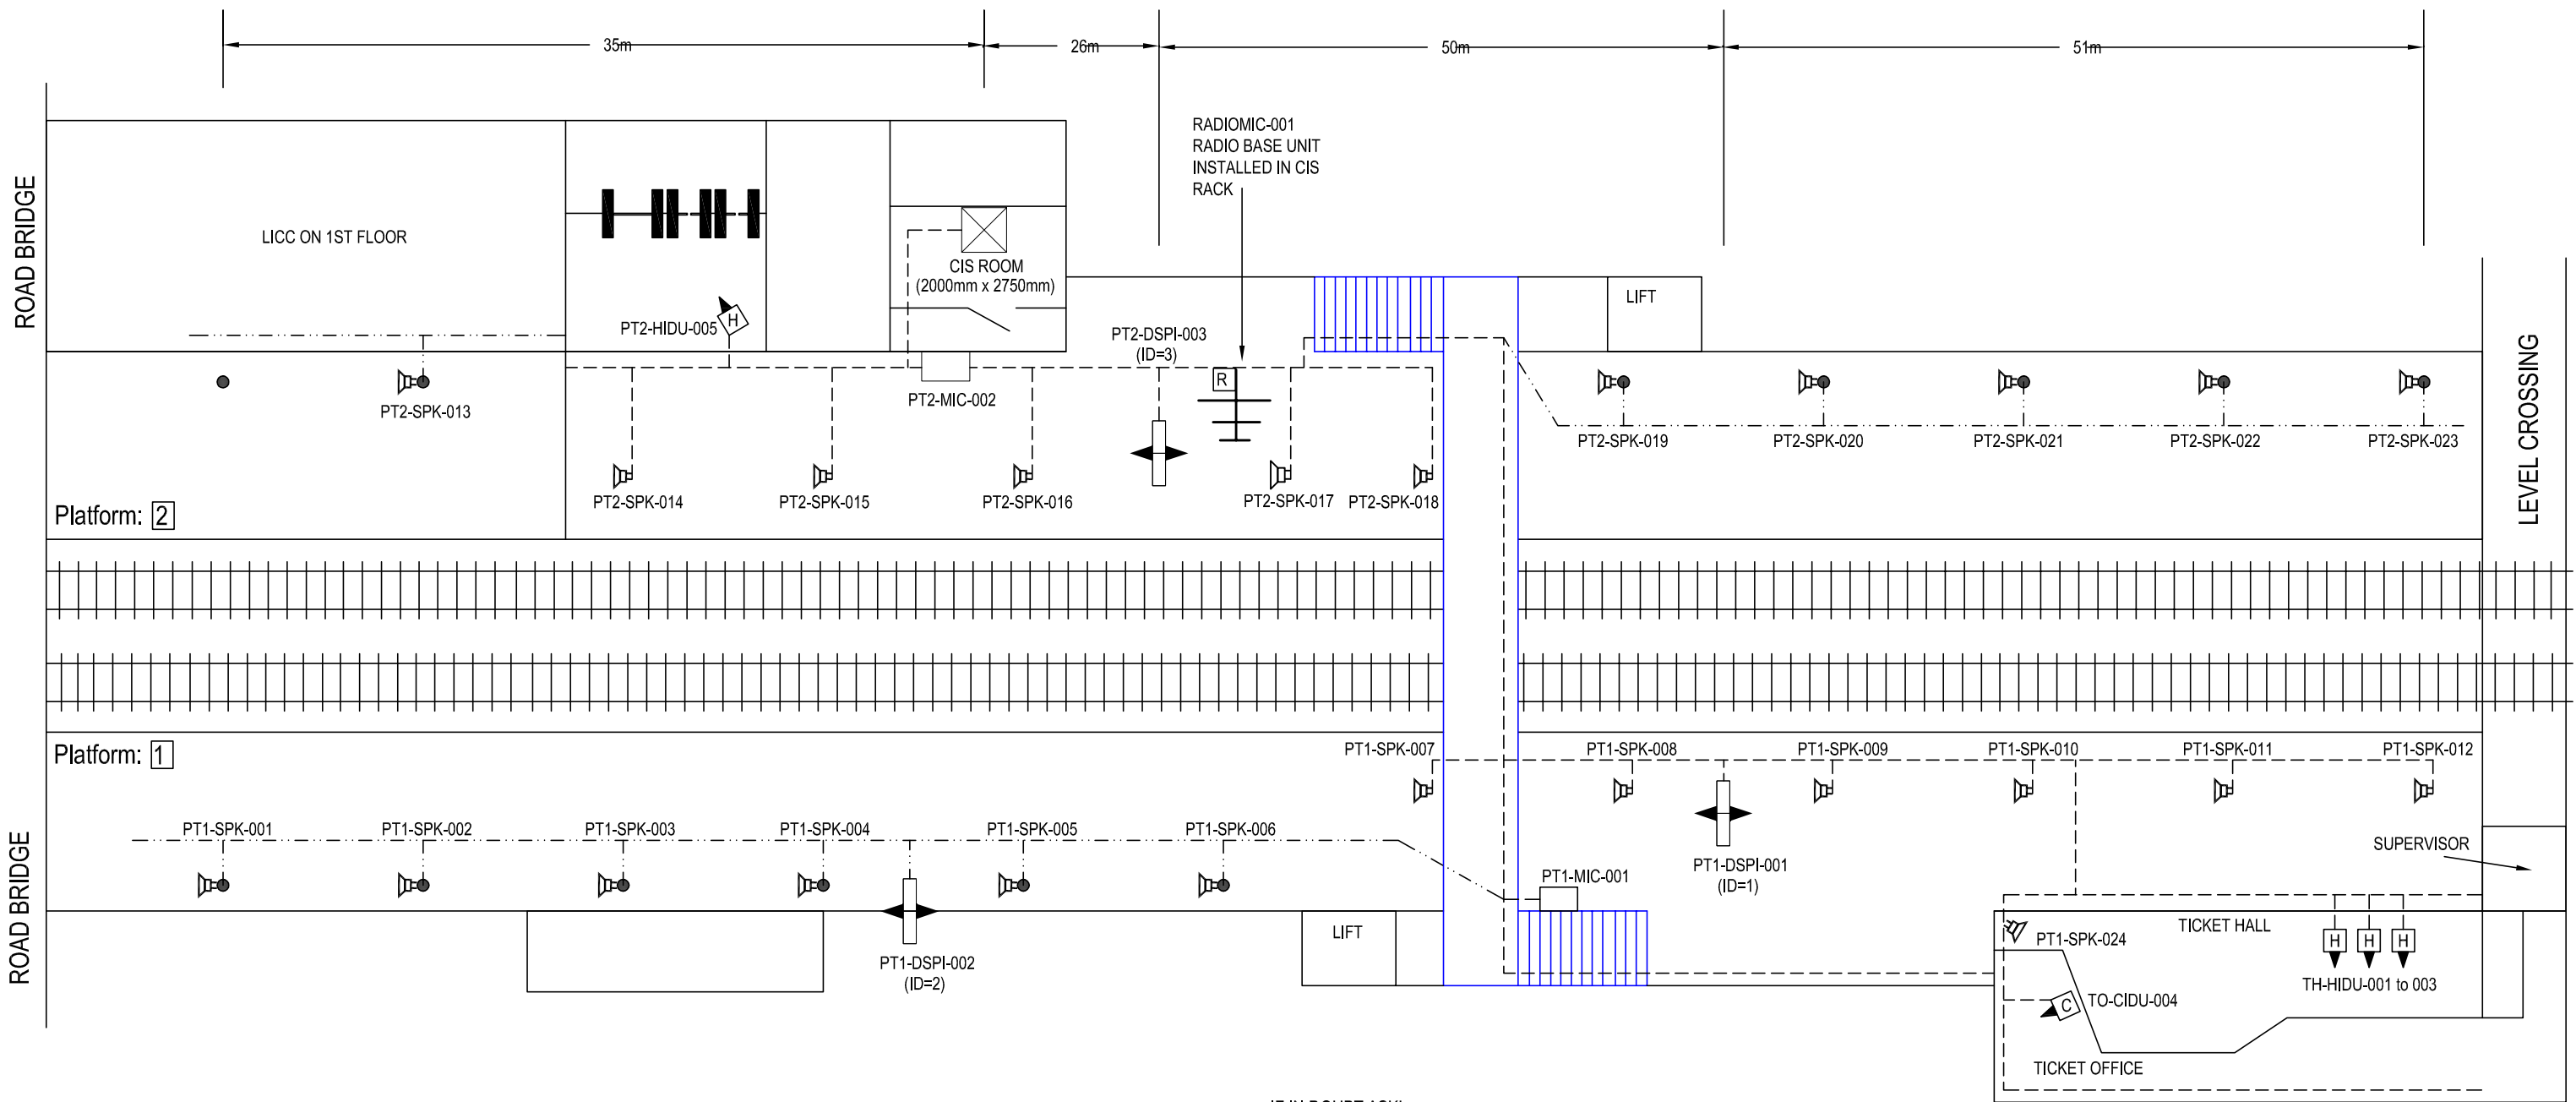

IF IN DOUBT ASK!

Date of Last Modification: 25 April 2003

This Drawing Supersedes Any Previous Drawings

CONSTRUCTION	NAME	SIGNATURE	DATE
DRAWN BY	J STEVENS		25-04-2003
CHECKED BY	T WONG		
APPD BY	A SMITH		
APPD BY			
CAD Ref:			
CONTRACTOR'S Ref:			

AMEY DATEL Project Offices
1st Floor, Platform 2/3
Eastleigh Station
Southampton Road
Eastleigh
Hants
SO50 9FL

COPYRIGHT © AMEY Rail
All rights reserved. Neither this drawing or any of the information it contains may be copied or communicated to third parties without the written permission of the copyright holder

SITE/PROJECT		SOUTH WEST TRAINS CIS PROJECT	
TITLE		FELTHAM AS BUILT	
SCALE	DRG No.	ISSUE	SHEET
NTS	SM803-75559	C	1 of 1