



WAN	
CIRCUIT ID	KXIP 400461
IP ADDRESS	10.227.146.1

"PLATFORM 1 HP ISDN"
0208 9435373
"PLATFORM 2 HP ISDN"
0280 9435271


All Equipment tags to be prefixed with "FWL-"

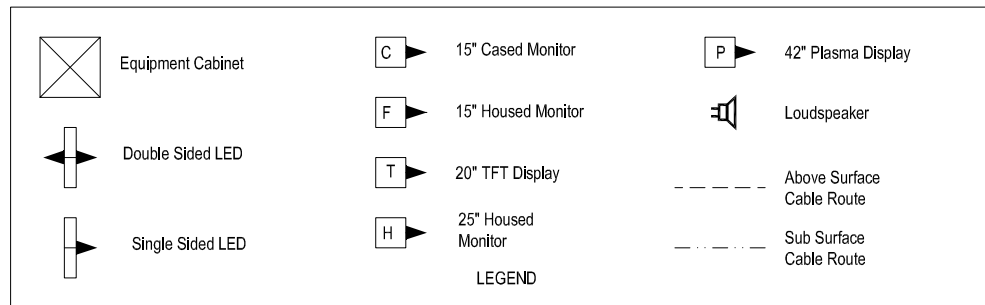

Equipment	Dist Board	
CABINET	CIS	WAY NO. 1
CPD 001 & 002	20 A MICS 6 A MICS	WAY NO. 3

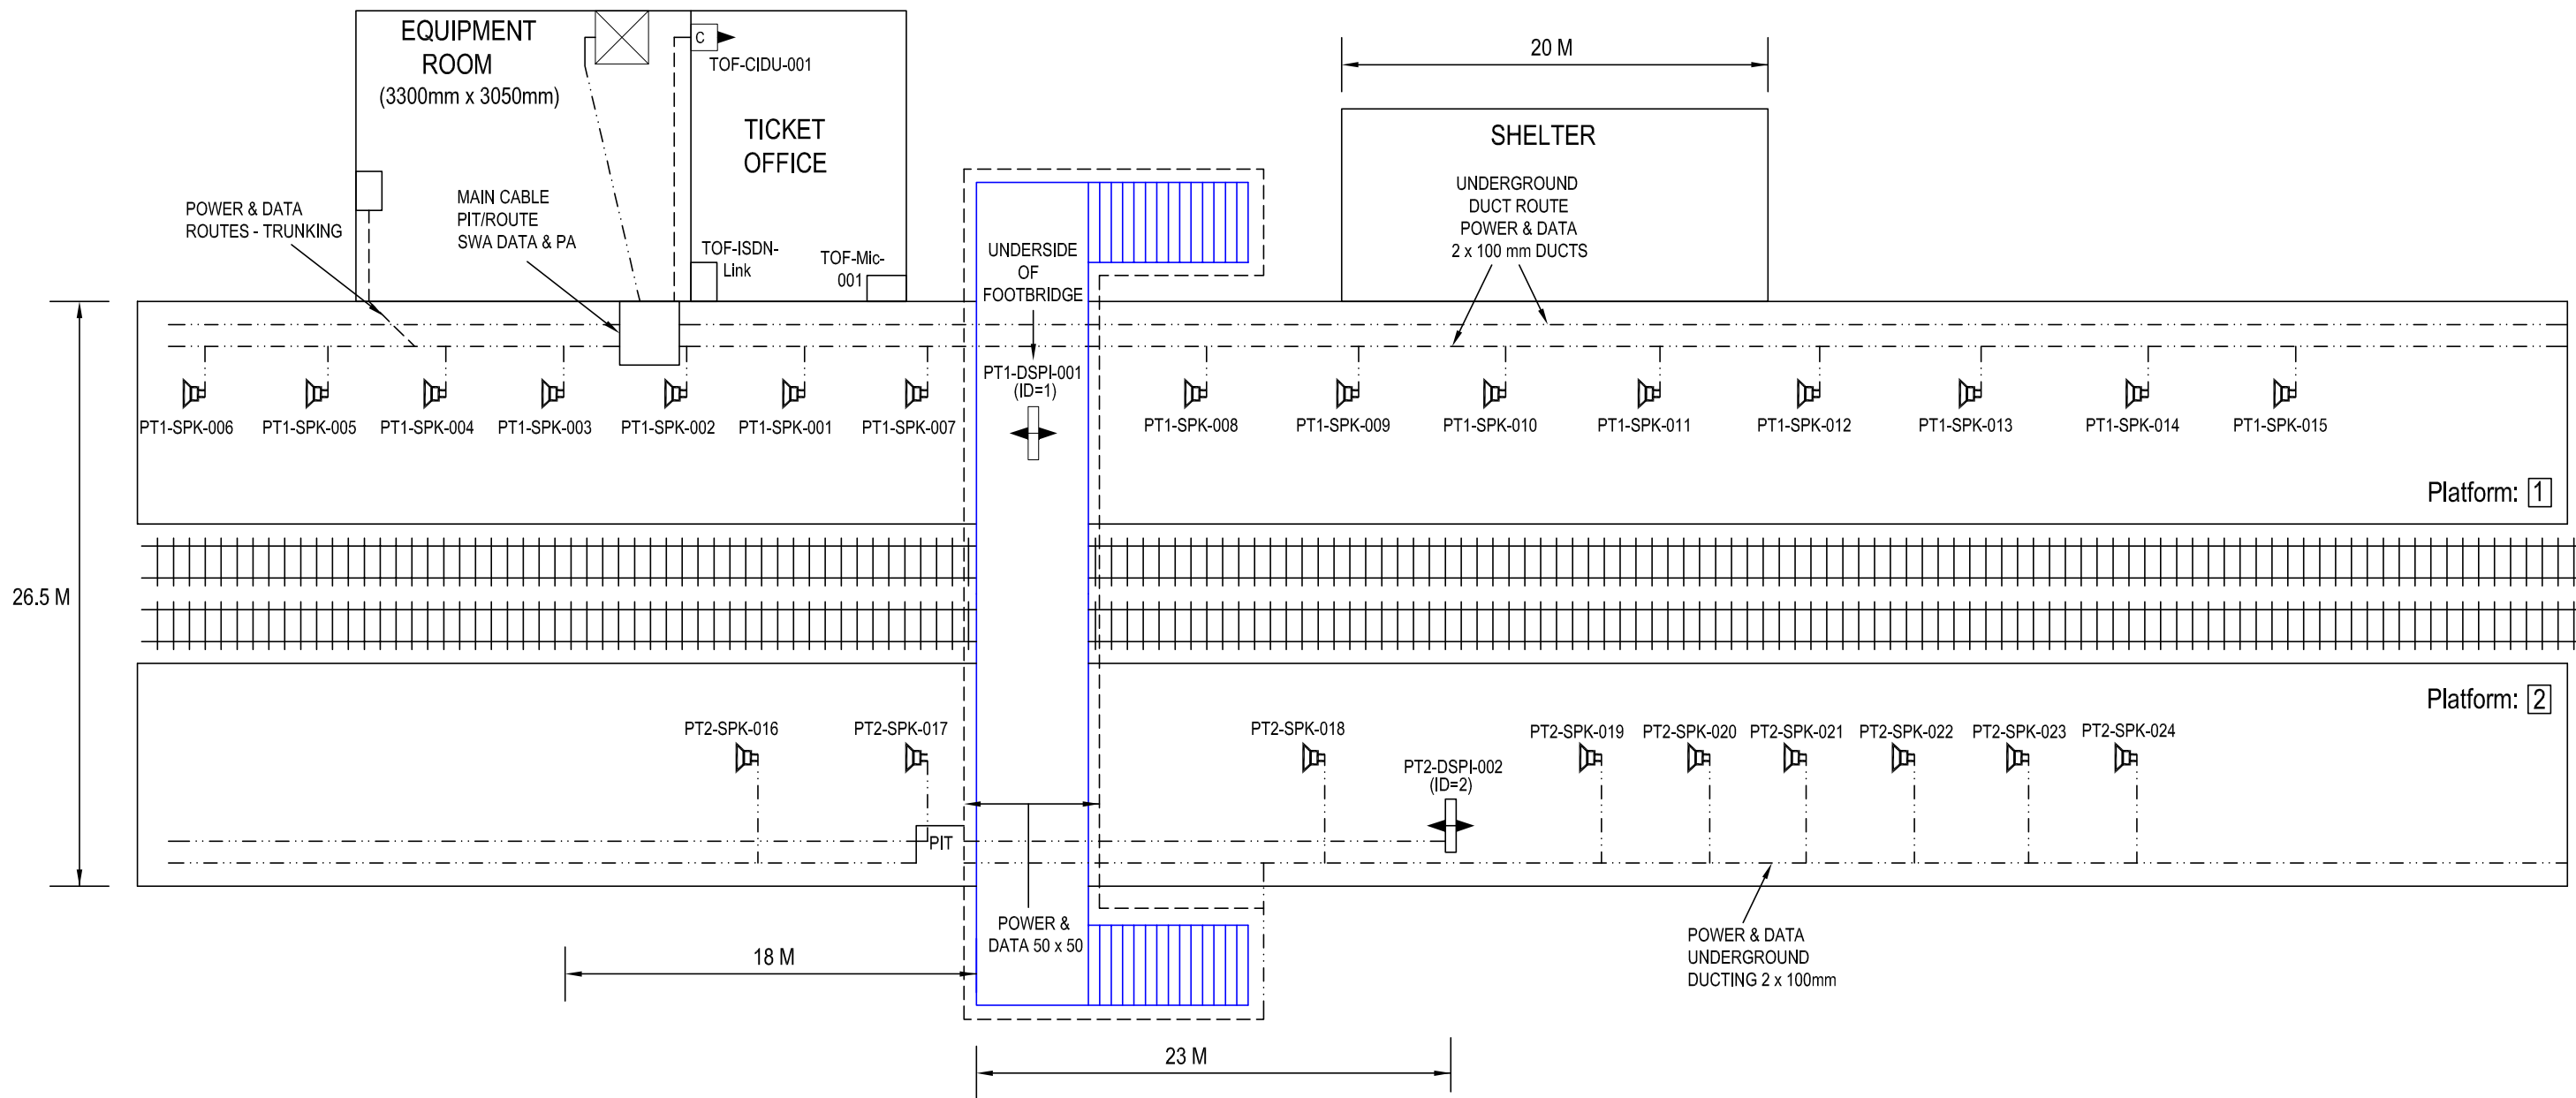

IF IN DOUBT ASK!

MATERIAL	CONSTRUCTION	NAME	SIGNATURE	DATE	 AMEY DATEL Project Offices 1st Floor, Platform 2/3 Eastleigh Station Southampton Road Eastleigh Hants SO50 9FL	SITE/PROJECT			
		DRAWN BY	D GADDU	D GADDU		25-03-2002	SOUTH WEST TRAINS CIS PROJECT		
		CHECKED BY	T WONG	T WONG		18-04-2002	TITLE		
		APPD BY	A SMITH				FULWELL AS BUILT		
FINISH	CONSTRUCTION	CAD Ref:			COPYRIGHT © AMEY Rail All rights reserved. Neither this drawing or any of the information it contains may be copied or communicated to third parties without the written permission of the copyright holder	SCALE	DRG No.	ISSUE	SHEET
		CONTRACTOR'S Ref:				NTS	SM803-75587	C	1 of 1