



WAN	
CIRCUIT ID	KXIP300419
IP ADDRESS	10.227.123.1

"PLATFORM 1 HP ISDN"	01-276-685044
"PLATFORM 2 HP ISDN"	01-276-685045

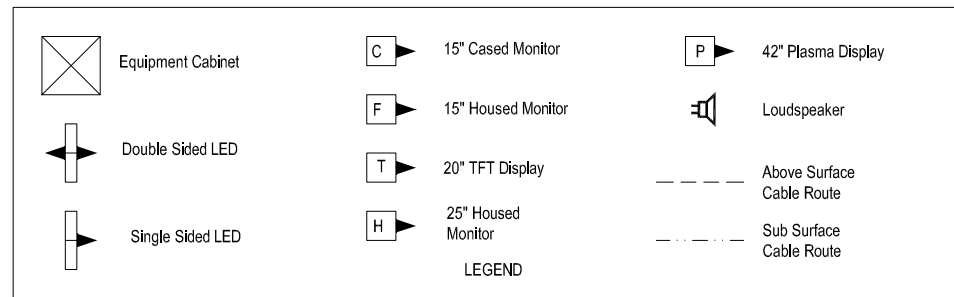


Equipment	Dist Board
RACK	DB1 CCT 11
IDU 001	DB1 CCT 1
LED 001	DB1 CCT 7
LED 002	EXISTING SPUR

All Equipment tags to be prefixed with "FML-"

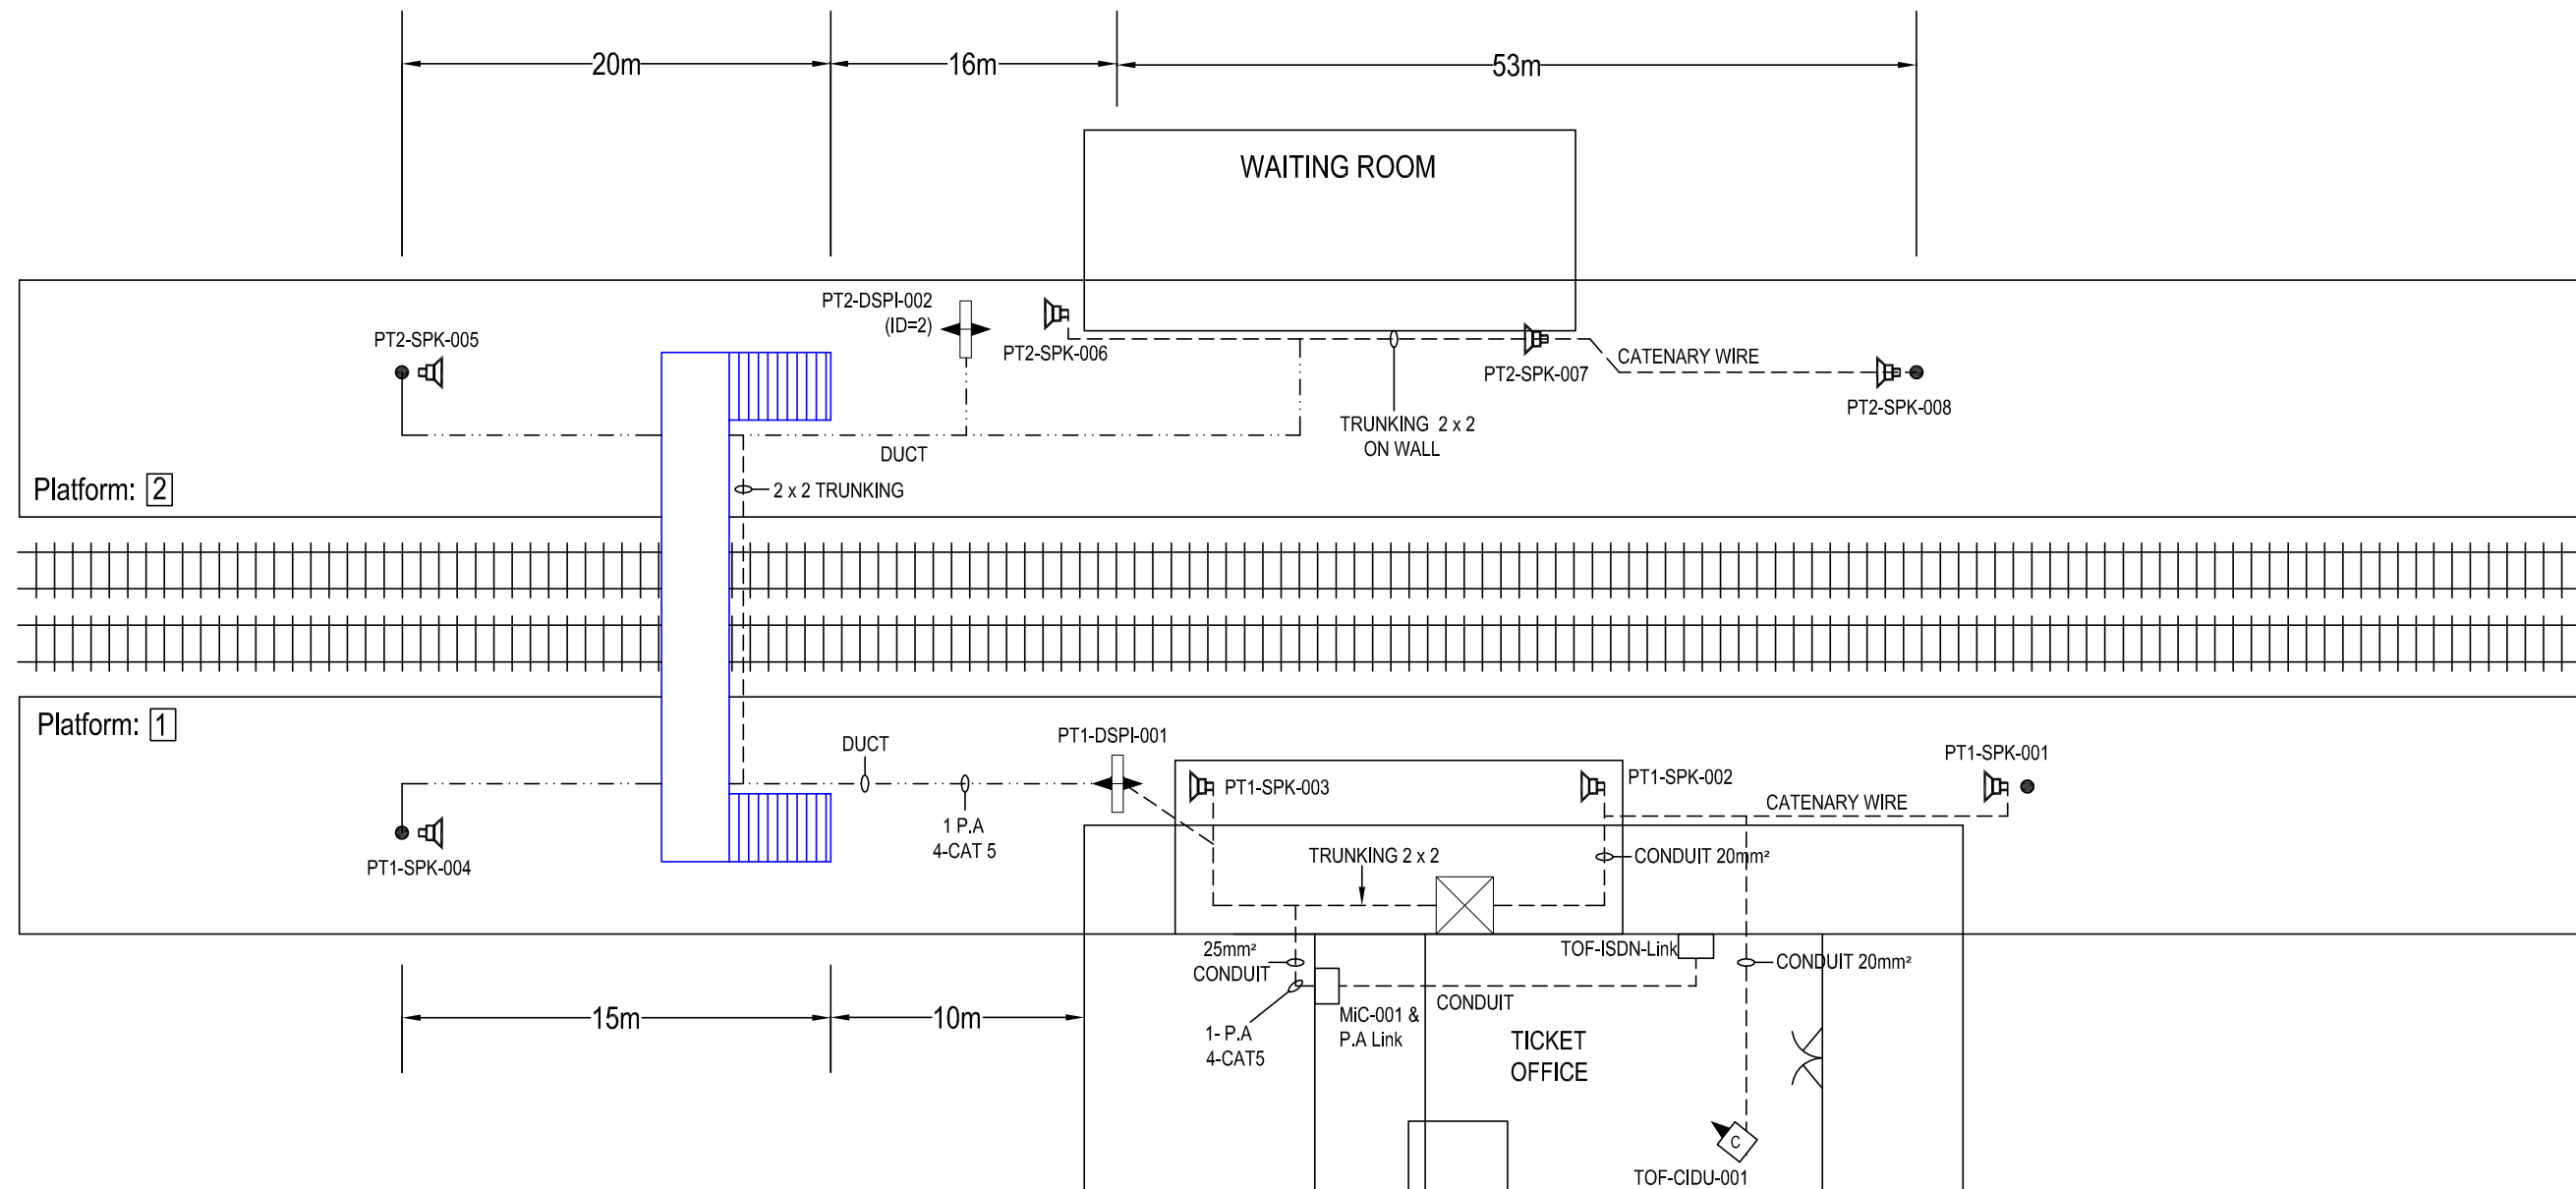

IF IN DOUBT ASK!

MATERIAL	CONSTRUCTION	NAME	SIGNATURE	DATE	 AMEY DATEL Project Offices 1st Floor, Platform 2/3 Eastleigh Station Southampton Road Eastleigh Hants SO50 9FL	SITE/PROJECT		SOUTH WEST TRAINS CIS PROJECT	
		DRAWN BY	D GADDU	13-05-2002		TITLE	FRIMLEY AS BUILT		
FINISH	CONSTRUCTION	CHECKED BY	T WONG		COPYRIGHT © AMEY Rail All rights reserved. Neither this drawing or any of the information it contains may be copied or communicated to third parties without the written permission of the copyright holder	SCALE	DRG No.	ISSUE	SHEET
		APPD BY	A SMITH			NTS	SM803-75683	B	1 of 1
		APPD BY							
		CAD Ref:							
		CONTRACTOR'S Ref:							