



WAN	
CIRCUIT ID	KXIP400455
IP ADDRESS	10.227.41.1

"PLATFORM 1 HP ISDN"
01-252-541543
"PLATFORM 2 HP ISDN"
01-252-541546

All Equipment tags to be prefixed with "FNB-"

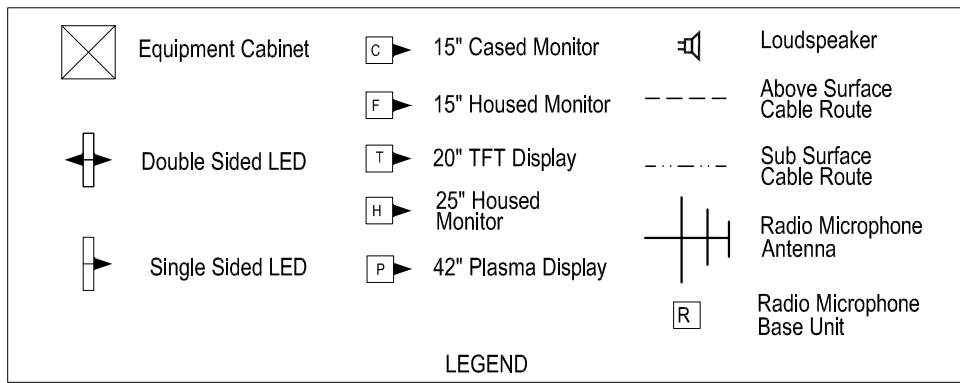

Equipment	Dist Board	
PT2-DSPI-003	COF GP CCT8	20A
BH-CIDU-002	EXISTING SPUR	
CIS RACK	MEM GP1 CCT26	B16
TOF-CIDU-001	MEM GP1 CCT 2	B16
PT1-DSPI-002	CRABTREE GP1 CCT5	10A
PT1-DSPI-001	WAITING RM GP CCT7	10A

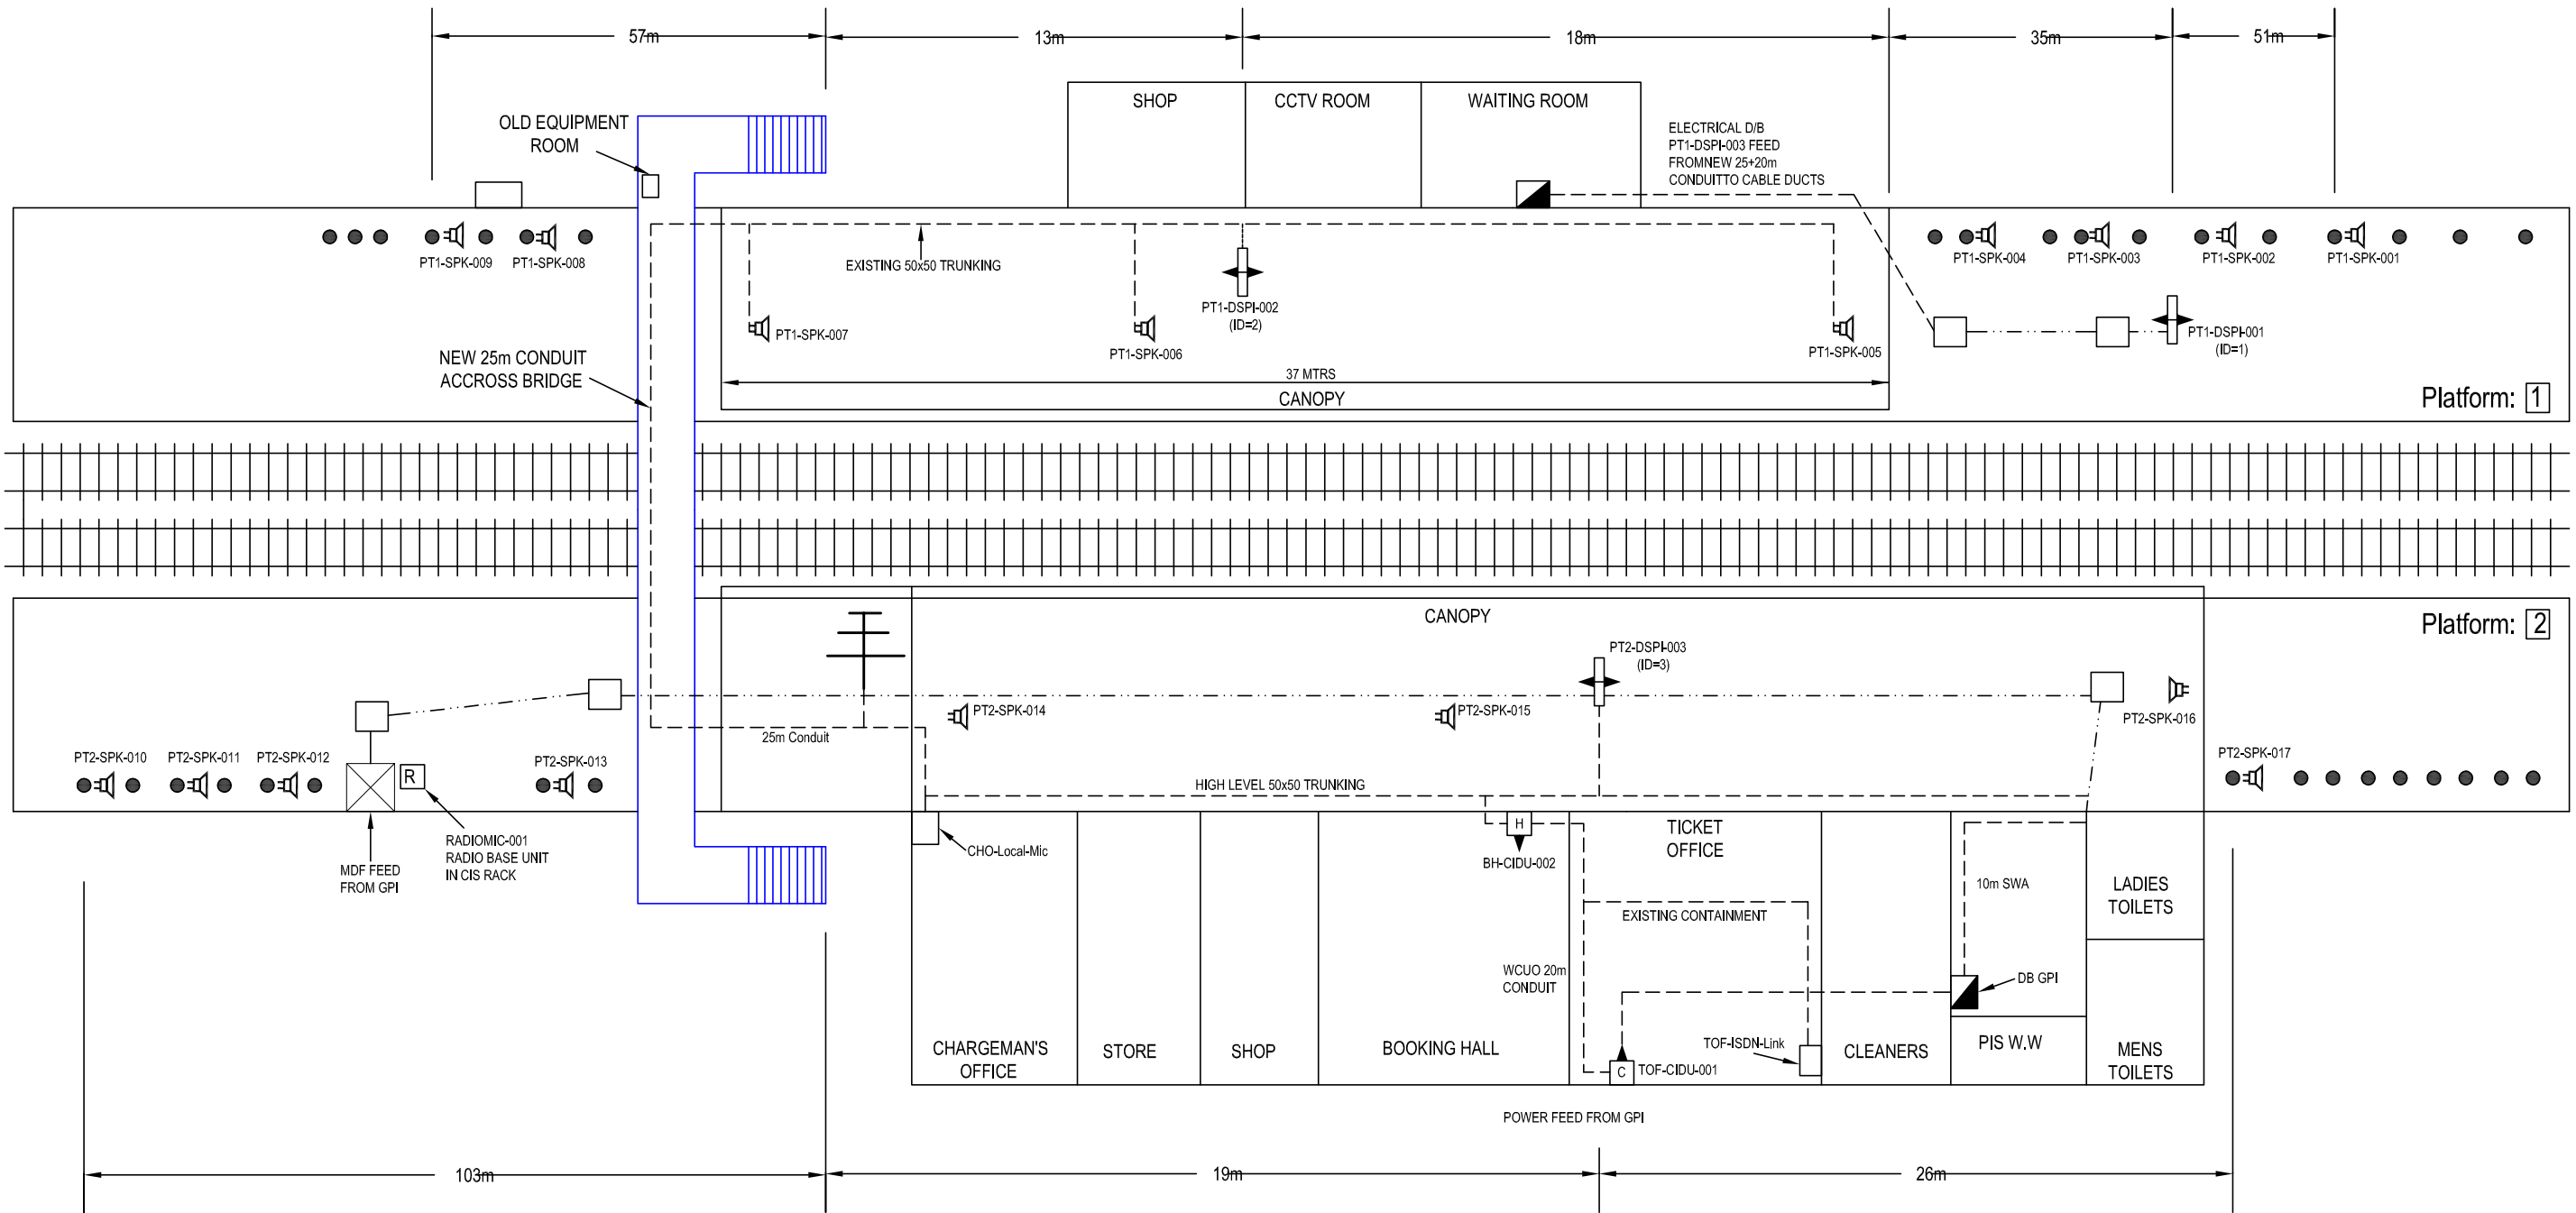

IF IN DOUBT ASK!

MATERIAL	CONSTRUCTION	NAME	SIGNATURE	DATE	<p>AMEY DATEL Project Offices 1st Floor, Platform 2/3 Eastleigh Station Southampton Road Eastleigh Hants SO50 9FL</p>	SITE/PROJECT		
		DRAWN BY	D GADDU	23-01-2002		SOUTH WEST TRAINS CIS PROJECT		
FINISH	CONSTRUCTION	CHECKED BY	T WONG		<p>COPYRIGHT © AMEY Rail All rights reserved. Neither this drawing or any of the information it contains may copied or communicated to third parties without the written permission of the copyright holder</p>	TITLE		
		APPD BY	A SMITH			FARNBOROUGH AS BUILT		
		CAD Ref:			SCALE	DRG No.	ISSUE	SHEET
		CONTRACTOR'S Ref:			NTS	SM803-75521	B	1 of 1