


DRG No. SM803-75643


WAN	
CIRCUIT ID	KXIP 400456
IP ADDRESS	10.228.144.1

"PLATFORM 1 HP ISDN"
01483-861330
"PLATFORM 2 HP ISDN"
01483-861332

All Equipment tags to be prefixed with "FNC-"

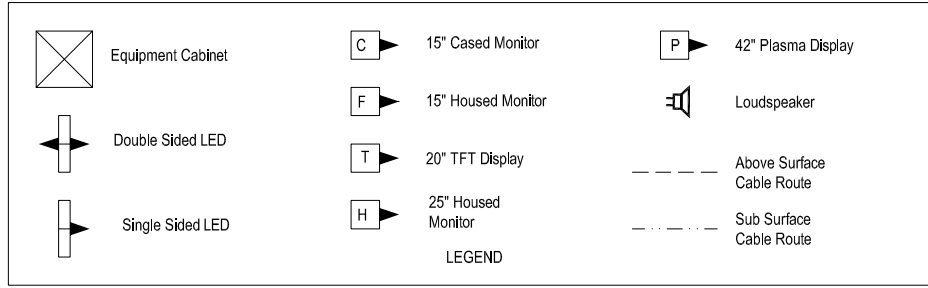

Equipment	Dist Board	Dist Board
CIS CABINET SUPPLY	EQUIPMENT ROOM DIST. BOARD	WAY NO. 3
LED PLATFORM 1 Equipment	G.P.D.B 1	WAY NO. 4
LED PLATFORM 2	G.P.D.B 2	WAY NO. 11
BOOKING HALL MONITOR	G.P.D.B 2	WAY NO. 3

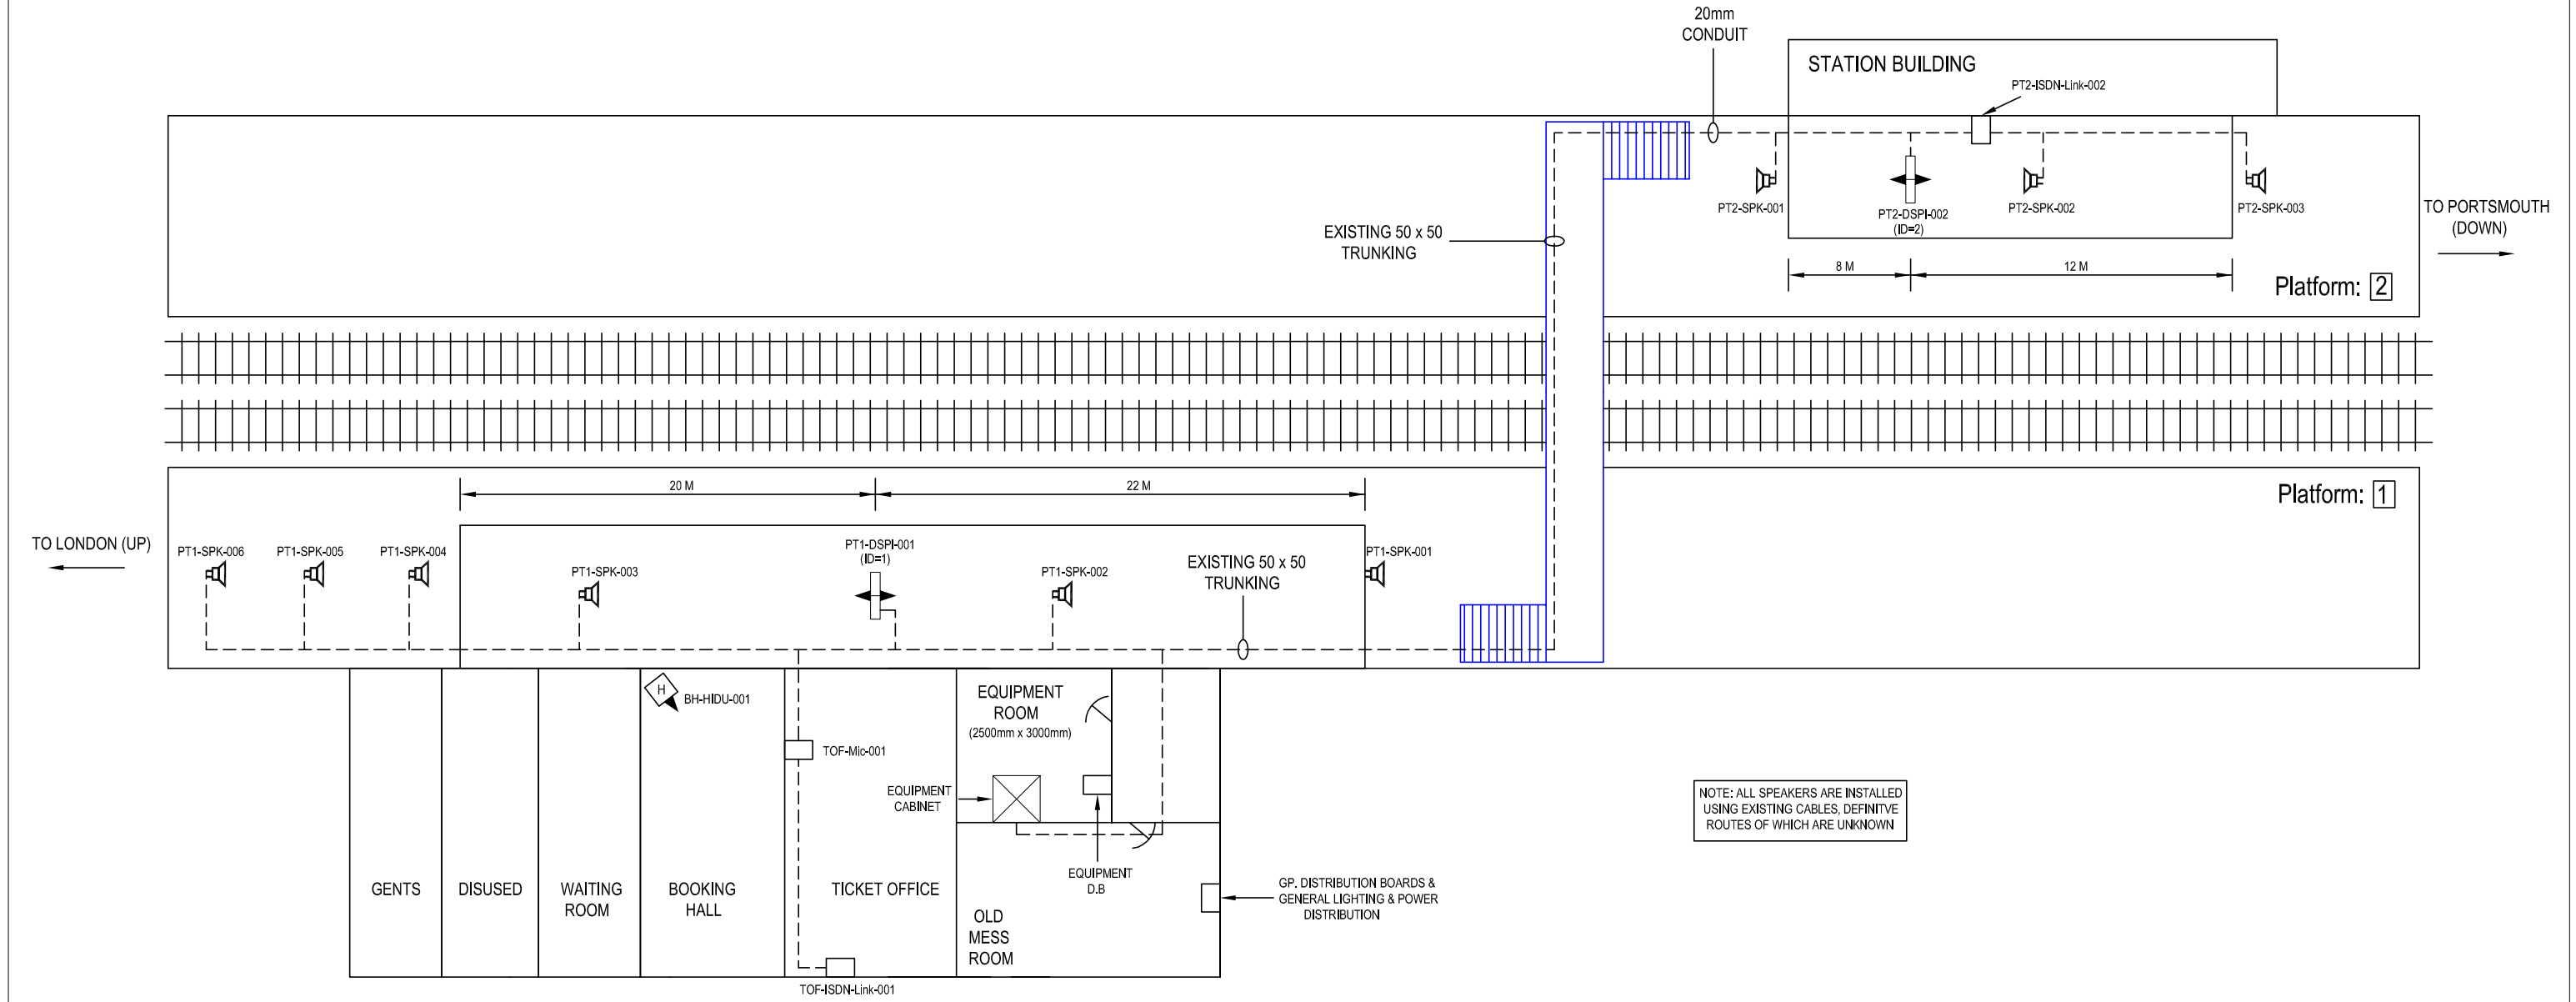

IF IN DOUBT ASK!

MATERIAL	CONSTRUCTION	NAME	SIGNATURE	DATE	<p>AMEY DATEL Project Offices 1st Floor, Platform 2/3 Eastleigh Station Southampton Road Eastleigh Hants SO50 9FL</p>	SITE/PROJECT		SOUTH WEST TRAINS CIS PROJECT	
		DRAWN BY	D GADDU	16-04-2002		TITLE	FARNCOMBE AS BUILT		
FINISH		CHECKED BY	T WONG		<p>COPYRIGHT © AMEY Rail All rights reserved. Neither this drawing or any of the information it contains may be copied or communicated to third parties without the written permission of the copyright holder</p>	SCALE	DRG No.	ISSUE	SHEET
		APPD BY	A SMITH			NTS	SM803-75643	B	1 of 1
		CONTRACTOR'S Ref:							