



WAN	
CIRCUIT ID	KXIP400457
IP ADDRESS	10.227.97.1

PLATFORM 1 "HP-4SDN"
01-252-734013
PLATFORM 2 "HP-4SDN"
01-252-734017

All Equipment tags to be prefixed with "FNH-"

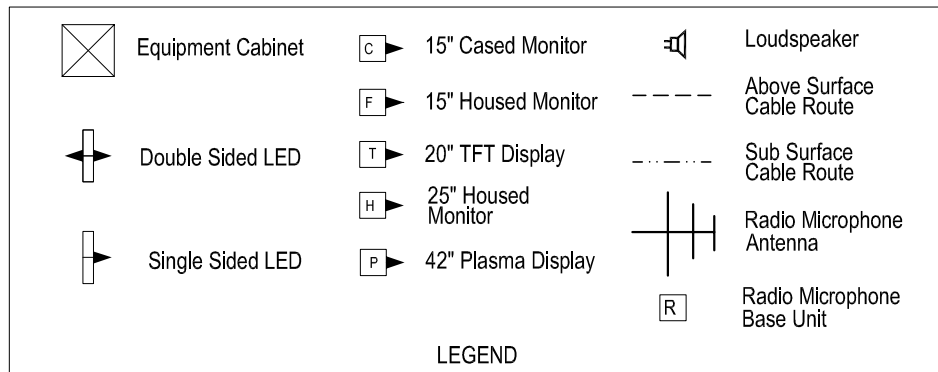

Equipment	Dist Board
CIS RACK	6 WAY CRABTREE CCT 2
ALL OTHERS ON EXISTING SPURS	

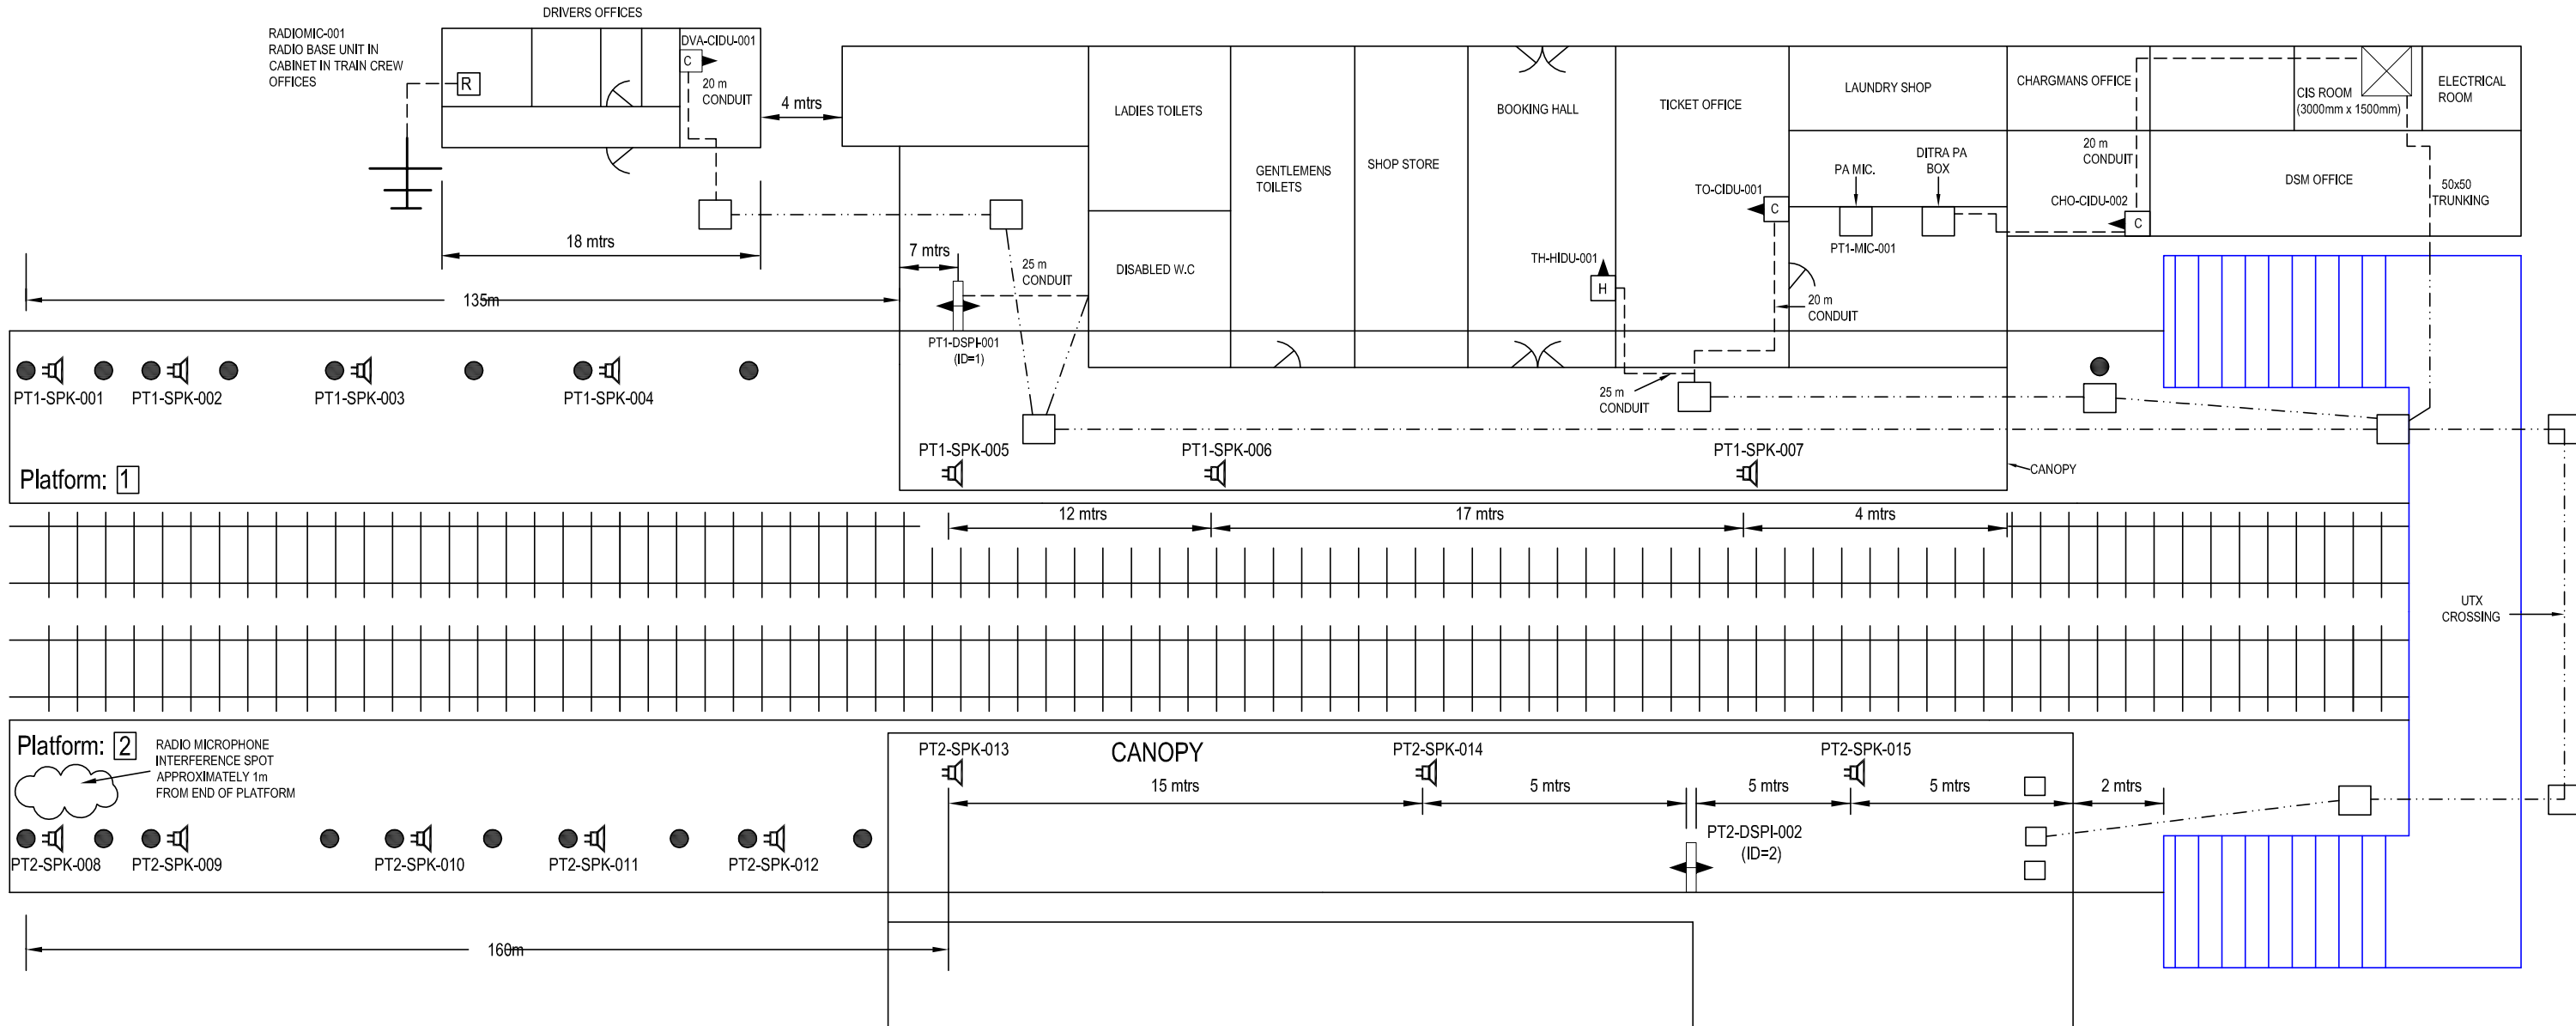

IF IN DOUBT ASK!

MATERIAL	CONSTRUCTION	DRAWN BY	A HATTON	SIGNATURE		<p>AMEY DATEL Project Offices 1st Floor, Platform 2/3 Eastleigh Station Southampton Road Eastleigh Hants SO50 9FL</p>	SITE/PROJECT		SOUTH WEST TRAINS CIS PROJECT	
		CHECKED BY	T WONG				TITLE		FARNHAM STATION AS BUILT	
FINISH		APPD BY	A SMITH			<p>COPYRIGHT © AMEY Rail All rights reserved. Neither this drawing or any of the information it contains may be copied or communicated to third parties without the written permission of the copyright holder</p>	SCALE	DRG No.	ISSUE	SHEET
		CAD Ref:					NTS	SM803-75545	B	1 of 1
		CONTRACTOR'S Ref:								