


DRG No. SM803-75884


WAN	
CIRCUIT ID	KXIP 400458
IP ADDRESS	10.227.145.1

"PLATFORM 1 HP ISDN"
01404-850017

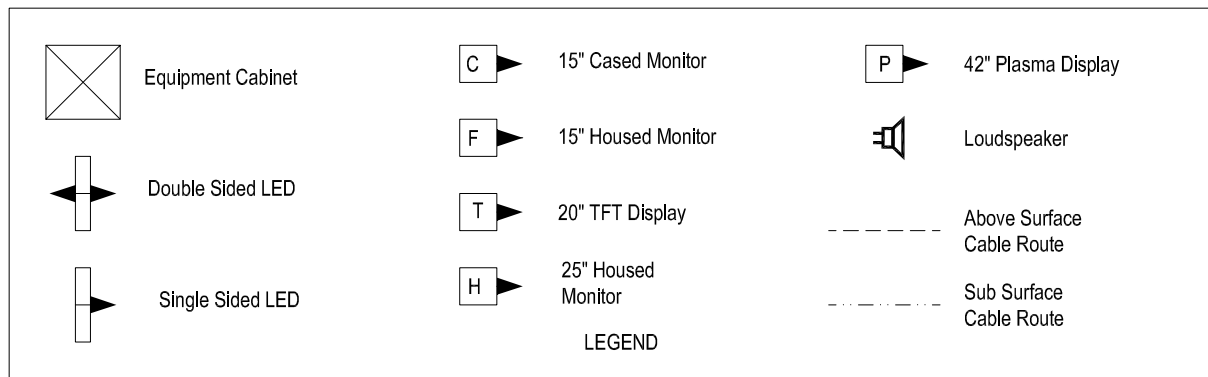

Equipment	Dist Board
HEATER	CCT NO. 1
13 AMP TWIN	CCT NO. 2
CIS RACK	CCT NO.3
FAN & STAT	CCT NO.4
LED PT1	CCT NO.5
SPARE	6-9

All Equipment tags to be prefixed with "FNT-"

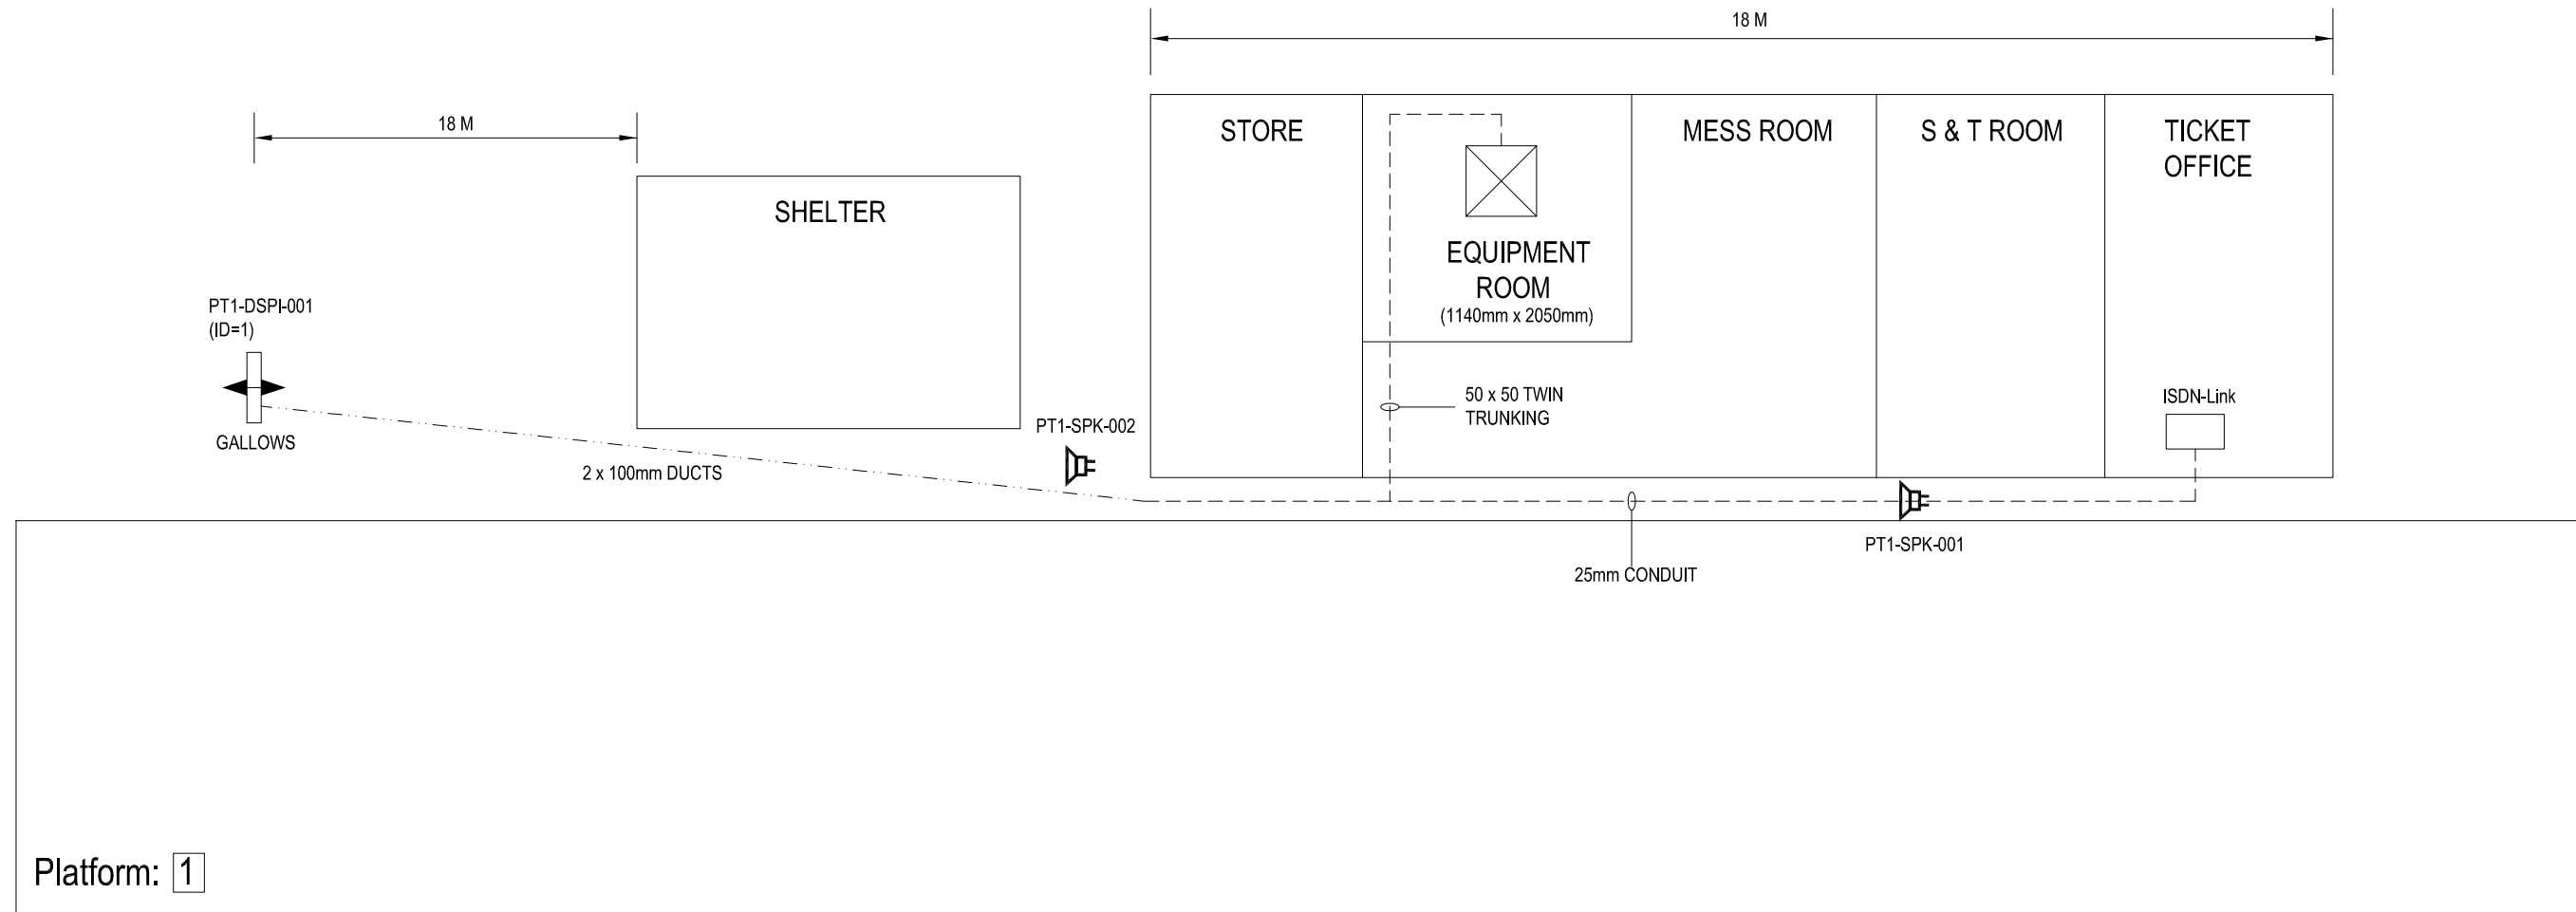

Platform: 1

IF IN DOUBT ASK!

MATERIAL	CONSTRUCTION	NAME	SIGNATURE	DATE
		D GADDU		03-04-2002
		T WONG		
		A SMITH		
FINISH				
		CAD Ref:		
		CONTRACTOR'S Ref:		



AMEY DATEL Project  
Offices  
1st Floor, Platform  
2/3  
Eastleigh Station  
Southampton Road  
Eastleigh  
Hants  
SO50 9FL

COPYRIGHT © AMEY Rail  
All rights reserved. Neither this drawing or any of the information  
it contains may be copied or communicated to third parties  
without the written permission of the copyright holder

SITE/PROJECT		SOUTH WEST TRAINS CIS PROJECT	
TITLE		FENITON AS BUILT	
SCALE	DRG No.	ISSUE	SHEET
NTS	SM803-75884	B	1 of 1