


DRG No.

SM803-75545



WAN	
CIRCUIT ID	KXIP400454
IP ADDRESS	10.227.74.1

"PLATFORM 1 & 2 HP ISDN"
01-329-823491
"PLATFORM 2 HP ISDN"
01-329-823497

All Equipment tags to be prefixed with "FNH-"

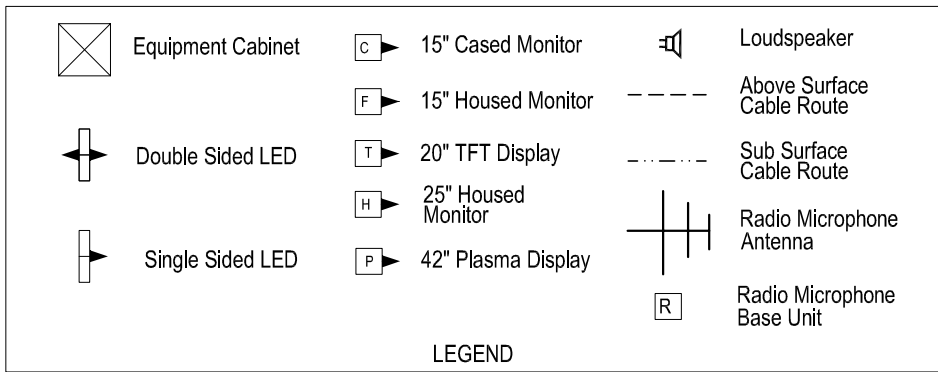

Equipment	Dist Board	
25"	CIS EQUIPMENT ROOM	NO. 4
LEDS PT1 & 2	BLUE Ø BOARD	NO. 9
CIS RACK	CCT NO. 2	

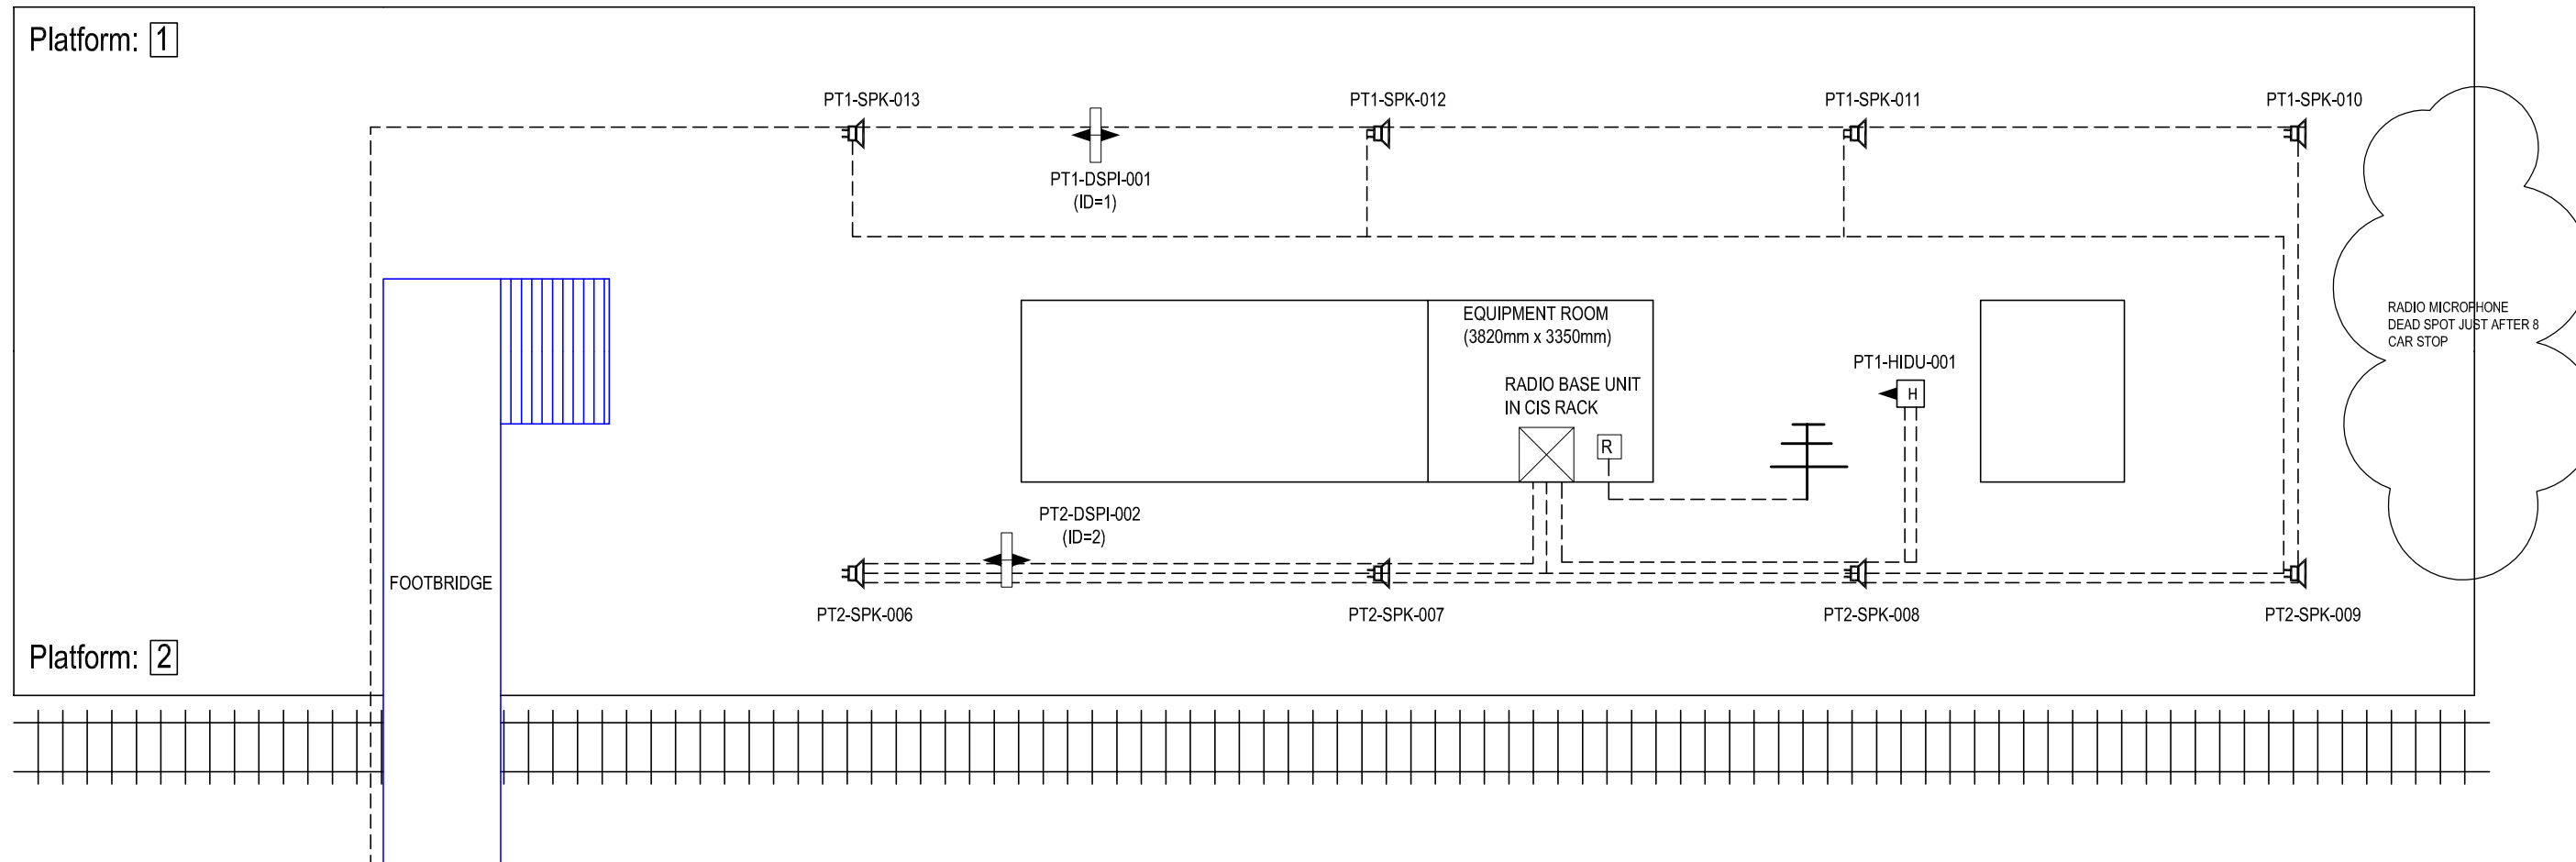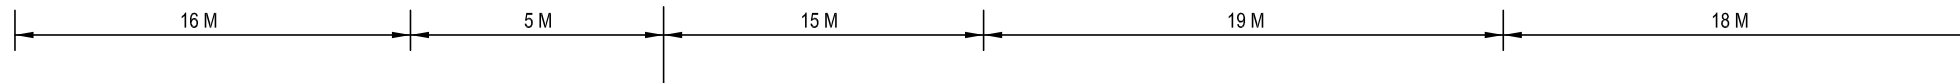

IF IN DOUBT ASK!

MATERIAL	CONSTRUCTION	<table border="1"> <thead> <tr> <th></th> <th>NAME</th> <th>SIGNATURE</th> <th>DATE</th> </tr> </thead> <tbody> <tr> <td>DRAWN BY</td> <td>D GADDU</td> <td></td> <td>05-06-2002</td> </tr> <tr> <td>CHECKED BY</td> <td>T WONG</td> <td></td> <td></td> </tr> <tr> <td>APPD BY</td> <td>A SMITH</td> <td></td> <td></td> </tr> <tr> <td>APPD BY</td> <td></td> <td></td> <td></td> </tr> </tbody> </table>				NAME	SIGNATURE	DATE	DRAWN BY	D GADDU		05-06-2002	CHECKED BY	T WONG			APPD BY	A SMITH			APPD BY				<p>AMEY DATEL Project Offices 1st Floor, Platform 2/3 Eastleigh Station Southampton Road Eastleigh Hants SO50 9FL</p>	SITE/PROJECT		SOUTH WEST TRAINS CIS PROJECT	
			NAME	SIGNATURE	DATE																								
DRAWN BY	D GADDU		05-06-2002																										
CHECKED BY	T WONG																												
APPD BY	A SMITH																												
APPD BY																													
FINISH		CAD Ref:		<p>COPYRIGHT © AMEY Rail All rights reserved. Neither this drawing or any of the information it contains may be copied or communicated to third parties without the written permission of the copyright holder</p>	TITLE		FAREHAM PLATFORMS 1 & 2 AS BUILT																						
		CONTRACTOR'S Ref:			SCALE	DRG No.	ISSUE	SHEET	NTS	SM803-75545	B	1 of 2																	


DRG No.

SM803-75545


WAN	
CIRCUIT ID	KXIP400454
IP ADDRESS	10.227.74.1

"PLATFORM 1 & 2 HP ISDN"
01-329-823491
"PLATFORM 2 HP ISDN"
01-329-823497

All Equipment tags to be prefixed with "FNH-"

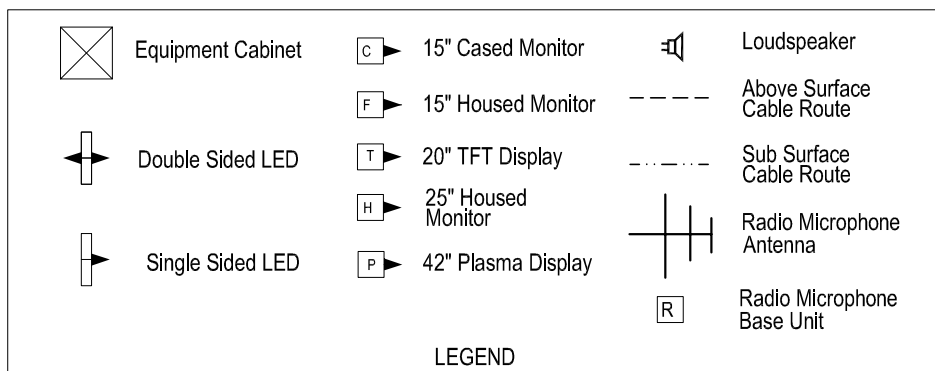

Equipment	Dist Board	
IDU 001	EXISTING SPURS	SEE SHEET 1
IDU 002		
DSPI 001		
IDU 003	EXISTING	

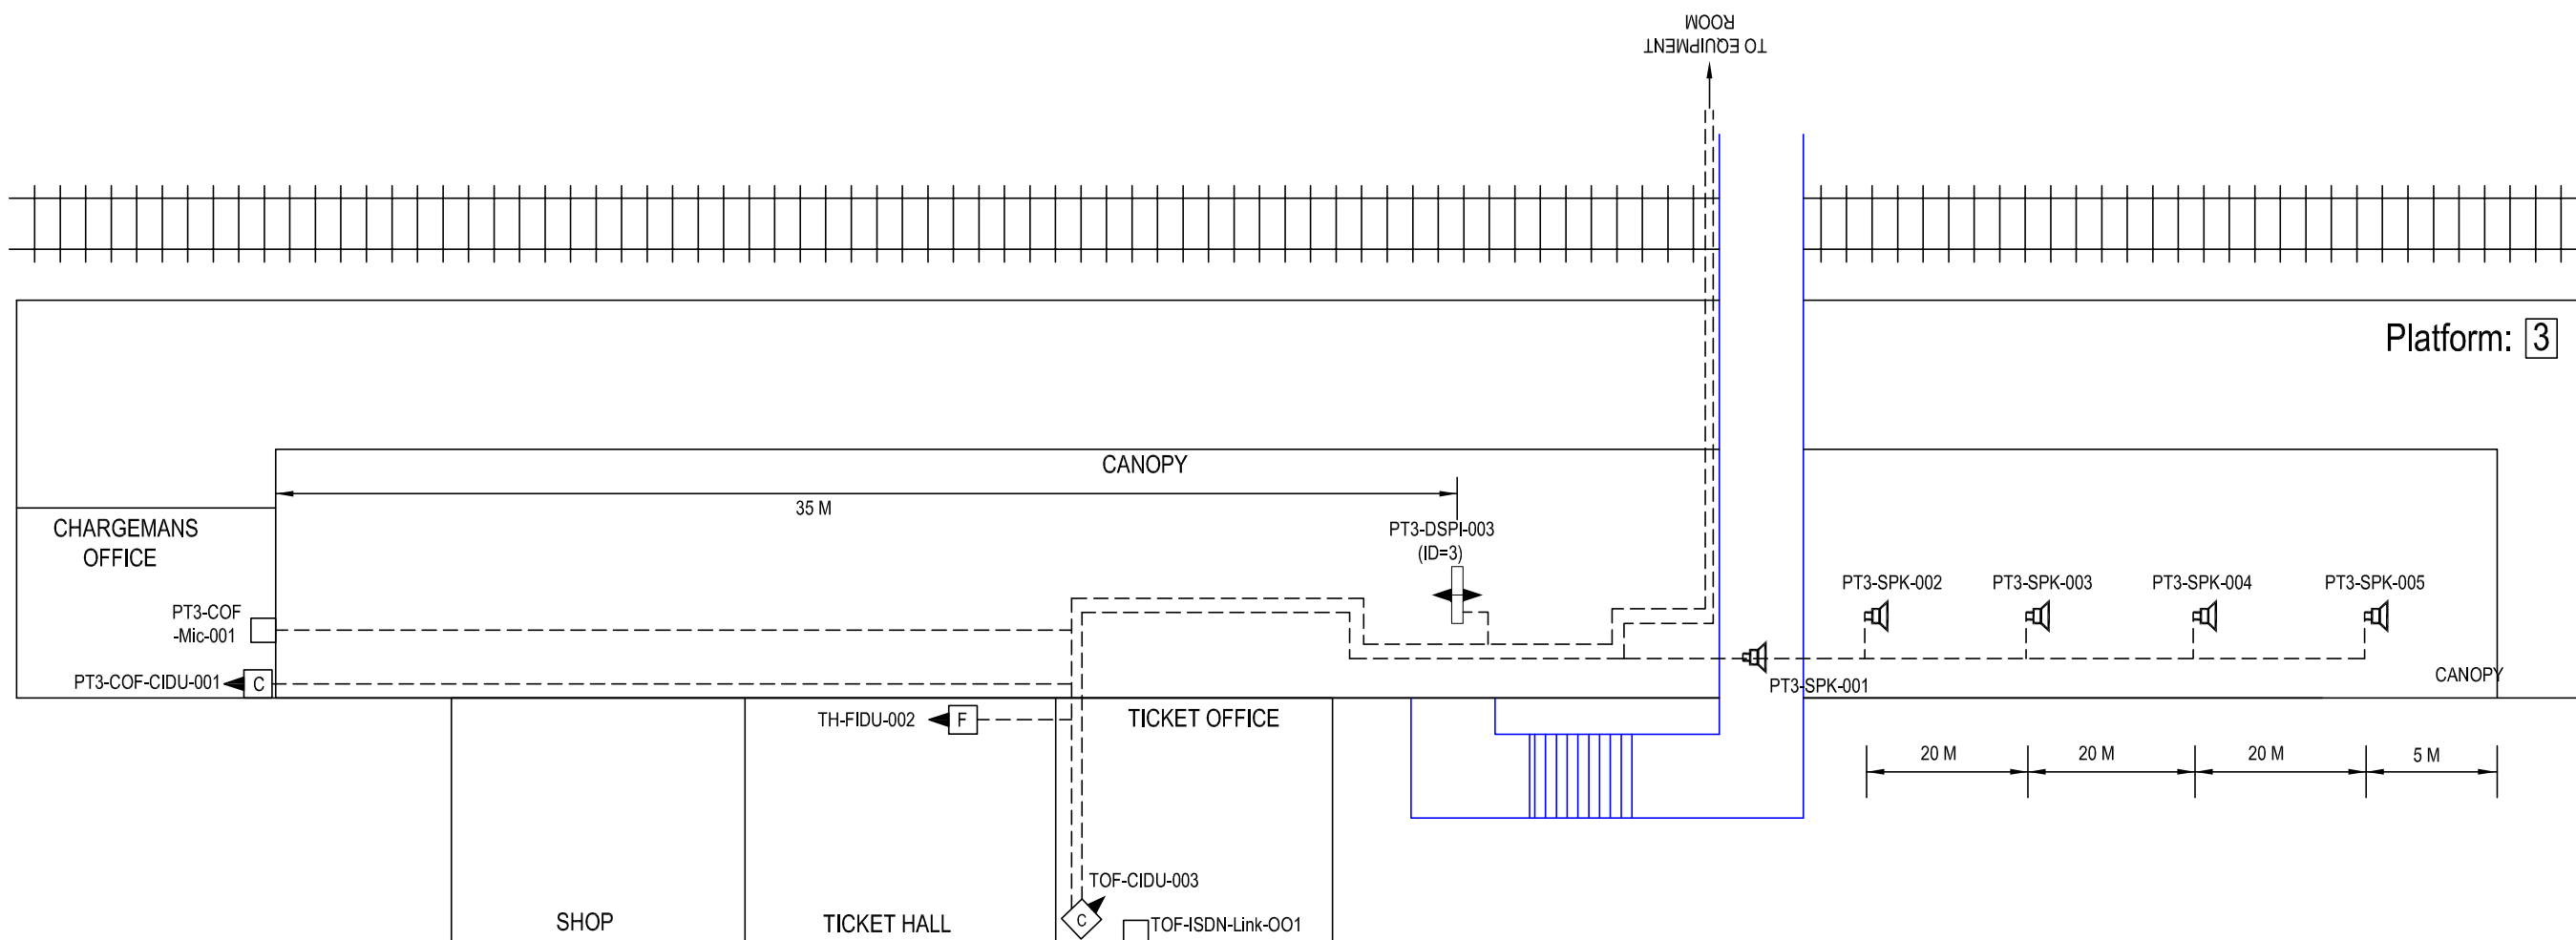

IF IN DOUBT ASK!

MATERIAL	CONSTRUCTION	NAME	SIGNATURE	DATE	 <p>AMEY DATEL Project Offices 1st Floor, Platform 2/3 Eastleigh Station Southampton Road Eastleigh Hants SO50 9FL</p>	SITE/PROJECT		
		DRAWN BY		05-06-2002		SOUTH WEST TRAINS CIS PROJECT		
FINISH		CHECKED BY			<p>COPYRIGHT © AMEY Rail All rights reserved. Neither this drawing or any of the information it contains may be copied or communicated to third parties without the written permission of the copyright holder</p>	TITLE		
		APPD BY				FAREHAM PLATFORM 3 AS BUILT		
		CAD Ref:			SCALE	DRG No.	ISSUE	SHEET
		CONTRACTOR'S Ref:			NTS	SM803-75545	B	2 of 2