


WAN	
CIRCUIT ID	KXIP 400460
IP ADDRESS	10.227.51.1


"PLATFORM 1 HP ISDN"
02392-833834
"PLATFORM 2 HP ISDN"
02392-833840

All Equipment tags to be prefixed with "FTN-"

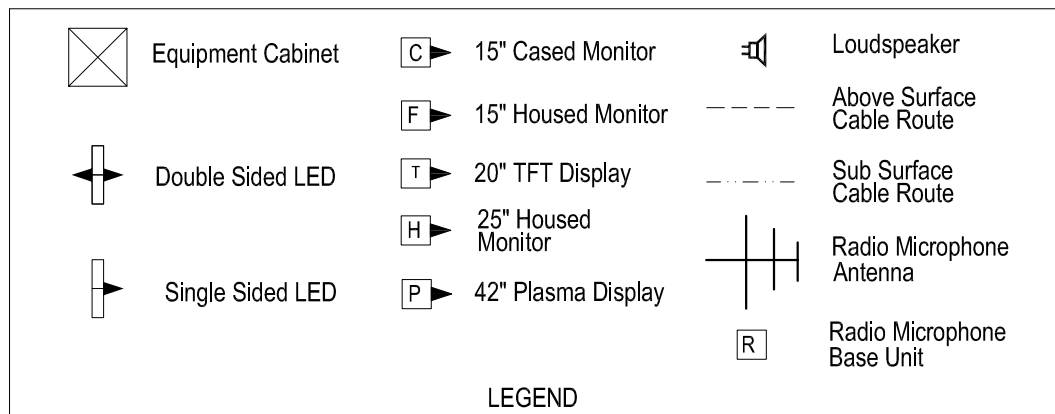

Equipment	Dist Board
CIS RACK	GP1 CCT 3
ALL OTHER EQUIPMENT ON EXISTING SPURS	

PLATFORMS 2 & 3 ON SHEET 2

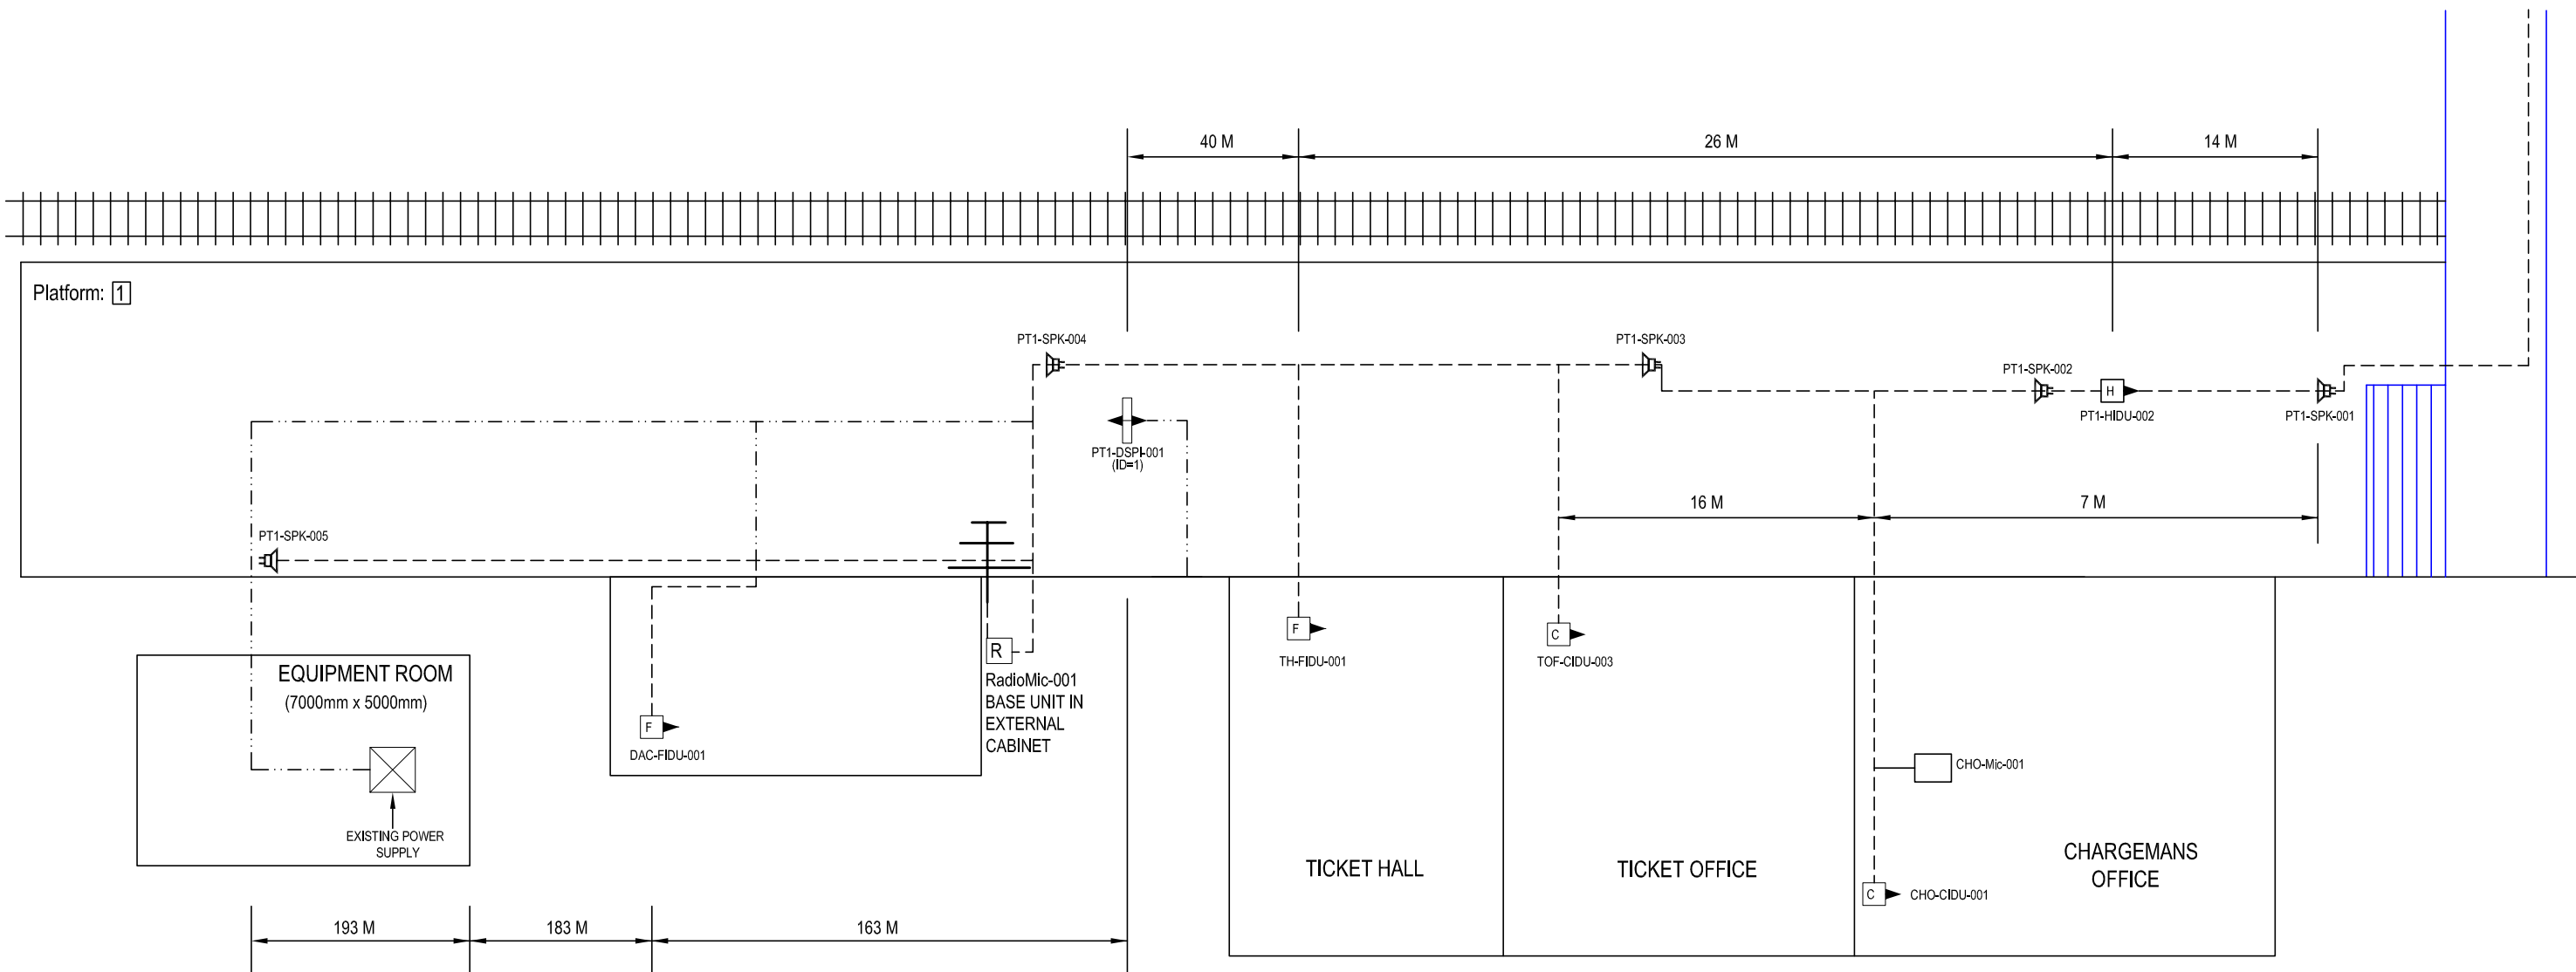

IF IN DOUBT ASK!


MATERIAL	CONSTRUCTION	<table border="1"> <tr> <th>NAME</th> <th>SIGNATURE</th> <th>DATE</th> </tr> <tr> <td>D GADDU</td> <td></td> <td>14-05-2002</td> </tr> <tr> <td>T WONG</td> <td></td> <td></td> </tr> <tr> <td>A SMITH</td> <td></td> <td></td> </tr> </table>			NAME	SIGNATURE	DATE	D GADDU		14-05-2002	T WONG			A SMITH			<p>AMEY DATEL Project Offices 1st Floor, Platform 2/3 Eastleigh Station Southampton Road Eastleigh Hants SO50 9FL</p>	SITE/PROJECT		SOUTH WEST TRAINS CIS PROJECT	
		NAME	SIGNATURE	DATE																	
D GADDU		14-05-2002																			
T WONG																					
A SMITH																					
FINISH				TITLE		FRATTON AS BUILT															
		CAD Ref:			SCALE	DRG No.	ISSUE	SHEET													
		CONTRACTOR'S Ref:			NTS	SM803-75509	B	1 of 2													

COPYRIGHT © AMEY Rail
All rights reserved. Neither this drawing or any of the information it contains may be copied or communicated to third parties without the written permission of the copyright holder


WAN	
CIRCUIT ID	KXIP 400460
IP ADDRESS	10.227.51.1

"PLATFORM 1 HP ISDN"
02392-833834
"PLATFORM 2 HP ISDN"
02392-833840

All Equipment tags to be prefixed with "FTN-"

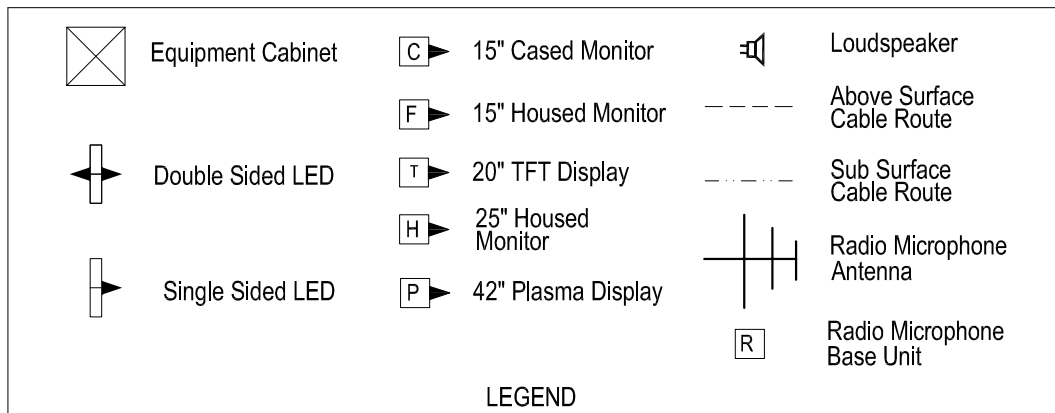

Equipment	Dist Board
CIS RACK	GP1 CCT 3
ALL OTHER EQUIPMENT ON EXISTING SPURS	

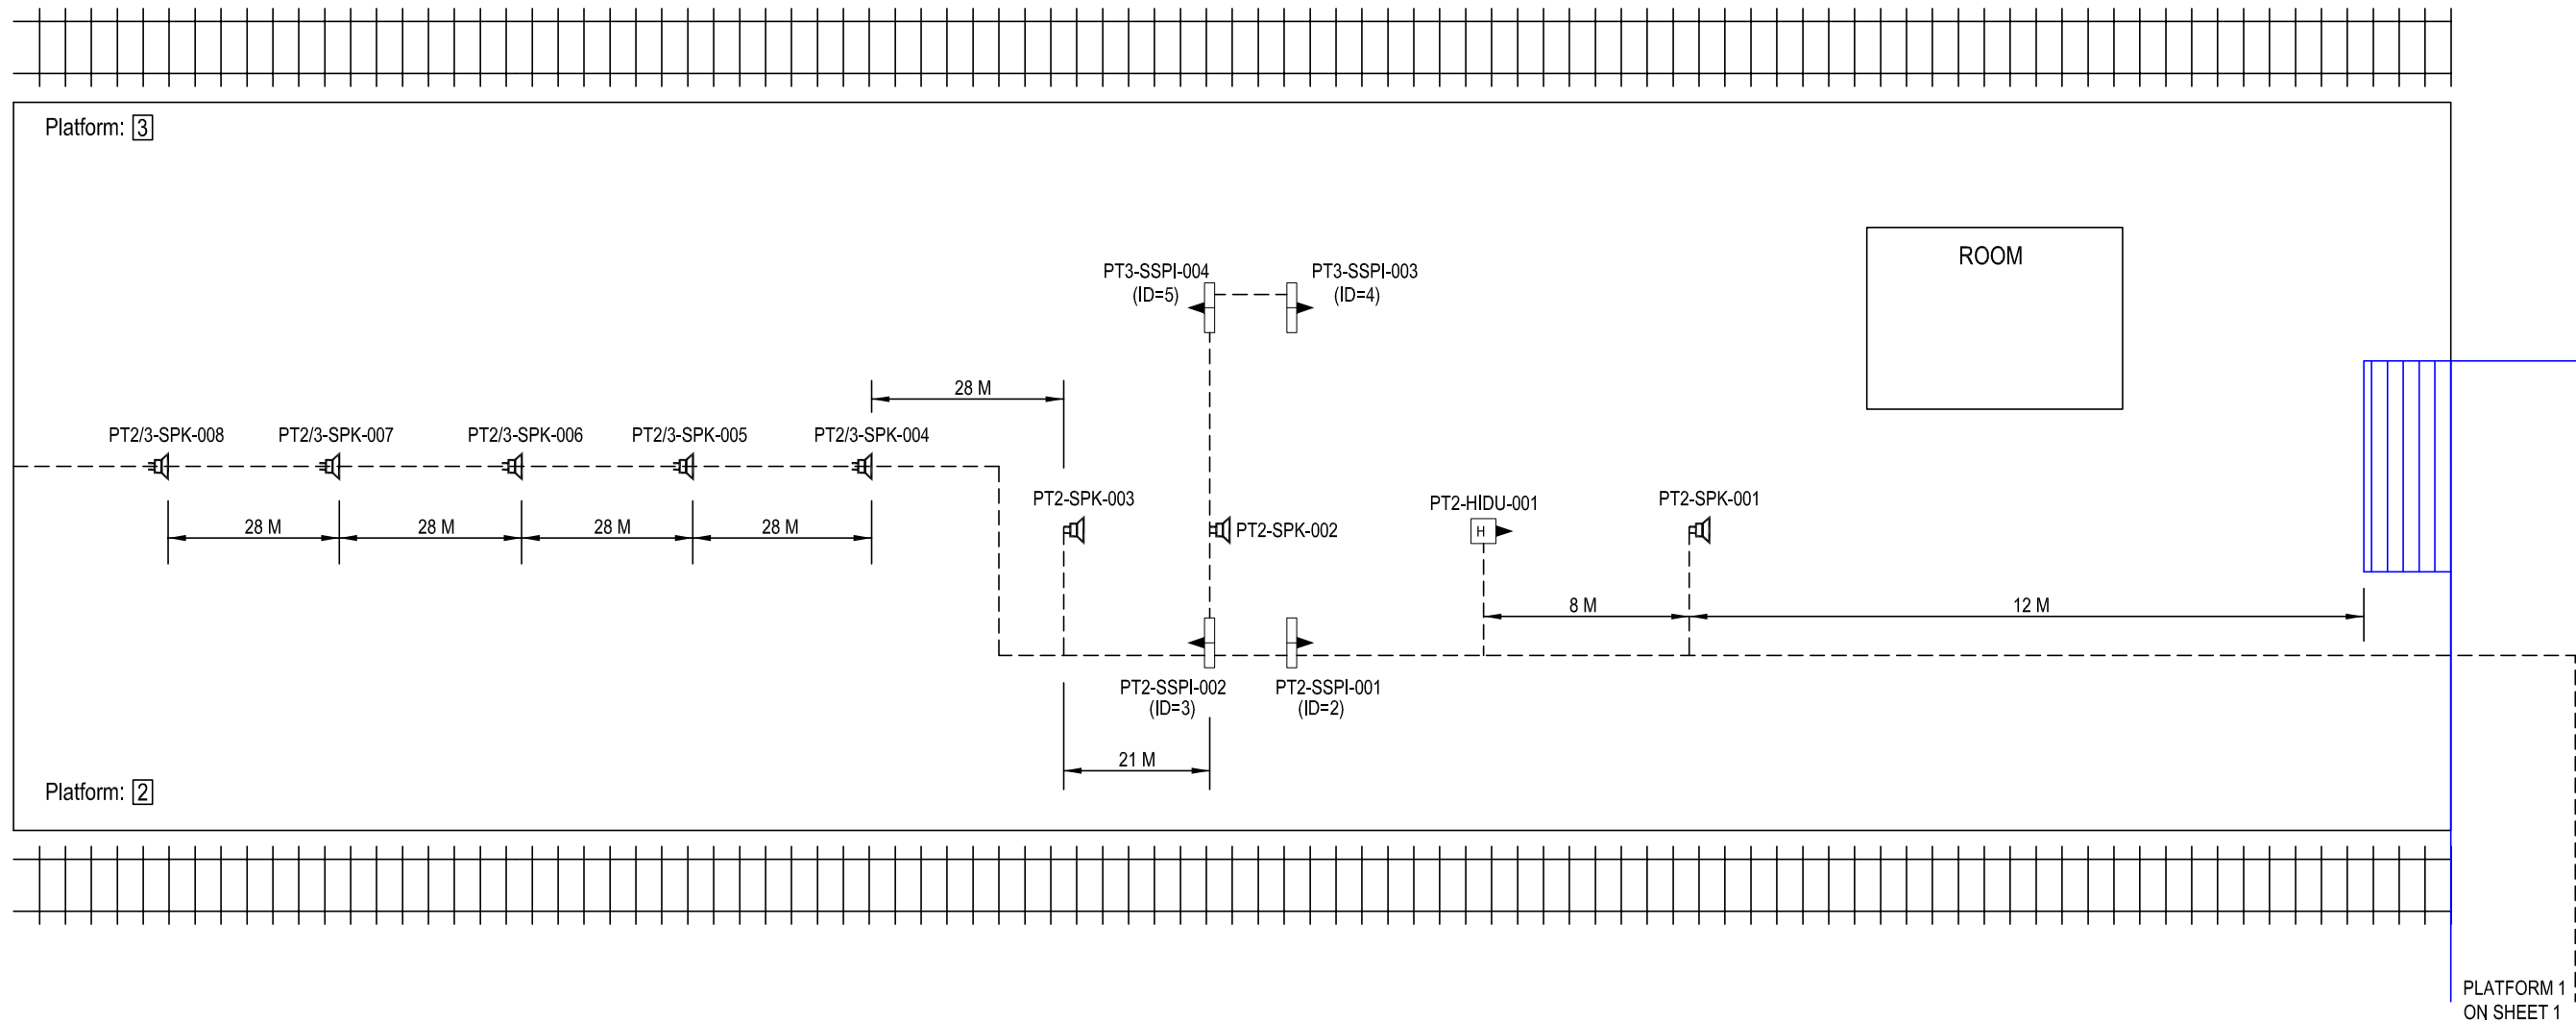

IF IN DOUBT ASK!

MATERIAL	CONSTRUCTION	DRAWN BY			AMEY DATEL Project		SITE/PROJECT		
		NAME	SIGNATURE	DATE	AMEY DATEL Project Offices 1st Floor, Platform 2/3 Eastleigh Station Southampton Road Eastleigh Hants SO50 9FL	SOUTH WEST TRAINS CIS PROJECT			
		D GADDU		14-05-2002		TITLE	FRATTON AS BUILT		
		T WONG				SCALE	DRG No.	ISSUE	SHEET
		A SMITH				NTS	SM803-75509	B	2 of 2
FINISH		CONTRACTOR'S Ref:			COPYRIGHT © AMEY Rail All rights reserved. Neither this drawing or any of the information it contains may be copied or communicated to third parties without the written permission of the copyright holder				