


SM803-75631


WAN	
CIRCUIT ID	MXIP201537
IP ADDRESS	10.227.33.1

All Equipment tags to be prefixed with "GLD-"

"T HP ISDN"	01-483-503208	"PLATFORM 5 HP ISDN"	01-483-503241
"PLATFORM 1 HP ISDN"	01-483-503211	"PLATFORM 7 HP ISDN"	01-483-503249
"PLATFORM 3 HP ISDN"	01-483-503235		

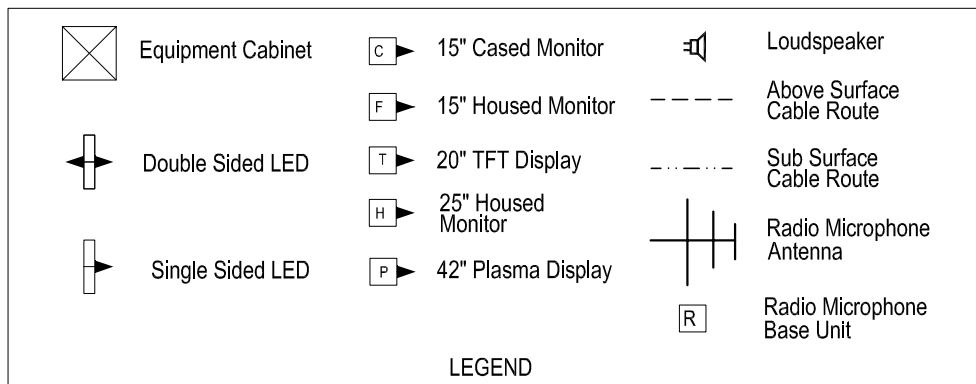

Equipment	Dist Board
EXISTING CIRCUITS EXTENDED	

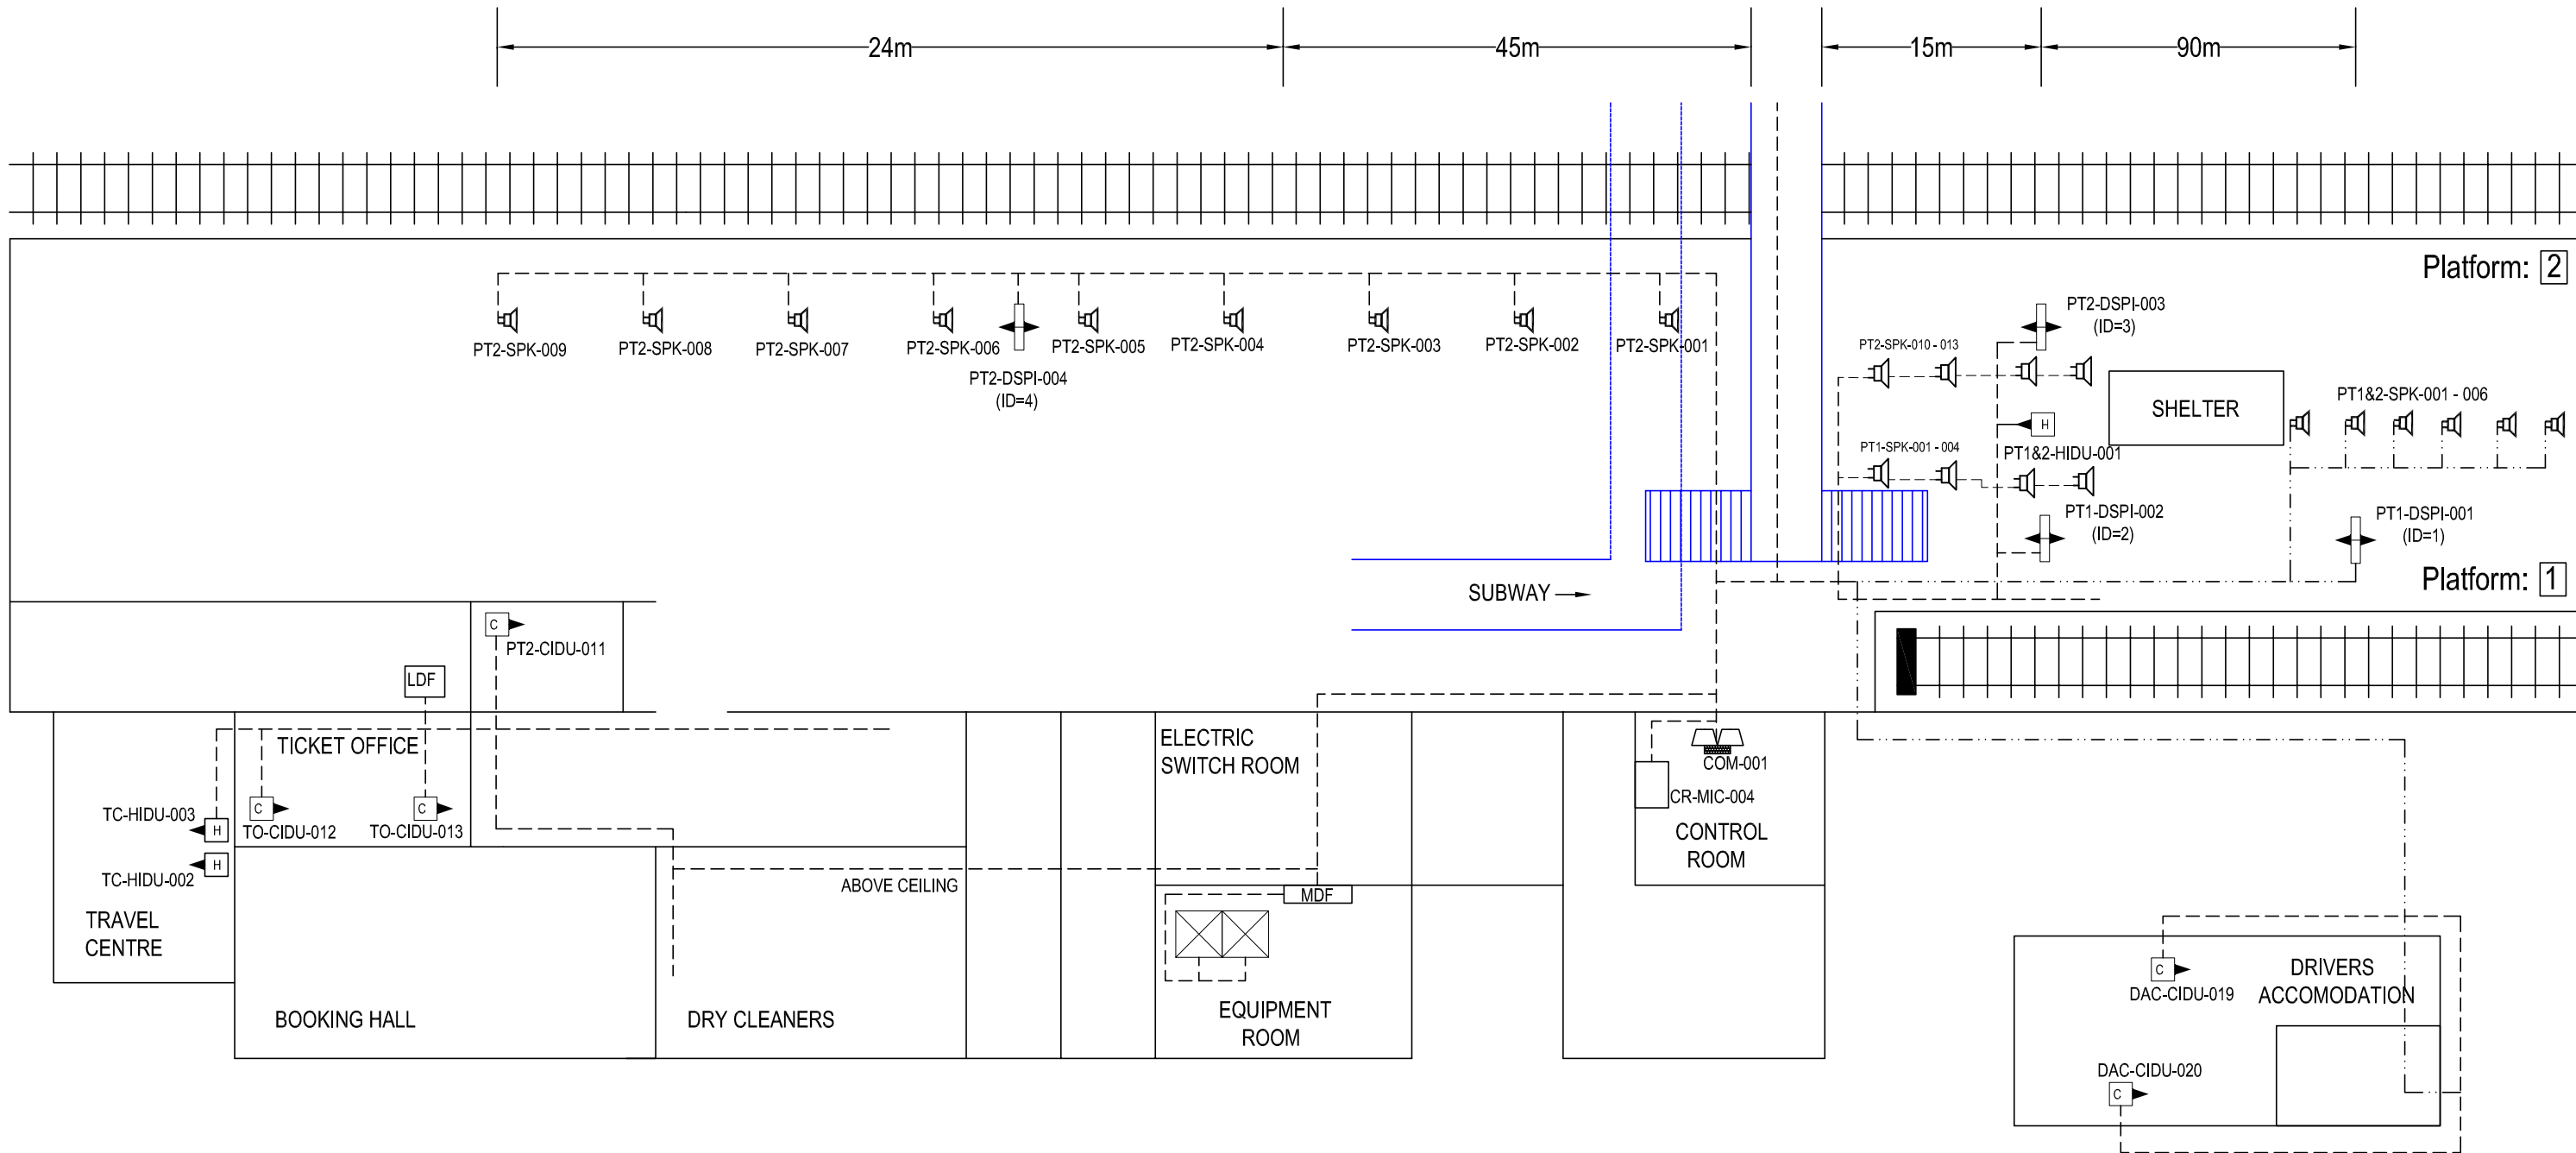

IF IN DOUBT ASK!

Date of Last Modification: 25 April 2003

This Drawing Supersedes Any Previous Drawings

FINISH

CONSTRUCTION	NAME	SIGNATURE	DATE
DRAWN BY	J STEVENS		25-04-2003
CHECKED BY	T WONG		
APPD BY	A SMITH		
APPD BY			
CAD Ref:			
CONTRACTOR'S Ref:			



AMEY DATEL Project
Offices
1st Floor, Platform
2/3
Eastleigh Station
Southampton Road
Eastleigh
Hants
SO50 9FL

SITE/PROJECT		SOUTH WEST TRAINS CIS PROJECT	
TITLE		GUILDFORD PLATFORMS 1 & 2 AS BUILT	
SCALE	DRG No.	ISSUE	SHEET
NTS	SM803-75631	C	1 of 5

COPYRIGHT © AMEY Rail
All rights reserved. Neither this drawing or any of the information it contains may be copied or communicated to third parties without the written permission of the copyright holder

WAN	
CIRCUIT ID	MXIP201537
IP ADDRESS	10.227.33.1


All Equipment tags to be prefixed with "GLD-"

"T HP ISDN"	01-483-503208	"PLATFORM 5 HP ISDN"	01-483-503241
"PLATFORM 1 HP ISDN"	01-483-503211	"PLATFORM 7 HP ISDN"	01-483-503249
"PLATFORM 3 HP ISDN"	01-483-503235		

	Equipment Cabinet		15" Cased Monitor		Loudspeaker
	Double Sided LED		15" Housed Monitor		Above Surface Cable Route
	Single Sided LED		20" TFT Display		Sub Surface Cable Route
			25" Housed Monitor		Radio Microphone Antenna
			42" Plasma Display		Radio Microphone Base Unit

LEGEND

Equipment	Dist Board	
EXISTING		
CIRCUITS		
EXTENDED		

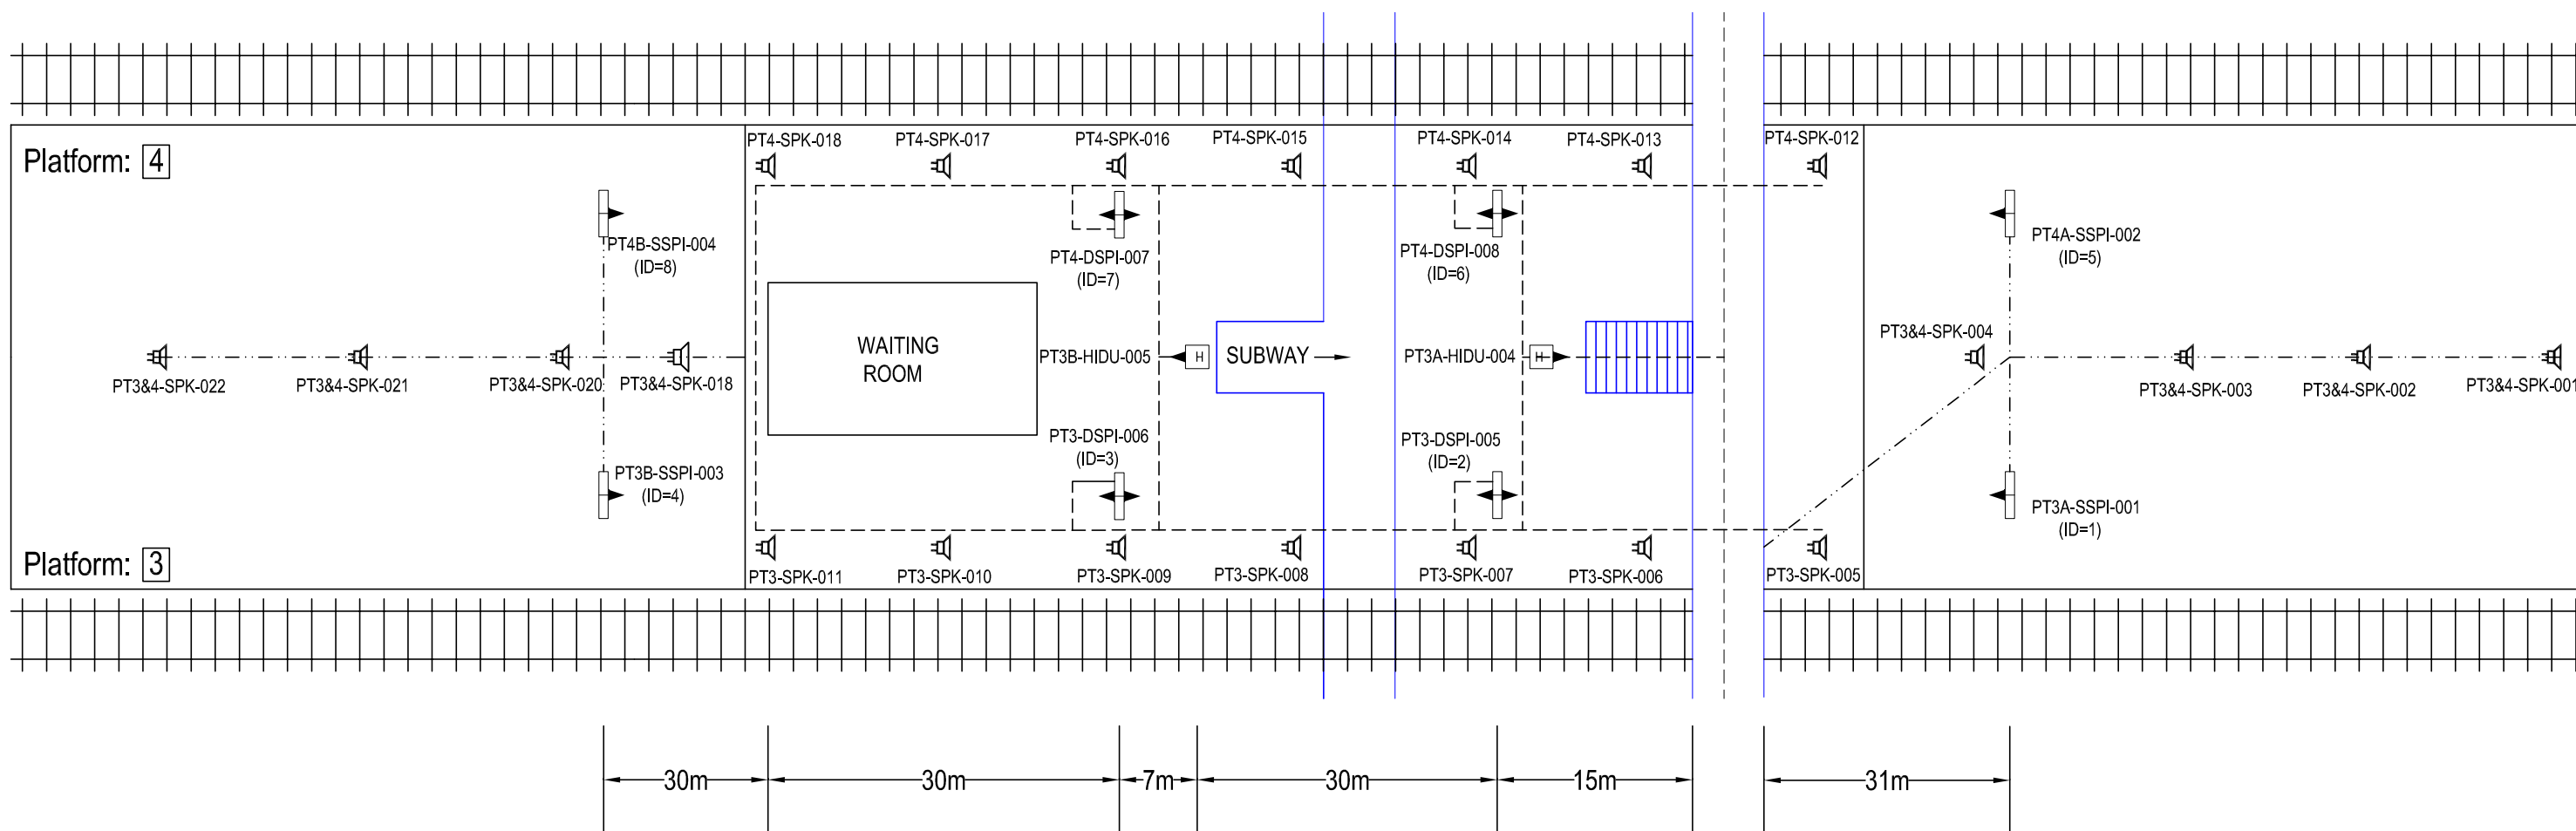

IF IN DOUBT ASK!

Date of Last Modification: 25 April 2003

CONSTRUCTION

NAME	SIGNATURE	DATE
DRAWN BY: J STEVENS		25-04-2003
CHECKED BY: T WONG		
APPD BY: A SMITH		
APPD BY:		
CAD Ref:		
CONTRACTOR'S Ref:		



AMEY DATEL Project
 Offices
 1st Floor, Platform
 2/3
 Eastleigh Station
 Southampton Road
 Eastleigh
 Hants
 SO50 9FL

SITE/PROJECT

SOUTH WEST TRAINS CIS PROJECT

TITLE

GUILDFORD
 PLATFORMS 3 & 4
 AS BUILT

SCALE

NTS

DRG No.

SM803-75631

ISSUE

C

SHEET

2 of 5

COPYRIGHT © AMEY Rail
 All rights reserved. Neither this drawing or any of the information
 it contains may be copied or communicated to third parties
 without the written permission of the copyright holder

FINISH

This Drawing Supersedes Any Previous Drawings

WAN	
CIRCUIT ID	MXIP201537
IP ADDRESS	10.227.33.1


All Equipment tags to be prefixed with "GLD-"

"T HP ISDN"	01-483-503208	"PLATFORM 1 HP ISDN"	01-483-503211	"PLATFORM 3 HP ISDN"	01-483-503235
		"PLATFORM 5 HP ISDN"	01-483-503241	"PLATFORM 7 HP ISDN"	01-483-503249

	Equipment Cabinet		15" Cased Monitor		Loudspeaker
	Double Sided LED		15" Housed Monitor		Above Surface Cable Route
	Single Sided LED		20" TFT Display		Sub Surface Cable Route
			25" Housed Monitor		Radio Microphone Antenna
			42" Plasma Display		Radio Microphone Base Unit

LEGEND

Equipment	Dist Board	
EXSITING		
CIRCUITS		
EXTENDED		

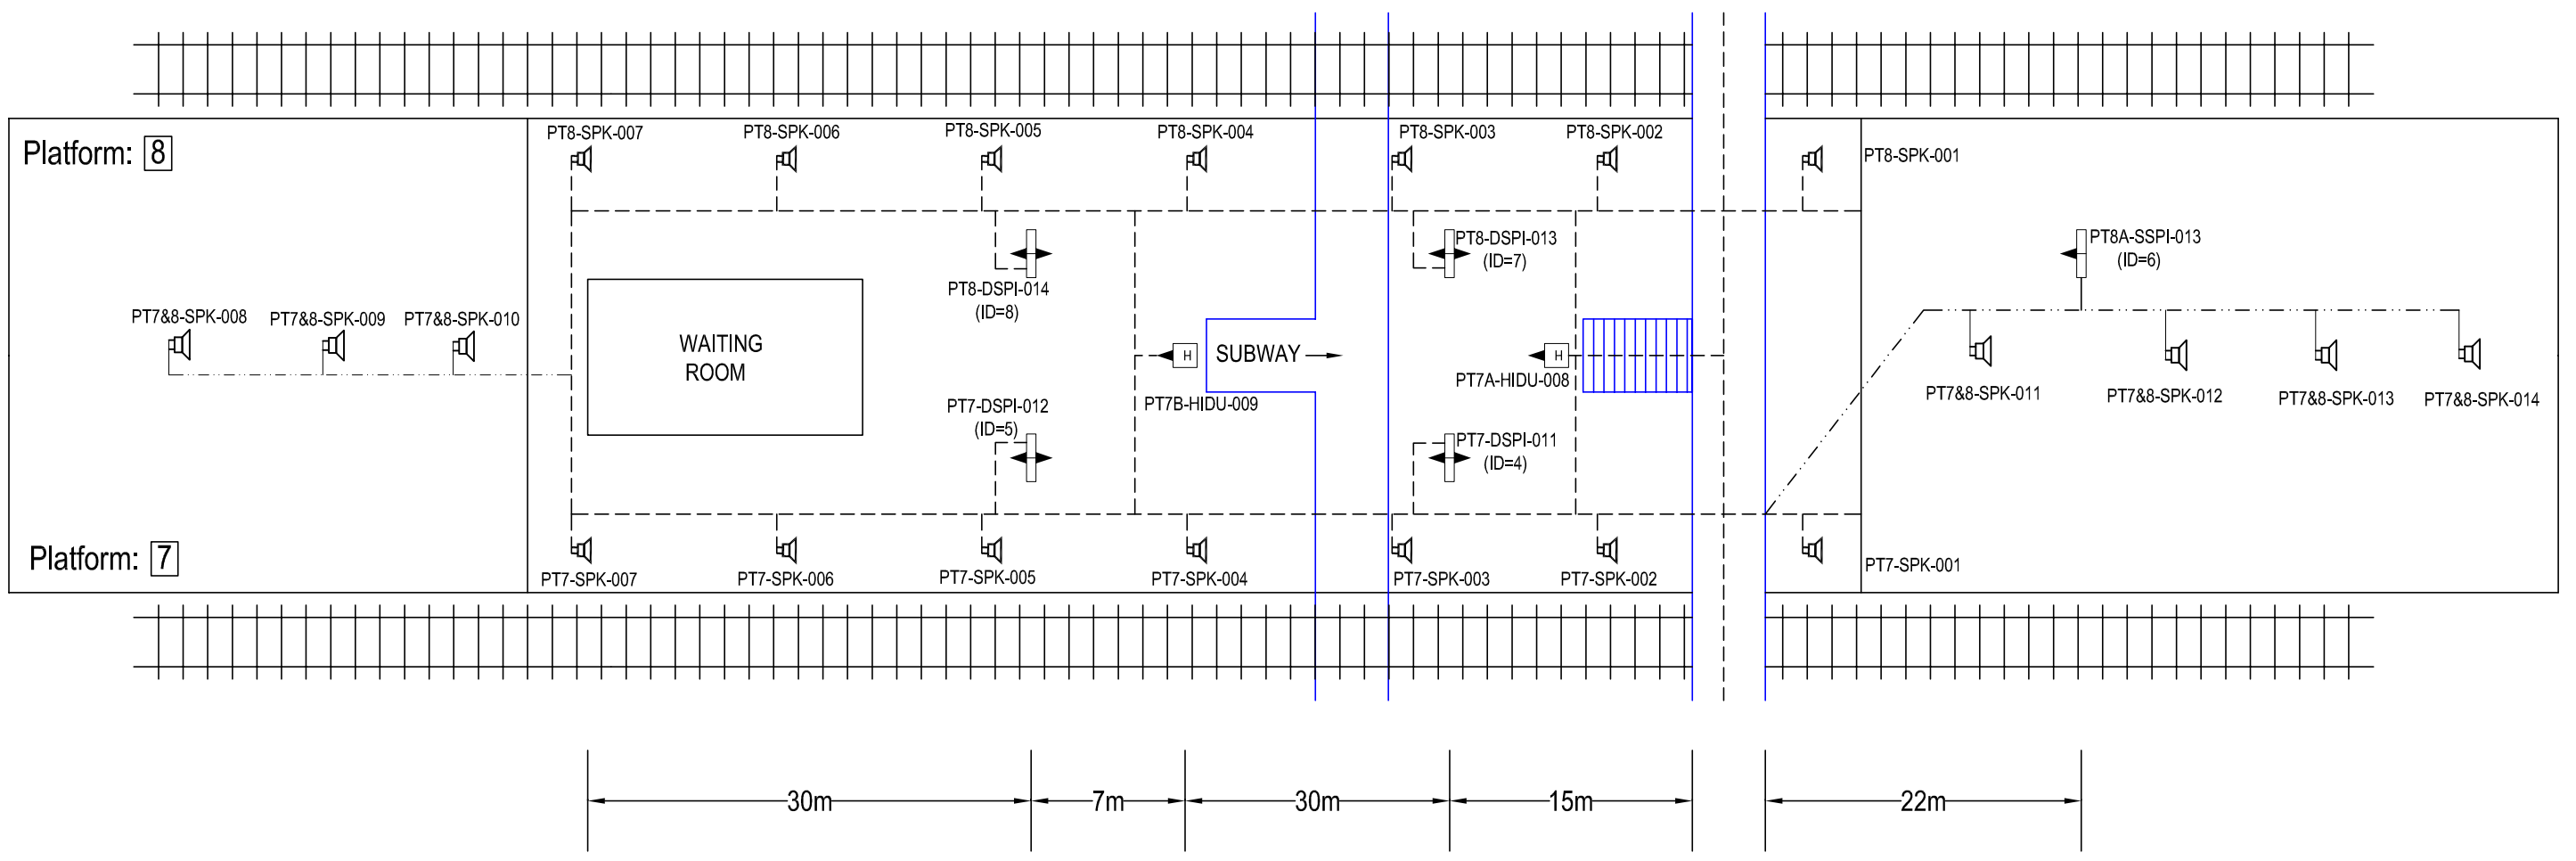

IF IN DOUBT ASK!

Date of Last Modification: 25 April 2003

This Drawing Supersedes Any Previous Drawings

FINISH

CONSTRUCTION	NAME	SIGNATURE	DATE
	J STEVENS		25-04-2003
	T WONG		
	A SMITH		

AMEY DATEL Project
 Offices
 1st Floor, Platform
 2/3
 Eastleigh Station
 Southampton Road
 Eastleigh
 Hants
 SO50 9FL

COPYRIGHT © AMEY Rail
 All rights reserved. Neither this drawing or any of the information it contains may be copied or communicated to third parties without the written permission of the copyright holder

SITE/PROJECT		SOUTH WEST TRAINS CIS PROJECT	
TITLE		GUILDFORD PLATFORM'S 7 & 8 AS BUILT	
SCALE	DRG No.	ISSUE	SHEET
NTS	SM803-75631	C	4 of 5

WAN	
CIRCUIT ID	MXIP201537
IP ADDRESS	10.227.33.1


All Equipment tags to be prefixed with "GLD-"

"T HP ISDN"	01-483-503208	"PLATFORM 5 HP ISDN"	01-483-503241
"PLATFORM 1 HP ISDN"	01-483-503211	"PLATFORM 7 HP ISDN"	01-483-503249
"PLATFORM 3 HP ISDN"	01-483-503235		

LEGEND

	Equipment Cabinet		15" Cased Monitor		Loudspeaker
	Double Sided LED		15" Housed Monitor		Above Surface Cable Route
	Single Sided LED		20" TFT Display		Sub Surface Cable Route
			25" Housed Monitor		Radio Microphone Antenna
			42" Plasma Display		Radio Microphone Base Unit

Equipment	Dist Board	
EXISTING CIRCUITS EXTENDED		

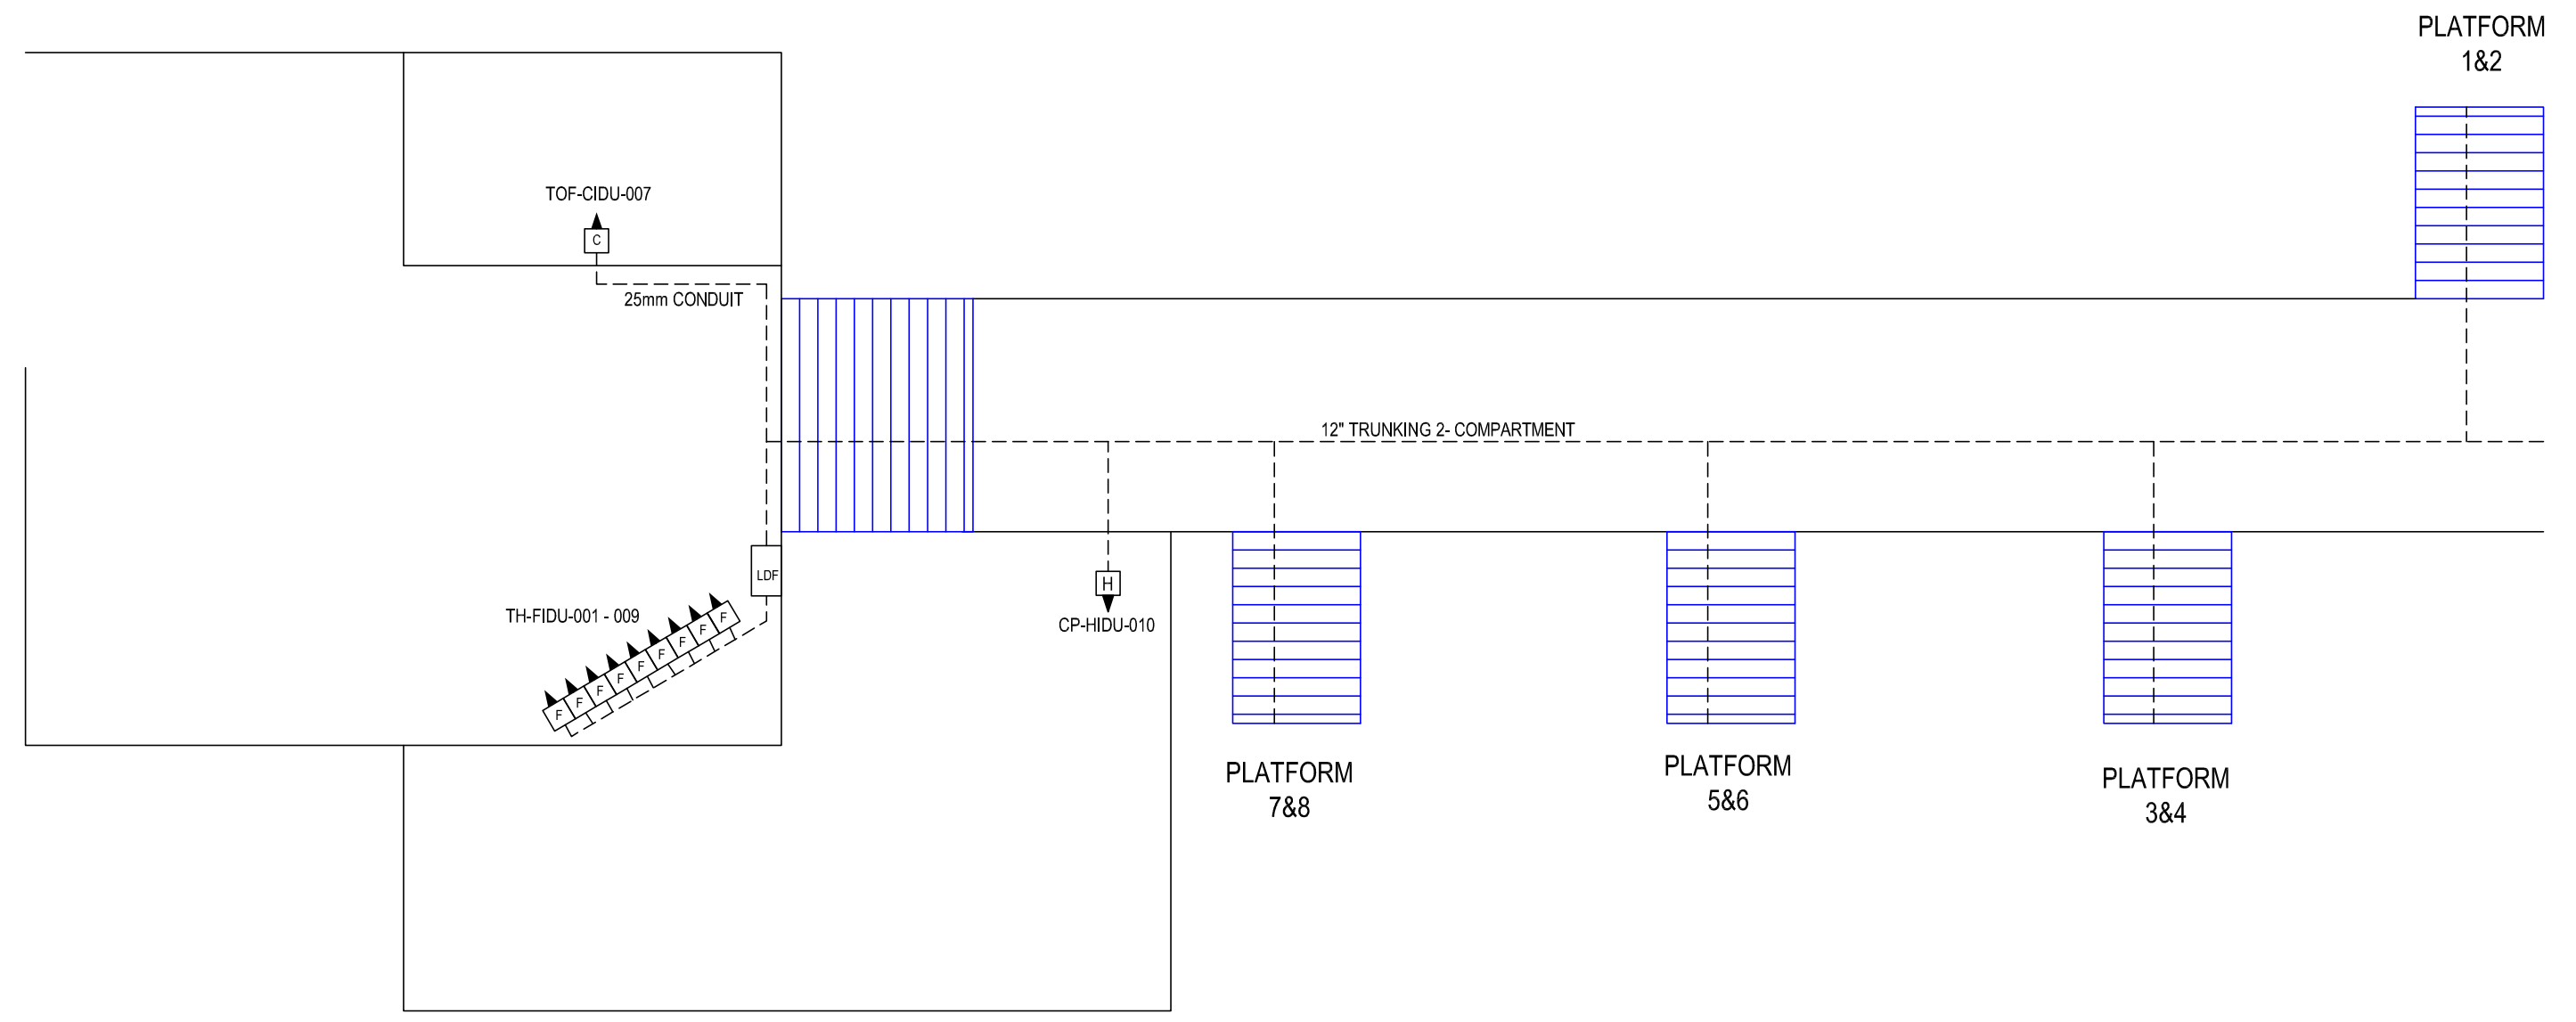

IF IN DOUBT ASK!

Date of Last Modification: 25 April 2003
This Drawing Supersedes Any Previous Drawings

CONSTRUCTION	NAME	SIGNATURE	DATE
DRAWN BY	J STEVENS		25-04-2003
CHECKED BY	T WONG		
APPD BY	A SMITH		
APPD BY			
CAD Ref:			
CONTRACTOR'S Ref:			

AMEY DATEL Project
Offices
1st Floor, Platform
2/3
Eastleigh Station
Southampton Road
Eastleigh
Hants
SO50 9FL

SITE/PROJECT		SOUTH WEST TRAINS CIS PROJECT	
TITLE		GUILDFORD PARK ROAD ENTRANCE AND FOOTBRIDGE AS BUILT	
SCALE	DRG No.	ISSUE	SHEET
NTS	SM803-75631	C	5 of 5

COPYRIGHT © AMEY Rail
All rights reserved. Neither this drawing or any of the information it contains may be copied or communicated to third parties without the written permission of the copyright holder