


DRG No. SM803-75590


WAN	
CIRCUIT ID	KXIP200498
IP ADDRESS	10.227.156.1

"PLATFORM 1 HP ISDN"
01-932-227155
"PLATFORM 2 HP ISDN"
01-932-224729

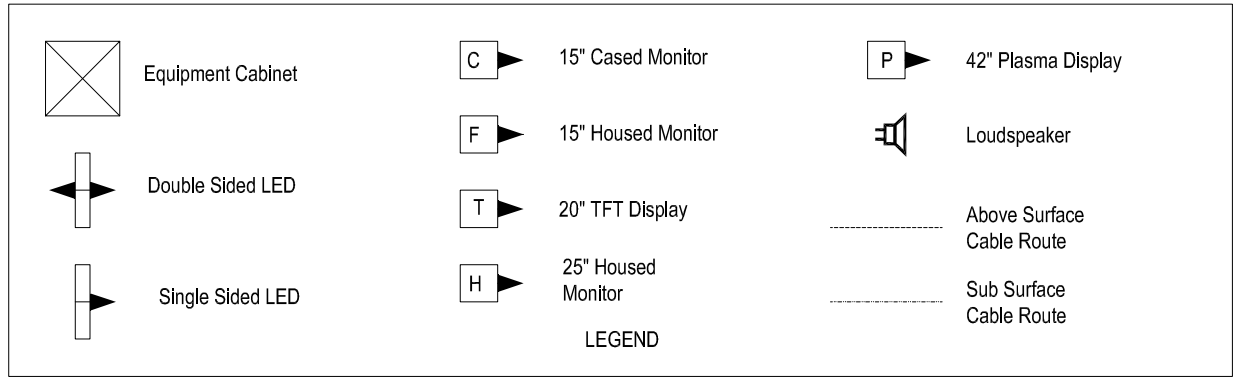

Equipment	Dist Board
PT1-DSPI-001	GP1 MCB 8
PT2-DSPI-002	CRABTREE MCB 7
TH-CIDU-001	EXISTING SPUR USED
CIS RACK	DB IN TO. MEM MCB 7

All Equipment tags to be prefixed with "HSM-"

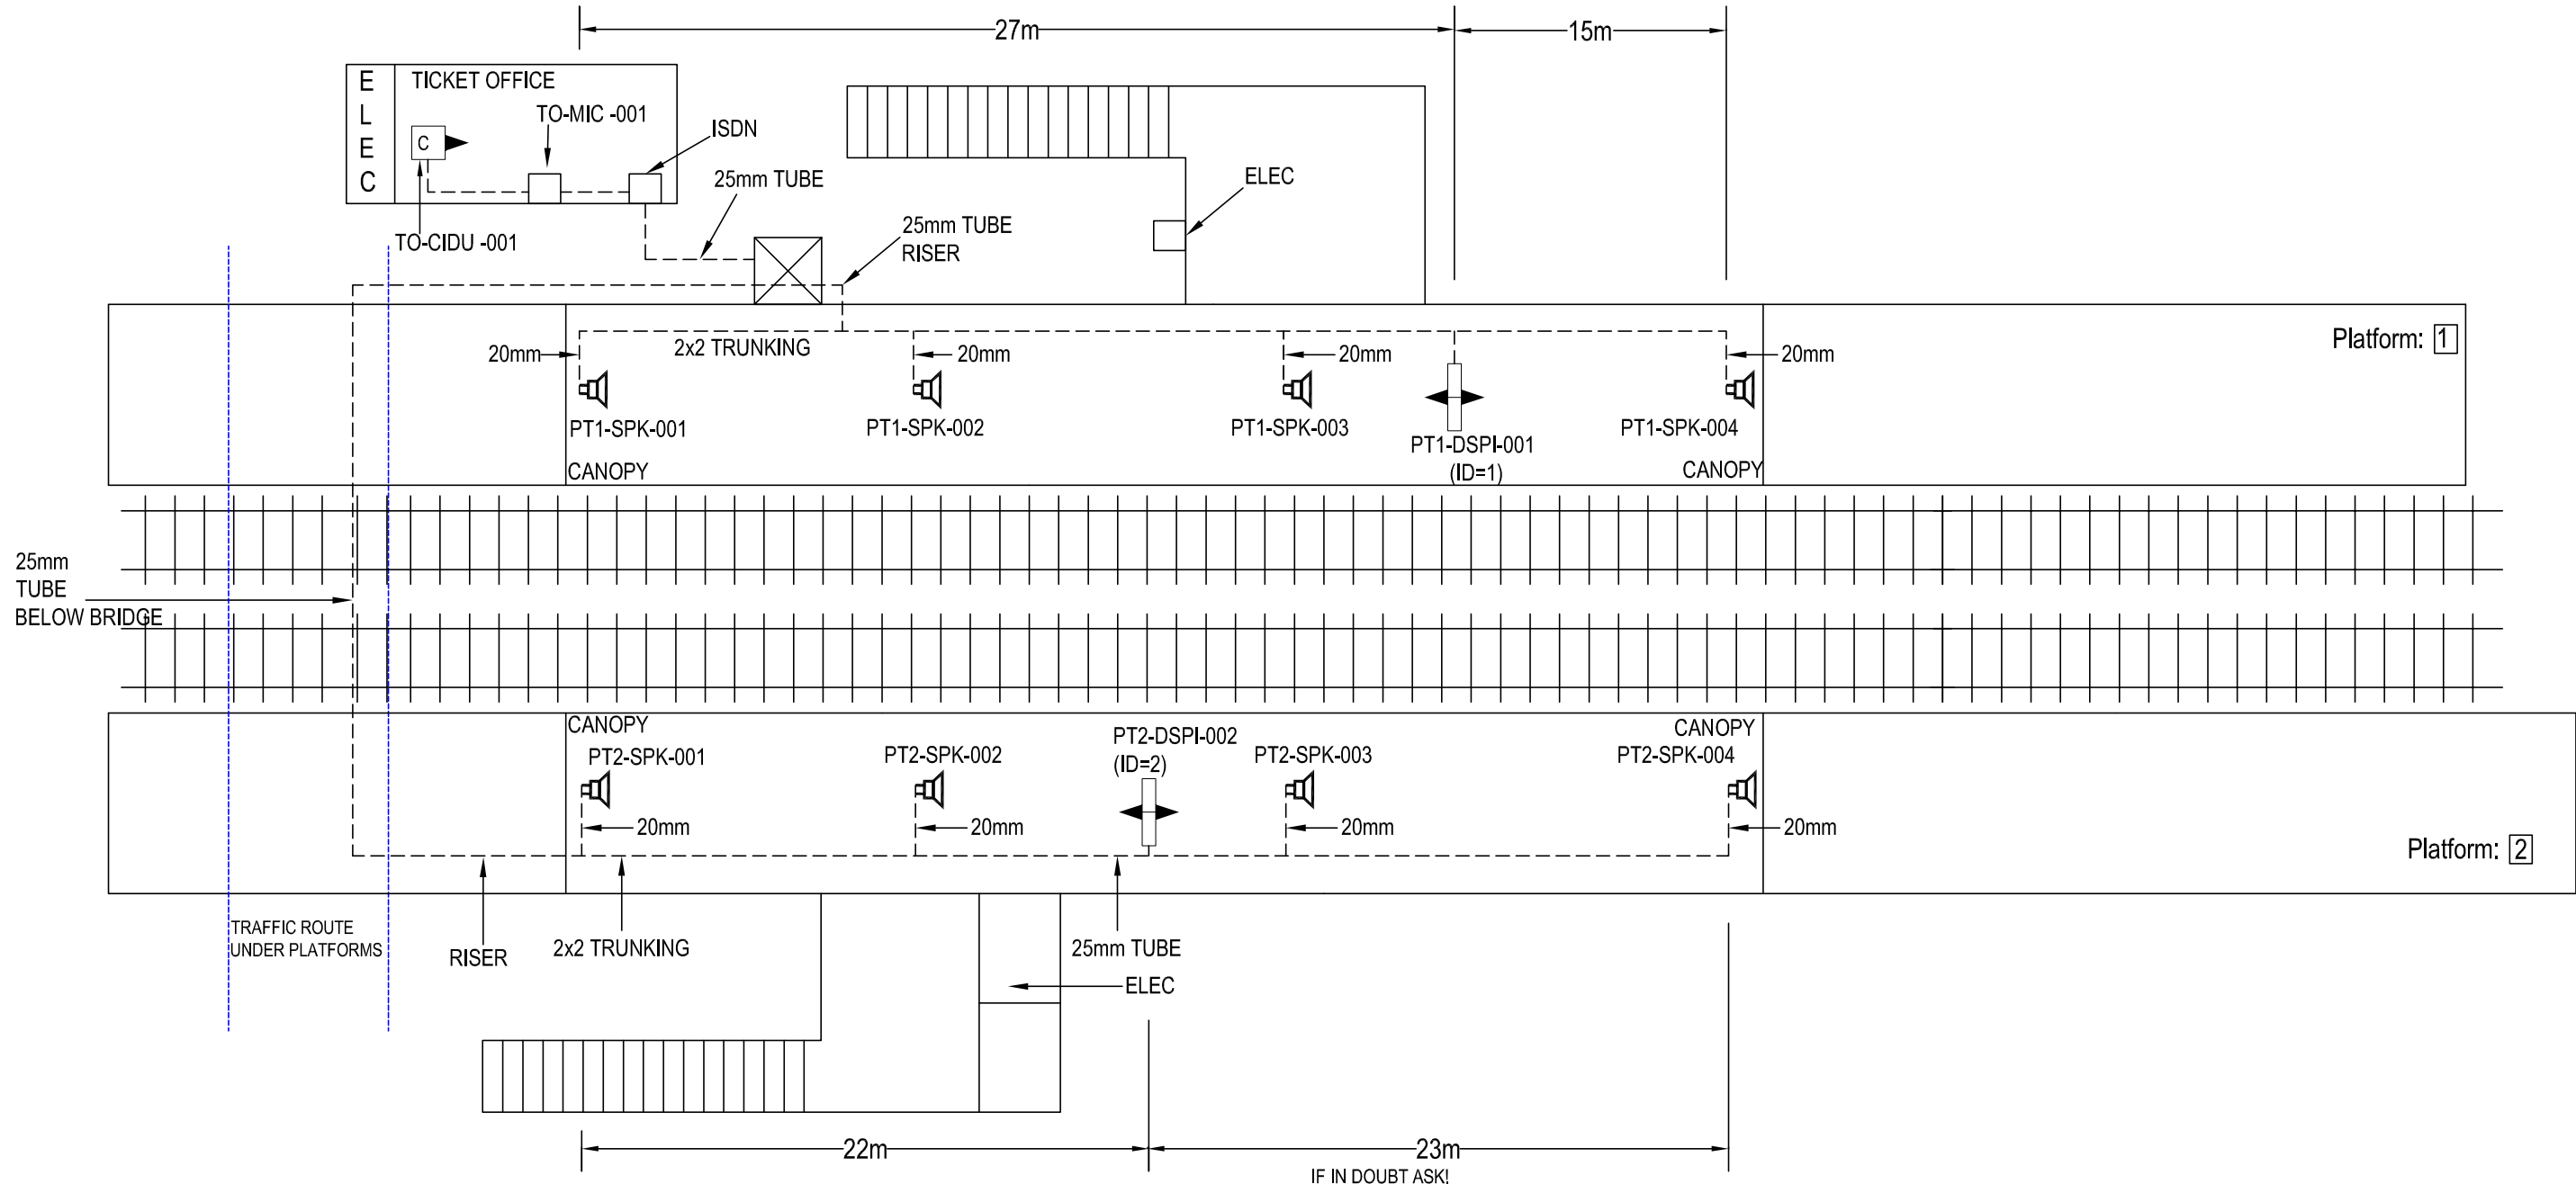

MATERIAL	CONSTRUCTION	NAME	SIGNATURE	DATE
		D GADDU		22-06-2001
		T WONG		
		A SMITH		
FINISH				
		CAD Ref:		
		CONTRACTOR'S Ref:		

AMEY DATEL Project Offices  
1st Floor, Platform 2/3  
Eastleigh Station  
Southampton Road  
Eastleigh  
Hants  
SO50 9FL

COPYRIGHT © AMEY Rail  
All rights reserved. Neither this drawing or any of the information it contains may be copied or communicated to third parties without the written permission of the copyright holder

SITE/PROJECT		SOUTH WEST TRAINS CIS PROJECT	
TITLE		HERSHAM AS BUILT	
SCALE	DRG No.	ISSUE	SHEET
NTS	SM803-75590	B	1 of 1