


DRG No.

SM803-75561


WAN	
CIRCUIT ID	KXIP200489
IP ADDRESS	10.227.152.1

"PLATFORM 1 HP ISDN"
020-8941-5085

All Equipment tags to be prefixed with "HMC-"

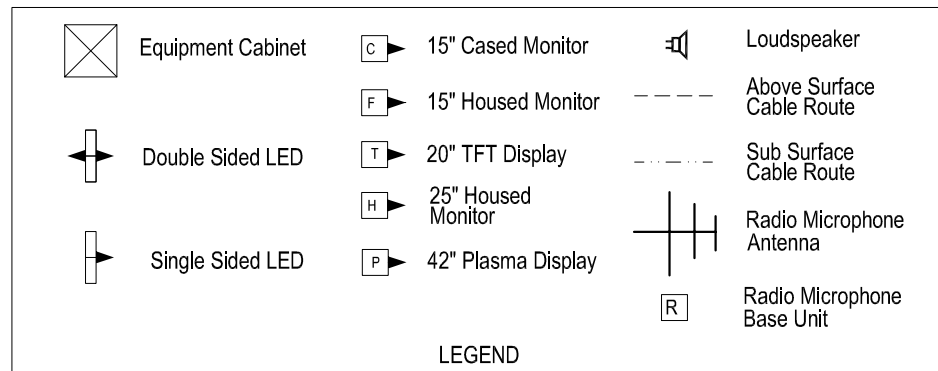

Equipment	Dist Board
IDU 001	13 WAY CRABIRGE-3
RACK	CRABIRGE-2
LED 001	CRABIRGE-1
LED 002	CRABIRGE-1

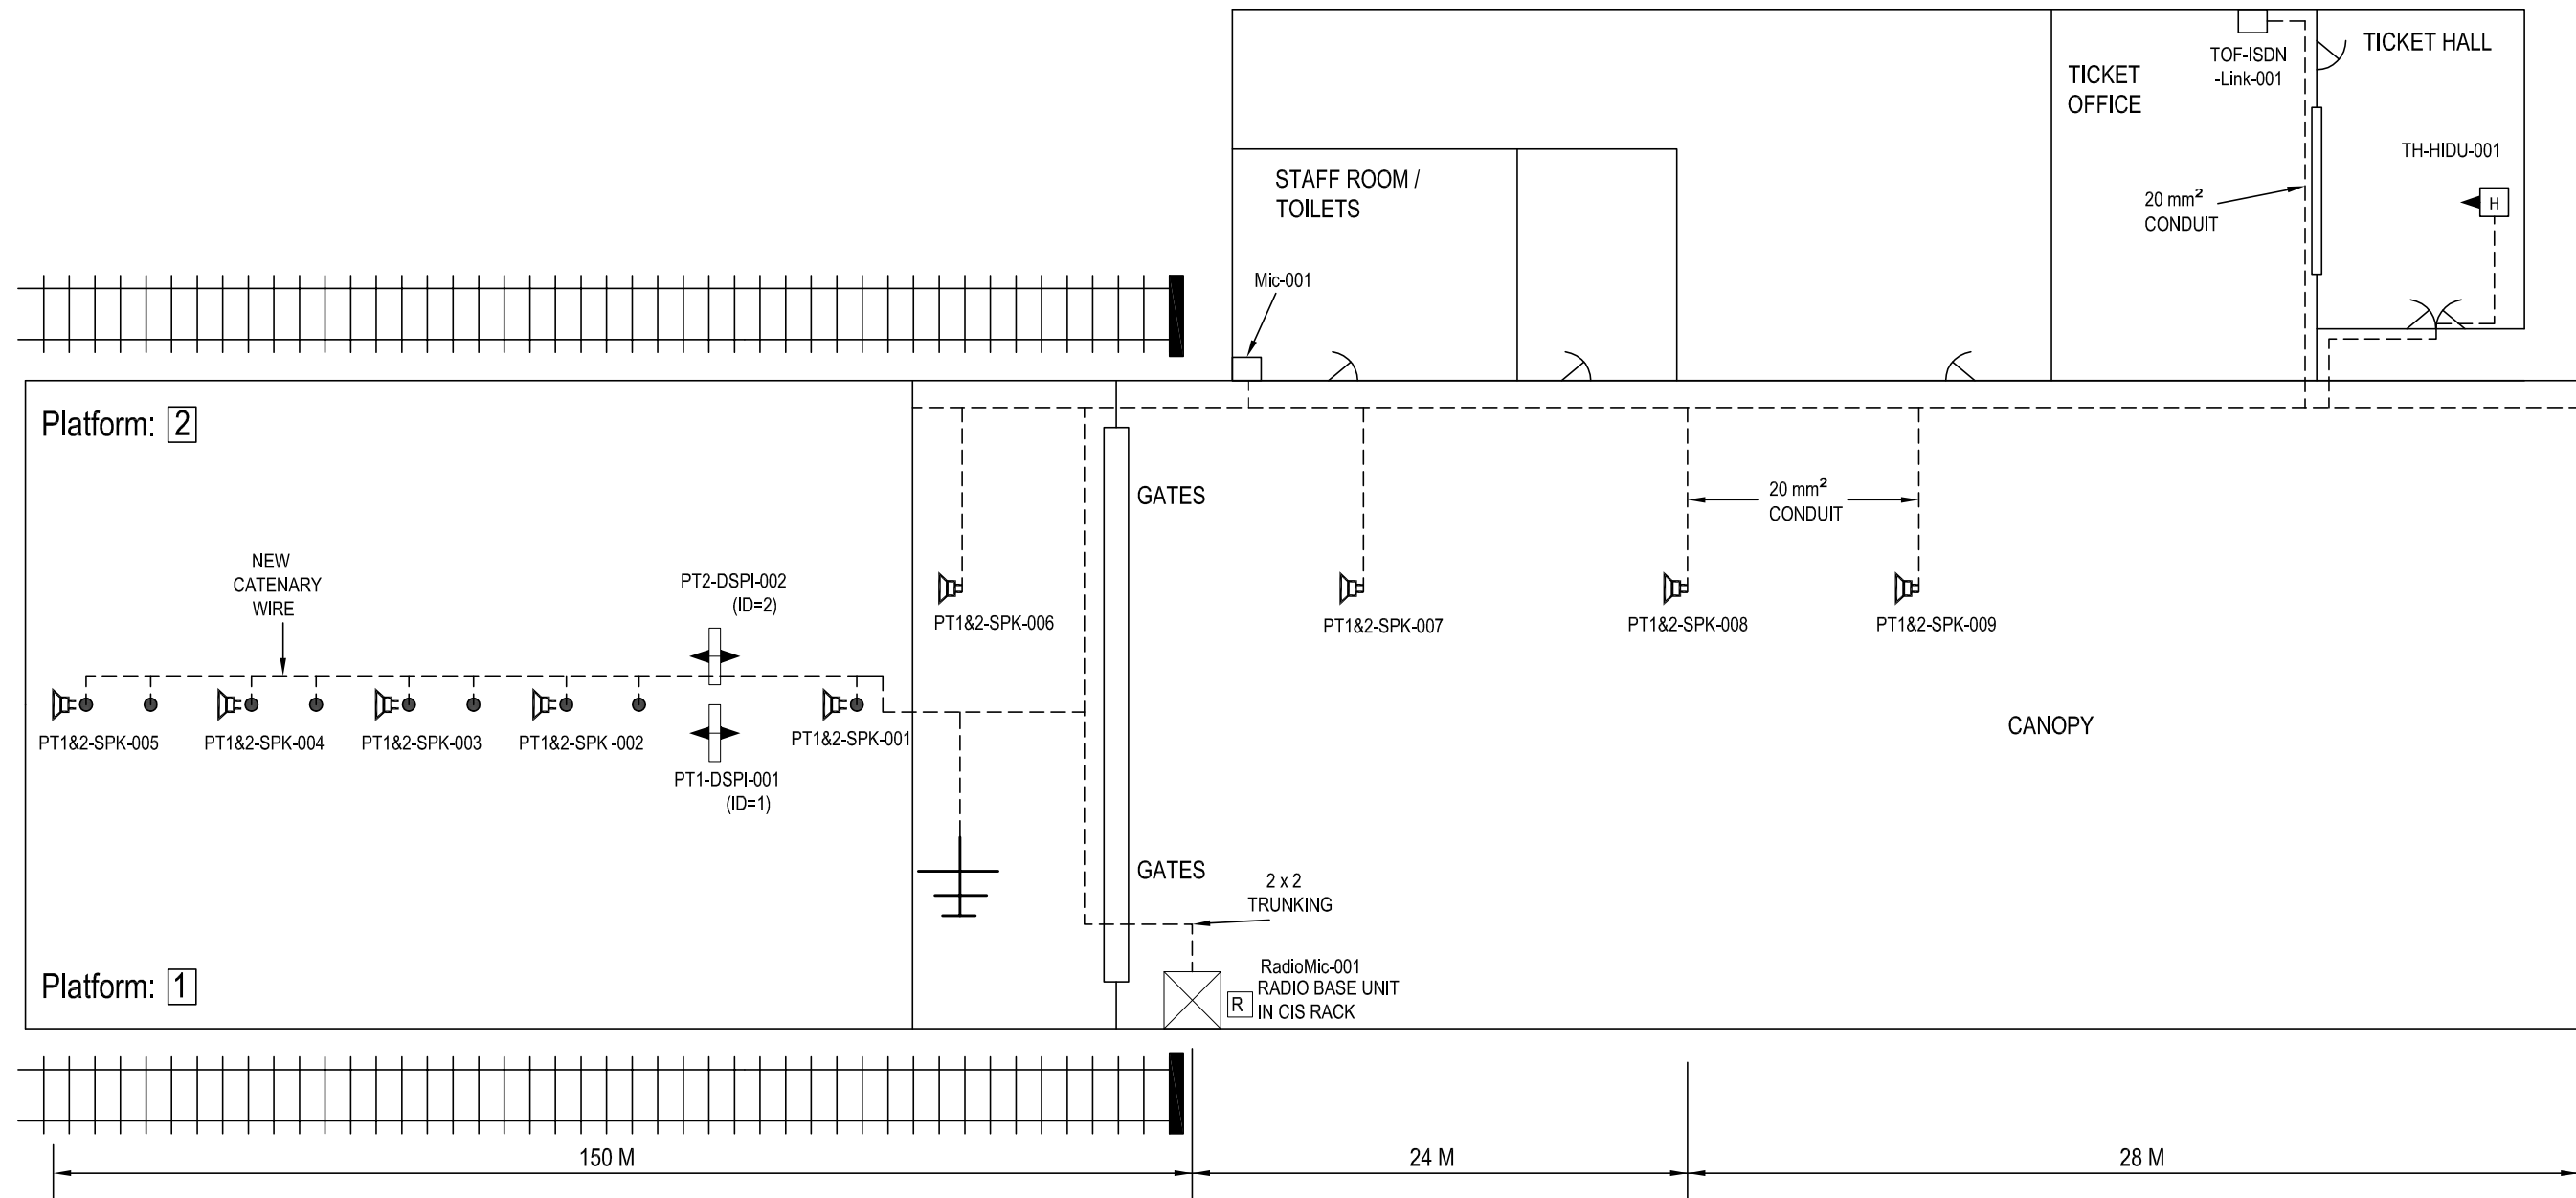

IF IN DOUBT ASK!

MATERIAL	CONSTRUCTION	NAME	SIGNATURE	DATE	 <p>AMEY DATEL Project Offices 1st Floor, Platform 2/3 Eastleigh Station Southampton Road Eastleigh Hants SO50 9FL</p>	SITE/PROJECT			
		DRAWN BY	D GADDU	17-05-2002		SOUTH WEST TRAINS CIS PROJECT			
FINISH	CONSTRUCTION	CHECKED BY	T WONG		<p>COPYRIGHT © AMEY Rail All rights reserved. Neither this drawing or any of the information it contains may be copied or communicated to third parties without the written permission of the copyright holder</p>	TITLE			
		APPD BY	A SMITH			HAMPTON COURT AS BUILT			
		APPD BY				SCALE	DRG No.	ISSUE	SHEET
		CAD Ref:				NTS	SM803-75561	B	1 of 1
CONTRACTOR'S Ref:									